

**Fall Creek Regional Waste District**  
9378 S 650 W, P.O. Box 59, Pendleton, IN 46064  
765-778-7544

#7664

**Agreement for Sanitary Sewer Service**

This Agreement made and entered into this 28 day of March, 2022 between Fall Creek Regional Waste District ("District") and Lennar Homes ("Applicant") regarding the provision of sanitary sewer service, and the assignment of capacity in and connection to, the District's facilities for the premises located at Springbrook Lot 245.

Street Address: 9355 Casey Rd.

**Now therefore**, the parties, in consideration of the mutual promises set out in this Agreement, the receipt and sufficiency of which is hereby acknowledged, agree as follows:

1. The Applicant agrees that all workmanship and materials shall conform to all District ordinances and the District's construction standards. District must accept and approve all work and materials before backfilling and final connection is made to the sewer mains. Any violation of this provision will cause all lines and appurtenances in violation to be removed and replaced at the Applicant's expense.
2. The District shall have the right to enter upon the Applicant's premises at all reasonable times to inspect, repair, or replace any equipment used in connection with the District's service or which has an impact on said service.
3. The Applicant shall be responsible for all monthly user rates, capacity charges, and tap fees. The failure to pay any rate charge or fee may result in a lien against the property and/or the termination of service to the property, the cost of which will be borne by Applicant, including, but not limited to, all attorney's fees and collection costs.
4. The District shall not be responsible for any damages as a result of any failure to supply service unless said damages are due to default, neglect or culpability on the part of the District.
5. If there is an available sanitary sewer within three hundred (300) feet of the property line, the property owner shall be required to connect to the District's sanitary sewer system.
6. The Applicant and District agree that the provision of sanitary sewer service touches and concerns the property and the terms of this Agreement bind the District and Applicant and their heirs, executors, administrators, personal representatives, successors, agents, attorneys, assigns, designees, and transferees.

The parties hereto have read and fully understand the above provisions and agree to comply with said provisions.

FALL CREEK REGIONAL WASTE DISTRICT  
[Signature]  
Signature

APPLICANT

[Signature]  
Signature

STATE OF INDIANA     )  
                                      ) SS:  
COUNTY OF MADISON )

SUBSCRIBED and sworn to before me this \_\_\_\_ day of \_\_\_\_\_, 20\_\_

My Commission Expires:

Signature \_\_\_\_\_

Printed \_\_\_\_\_

Notary Public

Resident of \_\_\_\_\_ County

\*\*\*\*\*

Inspector Dow Date Inspected 5-12-22 Approved ✓ Rejected \_\_\_\_\_

Reason for Rejection \_\_\_\_\_

Date Reinspected \_\_\_\_\_ Approved \_\_\_\_\_ Rejected \_\_\_\_\_

Notes:

Size Pipe 6" Type Pipe PVC 35

Basement Yes \_\_\_\_\_ No \_\_\_\_\_

Sump Pump Yes \_\_\_\_\_ No \_\_\_\_\_


Downspout to Ground Yes \_\_\_\_\_ No \_\_\_\_\_

Septic Tank Pumped &amp; Filled Yes \_\_\_\_\_ No \_\_\_\_\_

Contractor BROWN EX.

Special Conditions \_\_\_\_\_

Existing Home \_\_\_\_\_

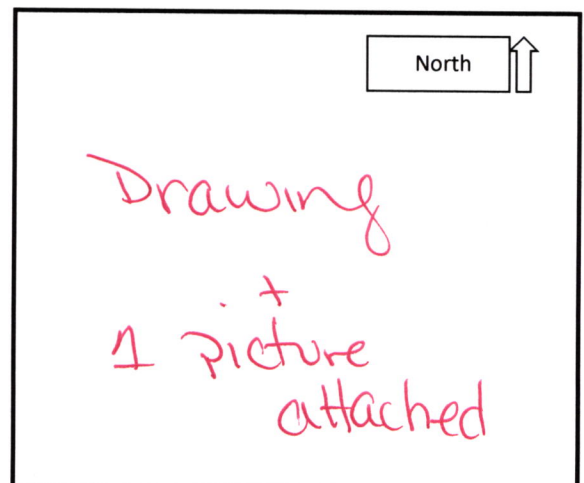New Construction ✓



# STOEPPELWERTH

ALWAYS ON


7965 East 106th Street, Fishers, IN 46038-2505  
phone: 317.849.5935 fax: 317.849.5942

JOB ID SPRINGBK5.245

CONTROL# 102973 LEN

PARCEL#48-15-28-401-001.035-014

9355 CASEY ROAD  
PENDLETON, IN 46064

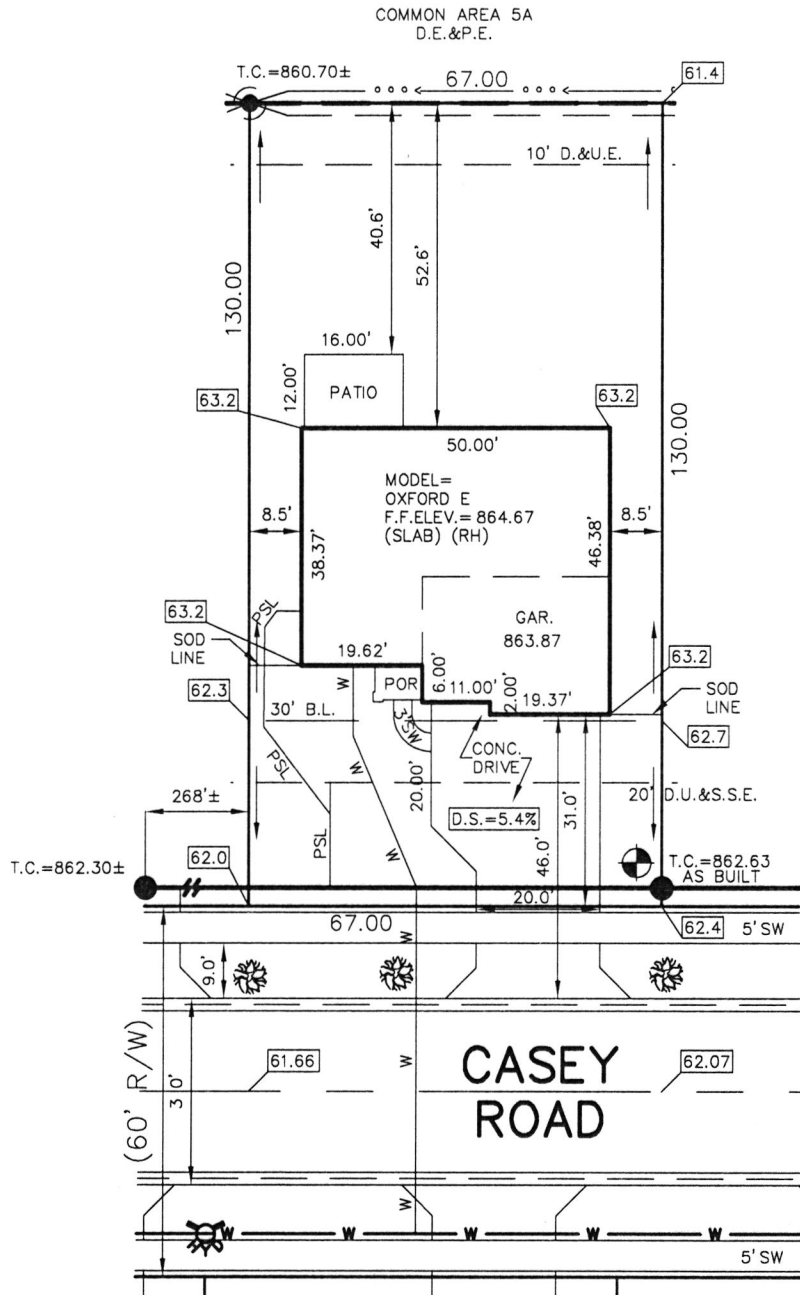

1" = 30'

LOT AREA: 8,710 Sq. Ft.

M.F.F.E. = 863.3

M.F.P.G. = 862.7

LEGEND:

- XX.X PROPOSED GRADE PER PLAN  
XX.XAB AS BUILT GRADE
- S.S.D. SUB-SURFACE DRAIN  
S.S. SANITARY SEWER  
6" AS BUILT SANITARY LATERAL  
PSL 6" PROPOSED SANITARY LATERAL  
W STORM SEWER  
3/4" WATER CONNECTION  
W WATER MAIN  
SW SWALE
- SANITARY MANHOLE  
STORM MANHOLE  
CURB INLET  
FIRE HYDRANT  
STREET TREE
- D.U.&S.S.E. DRAINAGE, UTILITY & SANITARY SEWER EASEMENT  
D.E. DRAINAGE EASEMENT  
D.&U.E. DRAINAGE & UTILITY EASEMENT  
B.L. BUILDING LINE  
P.E. PEDESTRIAN EASEMENT  
M.F.F.E. MINIMUM FINISHED FLOOR ELEVATION  
M.F.P.G. MINIMUM FLOOD PROTECTION GRADE

CONTRACTOR SHALL CUT 5' OFF OF LATERAL AND BEGIN FROM THAT POINT AND CONNECT TO HOUSE FOLLOWING PLOT PLAN.

BENCHMARK  
TOP OF CASTING = 862.63

LOT 245  
SPRINGBROOK  
SECTION 5

INST. #2021R019149

ZONING: R3

5' MINIMUM SIDE YARD  
30' MINIMUM FRONT YARD  
15' MINIMUM REAR YARD

ALL UNDERGROUND SEWERS AND UTILITIES SHOWN ARE PLOTTED BY SCALE FROM DESIGN PLANS FURNISHED BY ENGINEER. THE ACTUAL FIELD LOCATION MAY VARY.

SOD:	211±	Sq.	Yd.
SEED:	4,054±	Sq.	Ft.
CONC. DRIVEWAY:	819±	Sq.	Ft.
PRIVATE WALK:	29±	Sq.	Ft.
PUBLIC WALK:	235±	Sq.	Ft.
APRON:	305±	Sq.	Ft.
ADDITIONAL SOD:	451±	Sq.	Yd.
HANDICAP RAMPS:	0		

SIGNATURE:

DATE:

SIGNATURE REPRESENTS CONFIRMATION OF RECEIPT OF PLOT PLAN BY CUSTOMER




David J. Stoeppelwerth

NOTE: THIS DRAWING IS NOT INTENDED TO BE REPRESENTED AS A RETRACEMENT OR ORIGINAL BOUNDARY SURVEY, A ROUTE SURVEY OR A SURVEYOR LOCATION REPORT.

03/23/22 JRS





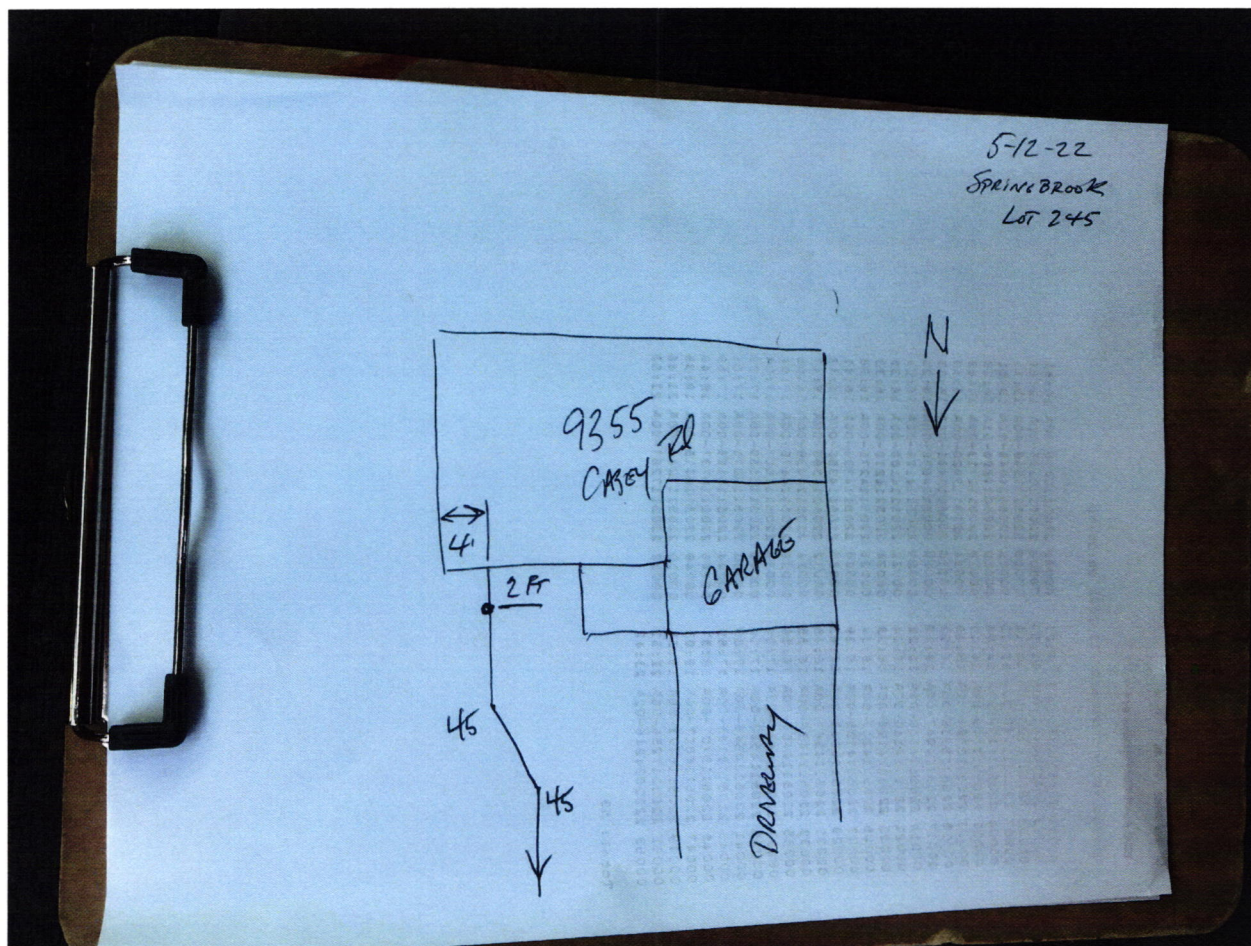





Lennar Corporation  
Lennar Homes of Indiana, LLC  
Indianapolis Division  
11555 N Meridian St Ste 400  
Carmle, IN 46032

PAY FALL CREEK REGIONAL WASTE DISTRICT  
TO THE PO BOX 59  
ORDER OF: PENDLETON, IN 46064

JPMorgan Chase Bank, N.A.  
Chicago, IL

CHECK  
NUMBER 1777916


70-2322  
719

March 24, 2022

\*\*\* VOID AFTER 180 DAYS \*\*\*

CHECK AMOUNT

\$760.00

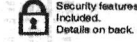

EXACTLY \*\*\*\*\*760 DOLLARS AND 00 CENTS

Authorized Signature

Rec# 012190