


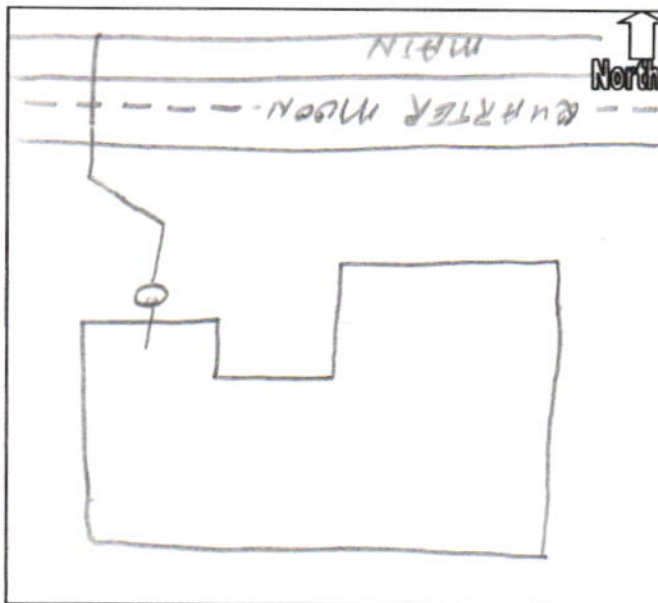

34294

C.P. MORGAN COMMUNITIES, LP
CONSTRUCTION ACCOUNT

BANK ONE, NA
INDIANAPOLIS, INDIANA 46277
20-1-740

9/13/2004

PAY TO THE ORDER OF Fall Creek Regional Waste Dist


\$*****475.00

Four Hundred Seventy-Five and no/100***** DOLLARS

Fall Creek Regional Waste Dist

MEMO 210368

⑈034294⑈ ⑈074000010⑈

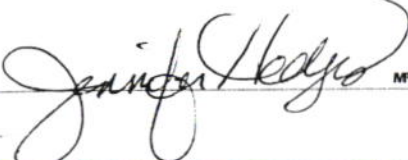 MP