

4992

9378 S 650 WEST, P.O. BOX 59, PENDLETON, IN 46064  
765-778-7544

21-07975.00

This Agreement made and entered into this 3rd day of October, 2003, between FALL CREEK REGIONAL WASTE DISTRICT ("District") and C P Morgan ("Applicant") regarding the provision of sanitary sewer service, and the assignment of capacity in and connection to, the District's facilities for the premises located at Lot # 374 Summerlake.

9416 W. Constellation Dr.

- The parties hereto have read and fully understand the above provisions and agree to comply with said provisions.

APPLICANT Laboral Green  
Signature


SUBSCRIBED and sworn to before me this 3<sup>rd</sup> day of October, 2003

Signature Jan E. Carey  
Printed Jan E. Carey  
Notary Public  
Resident of Madison County

REASON FOR REJECTION

DATE REINSPECTED                  APPROVED                  REJECTED

NOTES:  
 SIZE PIPE 6 TYPE PIPE PVC  
 BASEMENT YES NO X  
 SUMP PUMP YES NO X  
 DOWNSPOUT TO GROUND YES X NO  
 SEPTIC TANK PUMPED & FILLED YES NO X  
 CONTRACTOR Buttz  
 SPECIAL CONDITIONS \_\_\_\_\_  
 EXISTING HOME \_\_\_\_\_  
 NEW CONSTRUCTION X

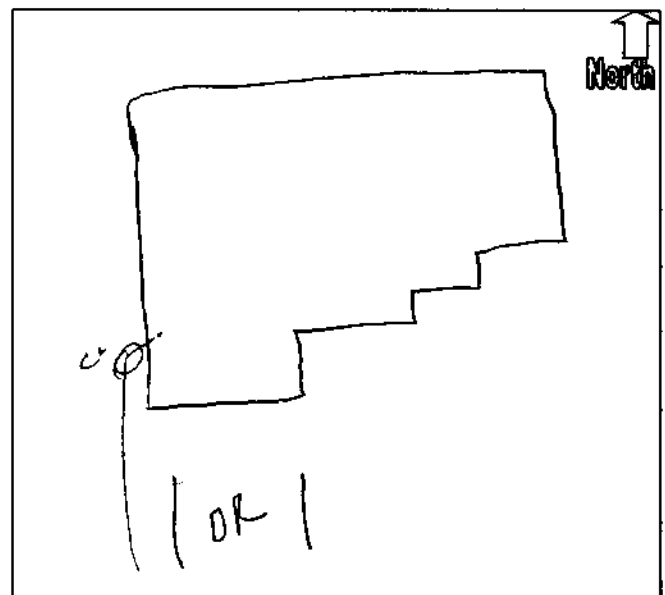

29786

C.P. MORGAN COMMUNITIES, LP  
CONSTRUCTION ACCOUNT

BANK ONE, NA  
INDIANAPOLIS, INDIANA 46277  
20-1-740

10/3/2003

PAY TO THE ORDER OF Fall Creek Regional Waste Dist

\*\*\*\*\*475.00

Four Hundred Seventy-Five and no/100\*\*\*\*\*

DOLLARS

MEMO 210374102 SU 374 Ryan Kramer  
"029786" 10740000106

*Jonny L. Lewis*