

② 7-15640-02



FALL CREEK REGIONAL WASTE DISTRICT

Box 44, Pendleton, Indiana 46064

1300.00

~~3-0715-208.00~~ ⁶⁵⁷

Nº 000066

APPLICATION FOR SEWER PERMIT

Permit No. _____ Date 8-2-85

Permit Void 90 days from Date of Issuance

Owner Name Alfred Benick

Property Address R 2 Box 325 B Broadway

Lot # _____ P.O. Box ② 928 S. Broadway 942

Town Pendleton, IN Zip Code 46064

Phone 778-2840 Water Meter no

\$ 150.00 Tap on Fee Paid

\$ 25.00 Inspection fee paid

Application is hereby made for connection to the Fall Creek Regional Waste District Sewer System for the above listed property - Permit Type: Residential ☒, Commercial _____, Industrial _____, or Governmental/Institutional _____. User Information _____.

All workmanship and materials shall conform to the standards of the District Ordinance as described in Ordinance 84-2 and 84-3 as amended. Acceptance and approval must be made by the District inspector or his duly authorized representative before backfilling and final connection is made to the main sewer lines. Any violation of applicable regulations will cause all lines and appurtenances in violation to be removed and replaced at the owners expense.

The Fall Creek Regional Waste District is responsible for the inspection, approval of materials, and installation techniques only. All costs for materials and installation and any liabilities resulting from same is the sole responsibility of the property owner.

I have read and fully understand the above provisions and agree to comply by said provisions.

Alfred Benick

APPLICANT(S) SIGNATURE

INSPECTOR Ben

Date inspected 8-9-85 Approved ☒ Rejected _____

Reason for rejection _____

Date reinspected _____ Approved _____ Rejected _____

Notes:

Size Pipe 6"

Type Pipe PVC

Basement Yes _____ No ☒


Sump Pump Yes _____ No ☒

Downspout to Ground Yes ☒ No _____

Septic Tank Pumped & filled Yes ☒ No _____

Contractor FLAT FORD

Special Conditions _____

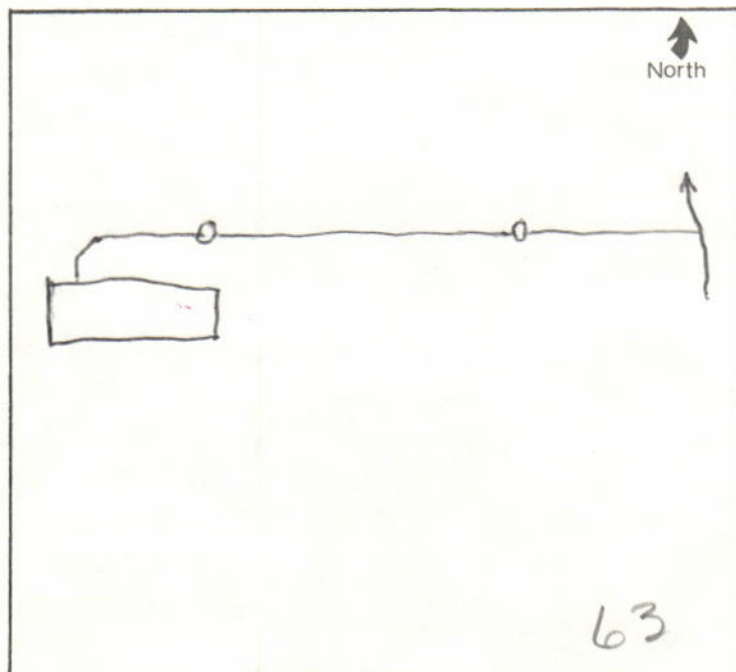



FALL CREEK REGIONAL WASTE DISTRICT

P.O. Box 59 • 9378 S. 650 West • Pendleton, Indiana 46064-0059 • (765) 778-7544

August 14, 1997

Mr. Alfred Renicker
950 S. Broadway
Pendleton, IN 46064

RE: 942 S. Broadway
Pendleton, IN 46064
Acct. # 1300.00

Dear Mr. Renicker:

We have visited your property at 942 S. Broadway, Pendleton and have deemed it unlivable in its present state.

As you previously discussed with Mrs. Teresa Hutton, Office Manager, the account will be removed from billing. At such time as you make the trailer livable or you replace it with another home, there will be a \$100 reconnect fee. It will be your responsibility to let us know when this happens.

If you sale this property, you should convey this information to the new owners as they will then be responsible for the the reconnect fee.

Please let me know if you have questions.

Sincerely,


J.F. Rowlett
Office Manager

JFR/tkh