


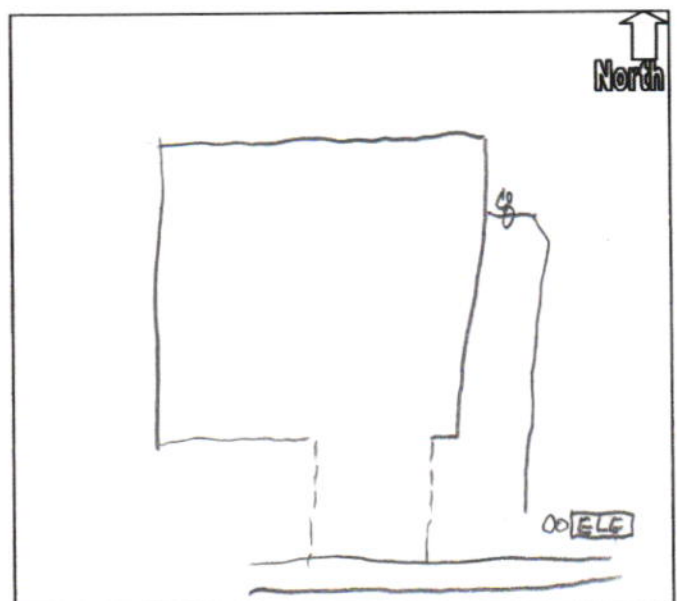

31627

C.P. MORGAN COMMUNITIES, LP
CONSTRUCTION ACCOUNT

BANK ONE, NA
INDIANAPOLIS, INDIANA 46277
20-1-740

3/31/2004

PAY TO THE ORDER OF Fall Creek Regional Waste Dist

*****475.00
\$

Four Hundred Seventy-Five and no/100*****
DOLLARS

MEMO 210463102 SU 463 John Matfield

⑈031627⑈ ⑈074000010⑈

 MP

Details on back.
Security Features Included.