


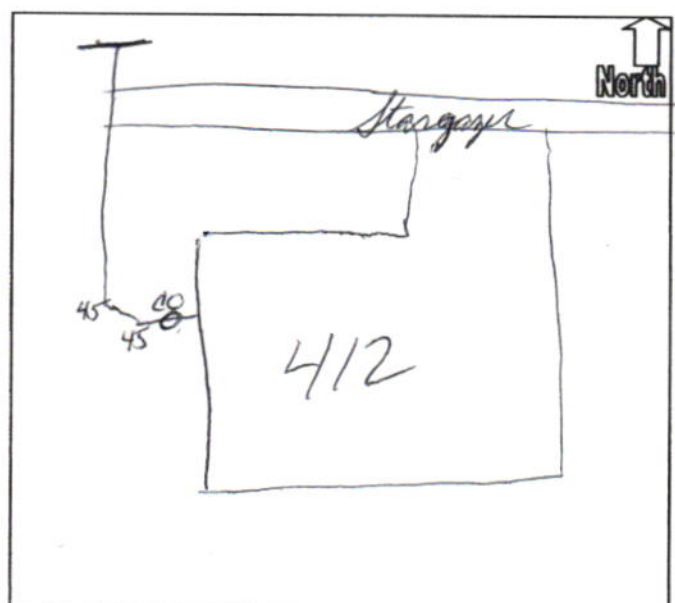

31202

C.P. MORGAN COMMUNITIES, LP  
CONSTRUCTION ACCOUNT

BANK ONE, NA  
INDIANAPOLIS, INDIANA 46277  
20-1-740

2/24/2004

PAY TO THE ORDER OF Fall Creek Regional Waste Dist

\*\*\*\*\*475.00


\$

Four Hundred Seventy-Five and no/100\*\*\*\*\*

DOLLARS

MEMO 210412102 SU 412

Montie Manning

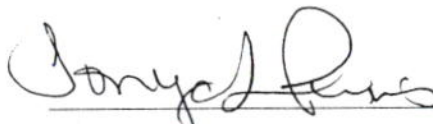

MP

031202

Details on back  
Security Features Included