


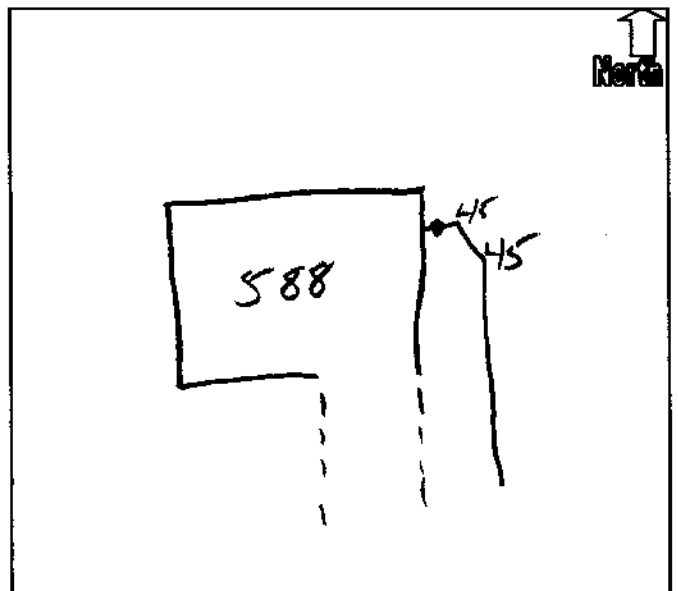

39534

C.P. MORGAN COMMUNITIES, LP
CONSTRUCTION ACCOUNT

JPMORGAN CHASE BANK, N.A.
INDIANAPOLIS, INDIANA 46277
20-1-740

11/9/05

PAY TO THE
ORDER OF

Fall Creek Regional Waste Dist

\$475.00

four hundred seventy five + ⁰⁰/₁₀₀

DOLLARS

MEMO 54588

[Signature]

⑈039534⑈ ⑆074000010⑆