


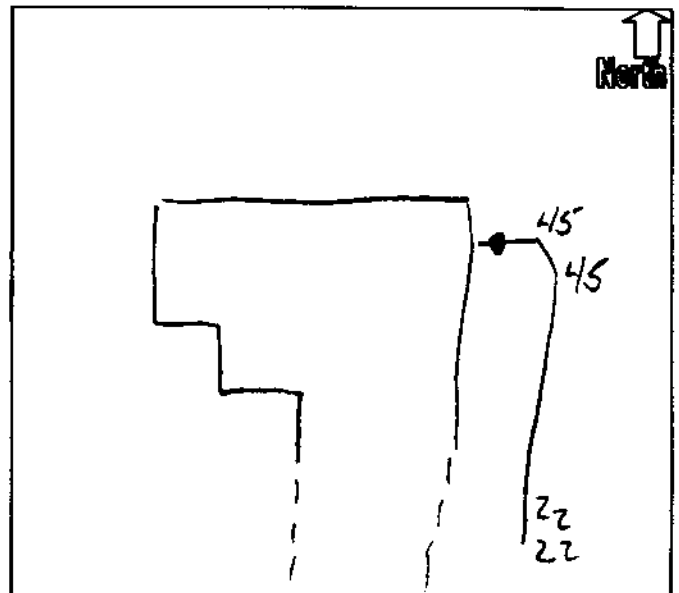

40762

C.P. MORGAN COMMUNITIES, LP
CONSTRUCTION ACCOUNT

JPMORGAN CHASE BANK, N.A.
INDIANAPOLIS, INDIANA 46277
20-1-740

4/26/2006

Fall Creek Regional Waste Dist

***1,425.00

PAY TO THE
ORDER OF

~~One Thousand Four Hundred Twenty-Five and no/100~~*****\$*****

~~Fall Creek Regional Waste Dist~~

DOLLARS

MEMO su 828, 830, 831



⑈040762⑈ ⑆074000010⑆