


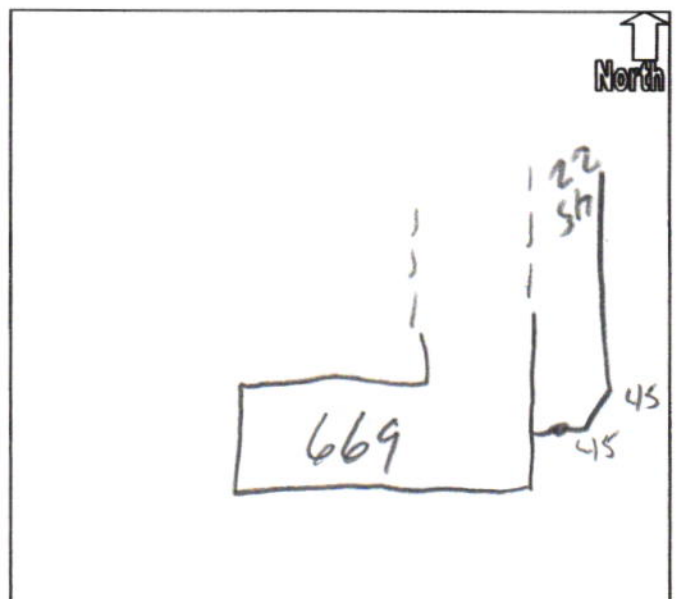

39307

C.P. MORGAN COMMUNITIES, LP
CONSTRUCTION ACCOUNT

JPMORGAN CHASE BANK, N.A.
INDIANAPOLIS, INDIANA 46277
20-1-740

10/18/05

PAY TO THE
ORDER OF

Fall Creek Regional Waste Des

\$ 475.00

four hundred seventy five + 00/100

DOLLARS

MEMO

[Signature]

MP

⑈039307⑈ ⑆074000010⑆