


№ 5891

765-778-7544

This Agreement made and entered into this 30 day of November, 2006, between FALL CREEK REGIONAL WASTE DISTRICT ("District") and OP Morgan ("Applicant") regarding the provision of sanitary sewer service, and the assignment of capacity in, and connection to, the District's facilities for the premises located at SL Lot 805

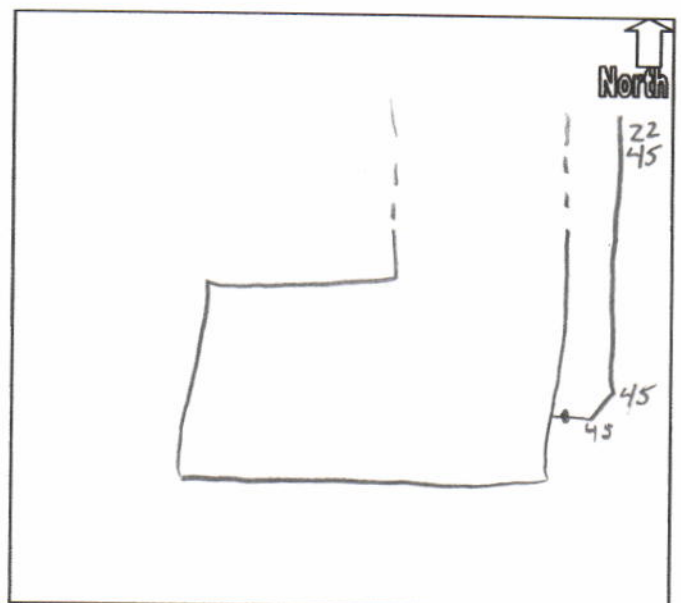

39696

C.P. MORGAN COMMUNITIES, LP
CONSTRUCTION ACCOUNT

JPMORGAN CHASE BANK, N.A.
INDIANAPOLIS, INDIANA 46277
20-1-740

11/30/2005

PAY TO THE ORDER OF Fall Creek Regional Waste Dist

***2,850.00


Two Thousand Eight Hundred Fifty and no/100*****

\$

DOLLARS

Fall Creek Regional Waste Dist

MEMO SU 586,805,866,807,808,809

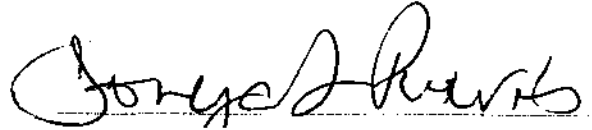

⑈039696⑈ ⑆074000010⑆