

# FALL CREEK REGIONAL WASTE DISTRICT

9378 S 650 WEST, P.O. BOX 59, PENDLETON, IN 46064  
765-778-7544

No 5861

21-08915.00

## AGREEMENT FOR SANITARY SEWER SERVICE

This Agreement made and entered into this 31st day of October, 2005, between FALL CREEK REGIONAL WASTE DISTRICT ("District") and CP Morgan ("Applicant") regarding the provision of sanitary sewer service, and the assignment of capacity in, and connection to, the District's facilities for the premises located at 374 Lot 708 9714 W Lantern Lane

NOW THEREFORE, the parties, in consideration of the mutual promises set out in this Agreement, the receipt and sufficiency of which is hereby acknowledged, agree as follows:

1. The Applicant agrees that all workmanship and materials shall conform to all District ordinances and the District's construction standards. District must accept and approve all work and materials before backfilling and final connection is made to the sewer mains. Any violation of this provision will cause all lines and appurtenances in violation to be removed and replaced at the Applicant's expense.
2. The District shall have the right to enter upon the Applicant's premises at all reasonable times to inspect, repair, or replace any equipment used in connection with the District's service or which has an impact on said service.
3. The Applicant shall be responsible for all monthly user rates, capacity charges, and tap fees. The failure to pay any rate charge or fee may result in a lien against the property and/or the termination of service to the property, the cost of which will be borne by Applicant, including, but not limited to, all attorney's fees and collection costs.
4. The District shall not be responsible for any damages as a result of any failure to supply service unless said damages are due to default, neglect or culpability on the part of the District.
5. If there is an available sanitary sewer within three hundred (300) feet of the property line, the property owner shall be required to connect to the District's sanitary sewer system.
6. The Applicant and District agree that the provision of sanitary sewer service touches and concerns the property and the terms of this Agreement bind the District and Applicant and their heirs, executors, administrators, personal representatives, successors, agents, attorneys, assigns, designees, and transferees.

The parties hereto have read and fully understand the above provisions and agree to comply with said provisions.

FALL CREEK REGIONAL WASTE DISTRICT  
Teresa K Hutton  
Signature

APPLICANT  
Kelly Brown  
Signature

STATE OF INDIANA )  
 ) SS:  
COUNTY OF MADISON )

SUBSCRIBED and sworn to before me this 31st day of October, 2005.

My Commission Expires:  
4-19-2008

Signature Teresa K Hutton

Printed Teresa K Hutton

Notary Public  
Resident of Madison County

\*\*\*\*\*  
INSPECTOR SA DATE INSPECTED 11/14/05 APPROVED ✓ REJECTED \_\_\_\_\_

REASON FOR REJECTION \_\_\_\_\_

DATE REINSPECTED \_\_\_\_\_ APPROVED \_\_\_\_\_ REJECTED \_\_\_\_\_

NOTES:  
SIZE PIPE 6" TYPE PIPE 35

BASEMENT YES NO

SUMP PUMP YES NO

DOWNSPOUT TO GROUND YES NO


SEPTIC TANK PUMPED & FILLED YES NO

CONTRACTOR Burth

SPECIAL CONDITIONS \_\_\_\_\_

EXISTING HOME 1

NEW CONSTRUCTION ✓

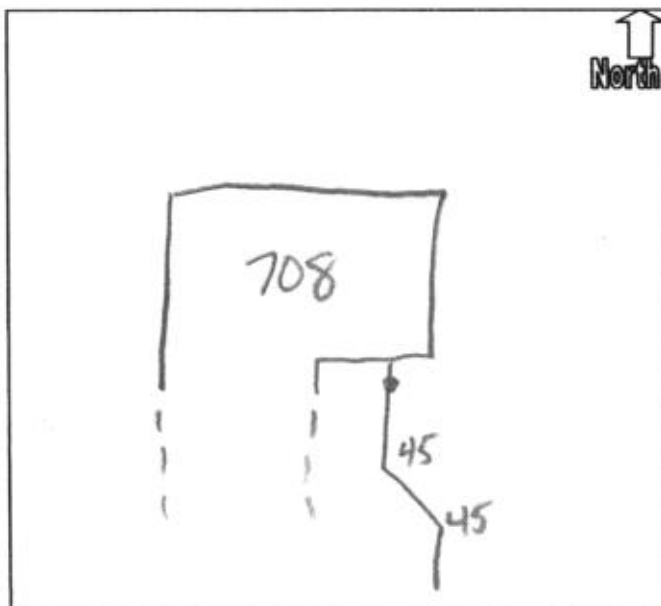

39437

C.P. MORGAN COMMUNITIES, LP  
CONSTRUCTION ACCOUNT

JPMORGAN CHASE BANK, N.A.  
INDIANAPOLIS, INDIANA 46277  
20-1-740

10/31/05

PAY TO THE  
ORDER OF

Fall Creek Regional Waste Dist

\$ 1,900.00

one thousand nine hundred & 00/100

DOLLARS

MEMO SU 609, 610, 620, 708

⑈039437⑈ ⑆074000010⑆ 705001387194⑈

Jennifer Hedger MP

080974/12-04