



FALL CREEK REGIONAL WASTE DISTRICT

Box 44, Pendleton, Indiana 46064

22-05200.02

Servantes:
Richard & Nikki Staggs
778-4403

2-0005200-00

Nº 001052

APPLICATION FOR SEWER PERMIT

Permit No. _____ Date Dec. 17, 1985
Permit Void 90 days from Date of Issuance
Owner Name Wayne M. Zage 601 Waldron St.
Property Address RR 4 Box 229 West Lafayette, IN
971 W. Deepport St. 47906
Lot # _____ P.O. Box _____
Town Pendleton, IN Zip Code 46064
Phone (317) 743-1056 Water Meter _____
\$ 150.00 Tap on Fee Paid
\$ 25.00 Inspection fee paid

Application is hereby made for connection to the Fall Creek Regional Waste District Sewer System for the above listed property - Permit Type: Residential ☒, Commercial _____, Industrial _____, or Governmental/Institutional _____. User Information _____.

All workmanship and materials shall conform to the standards of the District Ordinance as described in Ordinance 84-2 and 84-3 as amended. Acceptance and approval must be made by the District inspector or his duly authorized representative before backfilling and final connection is made to the main sewer lines. Any violation of applicable regulations will cause all lines and appurtenances in violation to be removed and replaced at the owners expense.

The Fall Creek Regional Waste District is responsible for the inspection, approval of materials, and installation techniques only. All costs for materials and installation and any liabilities resulting from same is the sole responsibility of the property owner.

I have read and fully understand the above provisions and agree to comply by said provisions.

APPLICANT(S) SIGNATURE


INSPECTOR PK

Date inspected 3-27 Approved ✓ Rejected _____

Reason for rejection _____

Date reinspected _____ Approved _____ Rejected _____

Notes:
Size Pipe 6 "
Type Pipe PVC
Basement Yes _____ No ☒
Sump Pump Yes _____ No ☒
Downspout to Ground Yes ☒ No _____
Septic Tank Pumped & filled Yes ☒ No _____
Contractor FSK
Special Conditions _____

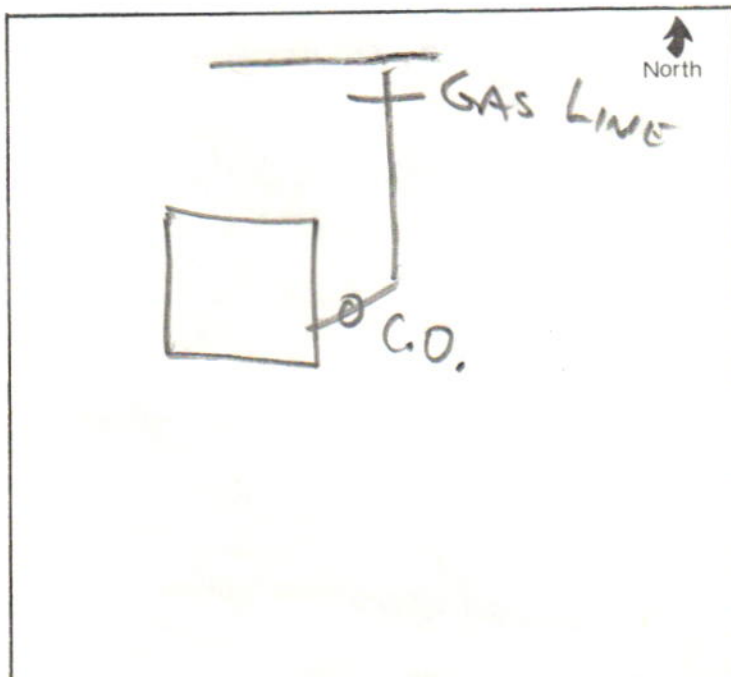

December 13, 1985

To whom it may concern:

Below is the information requested to fill out my application form for service at RR4 Box 229-230, Pendleton, IN. Also enclosed is a self-addressed envelope to return the necessary papers. Thank you for your help in filling out the application.

Owner: Dolores Zage
601 Waldron
West Lafayette, IN 47906
(317)-743-1056

Tenants: Richard and Nikki Staggs
RR4 Box 229
Pendleton, IN 46064
778-4403

2-0005200.00 No

Bruce and Tammy Hughes
RR4 Box 230
Pendleton, IN 46064
778-2670

2-0005220.00 No

Sincerely,

Dolores Zage

3900 Vienna Woods Dr
Muncie IN 47056