

Fall Creek Regional Waste District

#7319

9378 S 650 W, P.O. Box 59, Pendleton, IN 46064

765-778-7544

Agreement for Sanitary Sewer Service

This Agreement made and entered into this 14 day of Aug., 2020, between Fall Creek Regional Waste District ("District") and Ryan Hones ("Applicant") regarding the provision of sanitary sewer service, and the assignment of capacity in and connection to, the District's facilities for the premises located at Lot #48 Oakmont.

Street Address: 9724 Oak Grove Dr. Pendleton, IN 46064

Now therefore, the parties, in consideration of the mutual promises set out in this Agreement, the receipt and sufficiency of which is hereby acknowledged, agree as follows:

1. The Applicant agrees that all workmanship and materials shall conform to all District ordinances and the District's construction standards. District must accept and approve all work and materials before backfilling and final connection is made to the sewer mains. Any violation of this provision will cause all lines and appurtenances in violation to be removed and replaced at the Applicant's expense.
2. The District shall have the right to enter upon the Applicant's premises at all reasonable times to inspect, repair, or replace any equipment used in connection with the District's service or which has an impact on said service.
3. The Applicant shall be responsible for all monthly user rates, capacity charges, and tap fees. The failure to pay any rate charge or fee may result in a lien against the property and/or the termination of service to the property, the cost of which will be borne by Applicant, including, but not limited to, all attorney's fees and collection costs.
4. The District shall not be responsible for any damages as a result of any failure to supply service unless said damages are due to default, neglect or culpability on the part of the District.
5. If there is an available sanitary sewer within three hundred (300) feet of the property line, the property owner shall be required to connect to the District's sanitary sewer system.
6. The Applicant and District agree that the provision of sanitary sewer service touches and concerns the property and the terms of this Agreement bind the District and Applicant and their heirs, executors, administrators, personal representatives, successors, agents, attorneys, assigns, designees, and transferees.

The parties hereto have read and fully understand the above provisions and agree to comply with said provisions.

FALL CREEK REGIONAL WASTE DISTRICT

Signature


APPLICANT

Signature

STATE OF INDIANA)

) SS:

COUNTY OF MADISON)

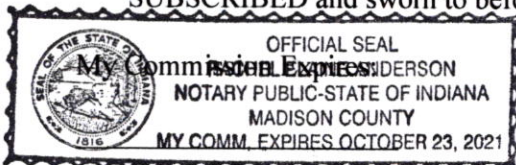SUBSCRIBED and sworn to before me this 14 day of Aug., 2020

Signature

Printed

Notary Public

Resident of Madison County

Inspector SM Date Inspected 9-4-20 Approved X Rejected _____

Reason for Rejection _____

Date Reinspected _____ Approved _____ Rejected _____

Notes:

Size Pipe 6 Type Pipe 35

Basement Yes _____ No _____

Sump Pump Yes _____ No _____

Downspout to Ground Yes _____ No _____

Septic Tank Pumped & Filled Yes _____ No _____

Contractor Will's Ex.

Special Conditions _____

Existing Home _____

New Construction X

North ↑

Drawing
+
2 pictures
attached

STOEPPELWERTH

ALWAYS ON

7965 East 106th Street, Fishers, IN 46038-2505
phone: 317.849.5935 fax: 317.849.5942

JOB ID OAKMONT.48

CONTROL# 93125 RYAN

9724 OAK GROVE DRIVE
PENDLETON, IN 46064

1" = 30'

LOT AREA: 8,369 Sq. Ft.

LOT 48
OAKMONT
SECTION ONE
INST. #2019R002446

ESTABLISHED DRAINAGE EASEMENT
WITH EROSION CONTROL IN PLACE.
DO NOT DISTURB.

LEGEND:

XX.X

PROPOSED GRADE PER PLAN

XX.XAB

AS BUILT GRADE

S.S.D.

SUB-SURFACE DRAIN

ASL

SANITARY SEWER

PSL

6" AS BUILT SANITARY LATERAL

PSL

6" PROPOSED SANITARY LATERAL

W

STORM SEWER

W

3/4" WATER CONNECTION

W

WATER MAIN

SWALE

SWALE

●

SANITARY MANHOLE

○

STORM MANHOLE

■

CURB INLET

⊙

FIRE HYDRANT

▼

END SECTION

↩

EMERGENCY FLOOD ROUTE

D.E.

DRAINAGE EASEMENT


D.U.&S.E.

DRAINAGE UTILITY &

B.L.

SEWER EASEMENT

BUILDING LINE

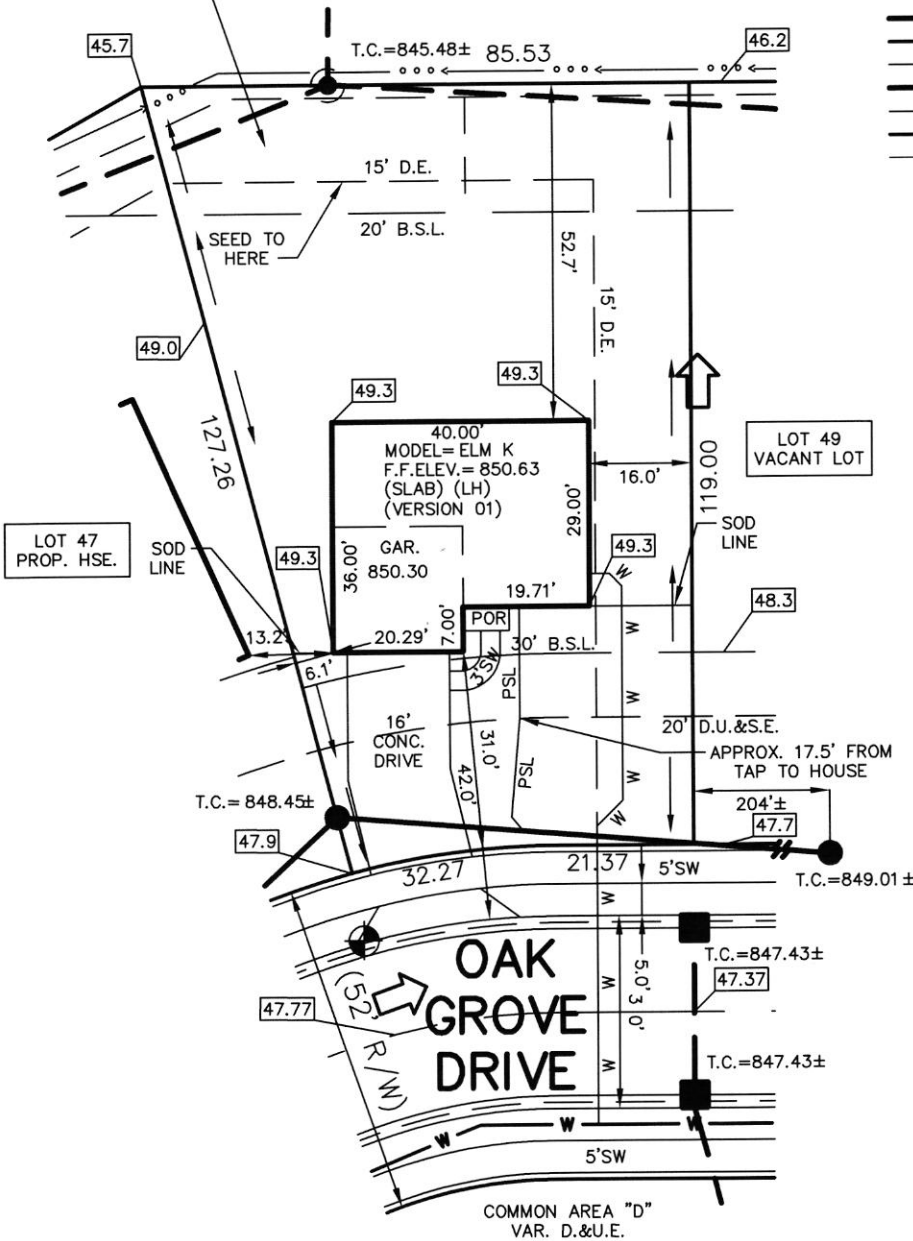

David J. Stoepfelwerth

NOTE: THIS DRAWING IS NOT INTENDED TO BE REPRESENTED AS A RETRACEMENT OR ORIGINAL BOUNDARY SURVEY, A ROUTE SURVEY OR A SURVEYOR LOCATION REPORT.

30' MINIMUM FRONT YARD
15' MINIMUM REAR YARD
5' MINIMUM SIDE YARD
10' MINIMUM BETWEEN STRUCTURE

SOD: 186 ± Sq. Yd.
SEEDING: 3,748 ± Sq. Ft.
CONC. DRIVEWAY: 538 ± Sq. Ft.
PRIVATE WALK: 37 ± Sq. Ft.
PUBLIC WALK: 183 ± Sq. Ft.
APRON: 185 ± Sq. Ft.
HOUSE WIDTH: 40.00 Ft.
HOUSE DEPTH: 36.00 Ft.



BENCHMARK
TOP OF CURB=847.77

ALL UNDERGROUND SEWERS AND UTILITIES SHOWN ARE PLOTTED BY SCALE FROM DESIGN PLANS FURNISHED BY ENGINEER. THE ACTUAL FIELD LOCATION MAY VARY.




Oakmont Lot 48

9724

oak grove Dr. N

Wills

Ex.

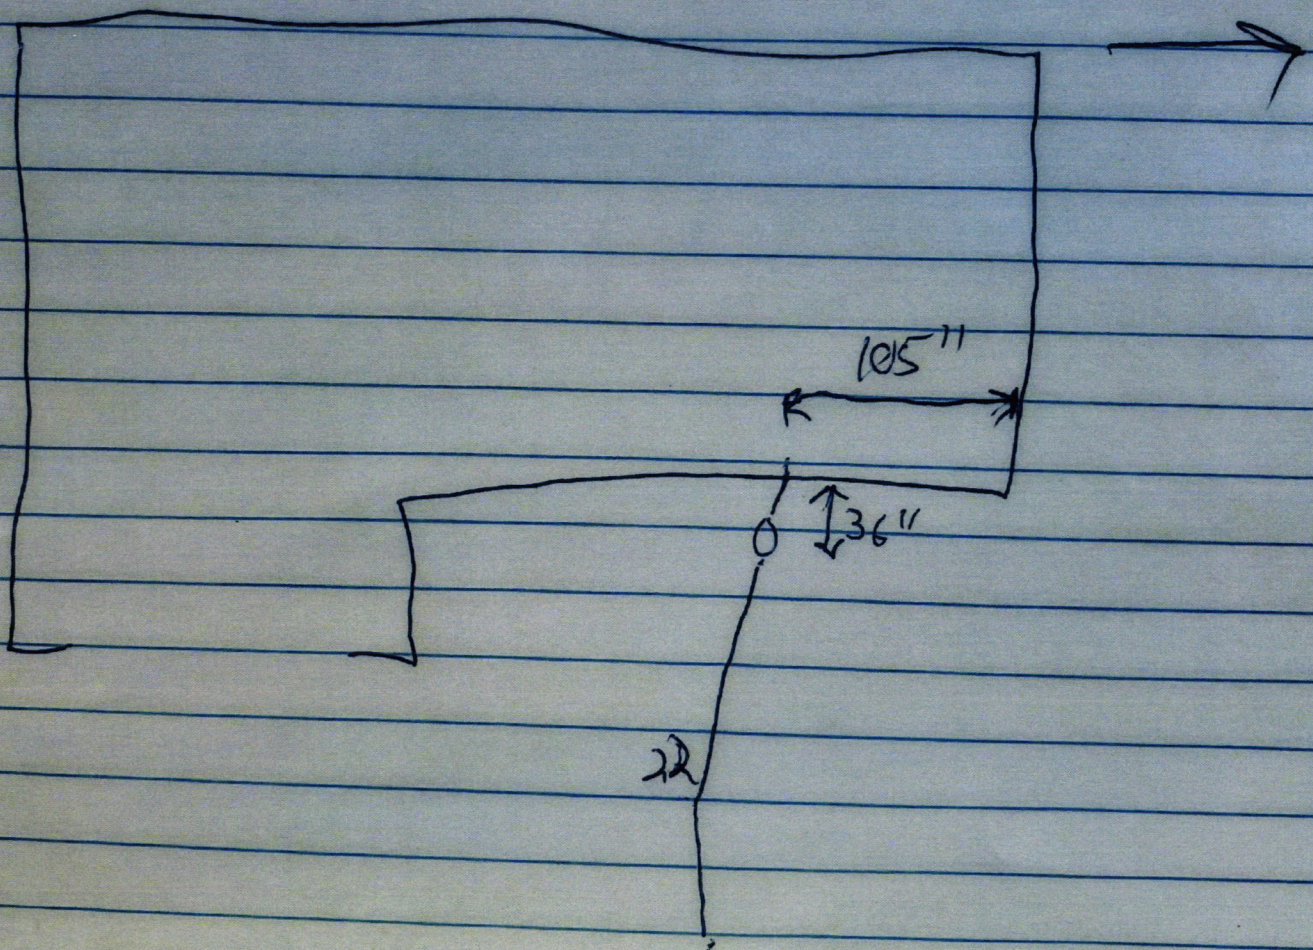





Bank of America, N.A.
Atlanta, Dekalb County, Georgia



RYAN HOMES
NVHOMES
HEARTLAND HOMES
NVR BUILDING PRODUCTS

FIELD ACCOUNT

364731

64-1278
B11

DATE 08/12/20
VENDOR # 70075
CHECK # 364731

PAY

*****4,160.00

EXACTLY:

FOUR THOUSAND ONE HUNDRED SIXTY DOLLARS AND 00 CENTS

PAY TO THE ORDER OF:

 
VOID AFTER 90 DAYS

NVR, INC.

CHECK NOT VALID OVER \$50,000.00

FALL CREEK REGIONAL WASTE


AUTHORIZED SIGNATURE

SECURITY FEATURES INCLUDED  DETAILS ON BACK

Rec # 011321