#7025

Fall Creek Regional Waste District 9378 S 650 W, P.O. Box 59, Pendleton, IN 46064 765-778-7544

Agreement for Sanitary Sewer Service

This Agreement made and entered into this 3 day of Regional Waste District ("District") and 4 4 4 4 4 4 4 4 4 4 4 4 4 4 4 4 4 4 4	("Applicant") regarding the pacity in and connection to, the District's
Street Address: 9730 OCK Grove Dr. Pendi	etal, In 4100ie4
Now therefore, the parties, in consideration of the mutu- receipt and sufficiency of which is hereby acknowledged, ag	al promises set out in this Agreement, the ree as follows:
 The Applicant agrees that all workmanship and mate and the District's construction standards. District mu before backfilling and final connection is made to the provision will cause all lines and appurtenances in vi Applicant's expense. 	st accept and approve all work and materials e sewer mains. Any violation of this
 The District shall have the right to enter upon the Ap inspect, repair, or replace any equipment used in con has an impact on said service. 	plicant's premises at all reasonable times to nection with the District's service or which
3. The Applicant shall be responsible for all monthly us failure to pay any rate charge or fee may result in a litermination of service to the property, the cost of which is the	en against the property and/or the
but not limited to, all attorney's fees and collection collection. 4. The District shall not be responsible for any damages	osts.
unless said damages are due to default, neglect or cul 5. If there is an available sanitary sewer within three hu	pability on the part of the District.
property owner shall be required to connect to the Di	strict's sanitary sewer system.
concerns the property and the terms of this Agreemen	nt bind the District and Applicant and their
heirs, executors, administrators, personal representati designees, and transferees.	ves, successors, agents, attorneys, assigns,
The parties hereto have read and fully understand the aborerovisions.	ove provisions and agree to comply with said
FALL GREEK-REGIONAL WASTE DISTRICT	
Velil 2 game	APPLICANT
Signature	Signature
STATE OF INDIANA)	
) SS: COUNTY OF MADISON)	
SUBSCRIBED and sworn to before me this 27 day of	N/a 20 B
SUBSCRIBED and sworn to before me this 2 day of	Dec., 20 Fr
My Commission Expires: ANDERSON Signature NOTARY PUBLIC STATE OF INDIANA	Dec. , 20 Fr
My Commission Explans: Anderson Signature Notary Public-State of Indiana Madison County My Comm. Expines October 23, 2021 Printed	Recht E. Andersa
OFFICIAL SEAL OFFICIAL SEAL ANDERSON NOTARY PUBLIC-STATE OF INDIANA MADISON COUNTY MY COMM. EXPIRES OCTOBER 23, 2021 Printed	Achel & Anderson Notary Public Resident of Madis—County
OFFICIAL SEAL NOTARY PUBLIC-STATE OF INDIANA MADISON COUNTY MY COMM. EXPIRES OCTOBER 23, 2021 Printed F	Resident of Modis—County
NOTARY PUBLIC-STATE OF INDIANA MADISON COUNTY MY COMM. EXPIRES OCTOBER 23, 2021 **********************************	Resident of Modis—County
Signature Notary Public-State Of Indiana Madison County My Comm. Expires October 23, 2021 Printed Inspector Date Inspected Approved Approved	Resident of Modis—County Rejected Resident of Rejected
Signature NOTARY PUBLIC-STATE OF INDIANA MADISON COUNTY MY COMM. EXPIRES OCTOBER 23, 2021 **********************************	Rejected
Signature Notary Public-State Of Indiana Madison County My Comm. Expires October 23, 2021 Printed Inspector Date Inspected Approved Approved	Rejected
Signature NOTARY PUBLIC-STATE OF INDIANA MADISON COUNTY MY COMM. EXPIRES OCTOBER 23, 2021 **********************************	Rejected
Signature Signature Notary Public State of Indiana Madison County My Comm. Expires october 23, 2021 Printed	Rejected North
Signature NOTARY PUBLIC-STATE OF INDIANA MADISON COUNTY MY COMM. EXPIRES OCTOBER 23, 2021 Printed Inspector Notary Date Inspected Notes: Size Pipe G Type Pipe 35 Basement Yes No Sump Pump Yes No Downspout to Ground Yes No Septic Tank Pumped & Filled Yes No Contractor Notary Public-State of Indiana Madison County Printed Approved Notes: Size Pipe G Type Pipe 35 Basement Yes No Sump Pump Yes No Contractor No Septic Tank Pumped & Filled Yes No Contractor No Contractor No Signature	Rejected North
Signature Notary Public State of Indiana Madison County My Comm. Expires october 23, 2021 Printed	Rejected
Signature NOTARY PUBLIC-STATE OF INDIANA MADISON COUNTY MY COMM. EXPIRES OCTOBER 23, 2021 Printed Inspector Notary Date Inspected Notes: Size Pipe G Type Pipe 35 Basement Yes No Sump Pump Yes No Downspout to Ground Yes No Septic Tank Pumped & Filled Yes No Contractor Notary Public-State of Indiana Madison County Printed Approved Notes: Size Pipe G Type Pipe 35 Basement Yes No Sump Pump Yes No Contractor No Septic Tank Pumped & Filled Yes No Contractor No Contractor No Signature	Rejected North
Signature NOTARY PUBLIC-STATE OF INDIANA MADISON COUNTY MY COMM. EXPIRES OCTOBER 23, 2021 **********************************	Rejected North

STOE _


STOEPPELWERTH

ALWAYSON

7965 East 106th Street, Fishers, IN 46038-2505 phone: 317.849.5935 fax: 317.849.5942 JOB ID OAKMONT.45

CONTROL# 89998 RYAN

9730 OAK GROVE DRIVE PENDLETON, IN 46064 1" = 30' LOT AREA: 7,155 Sq. Ft. LOT 45 OAKMONT SECTION ONE INST. #2019R002446

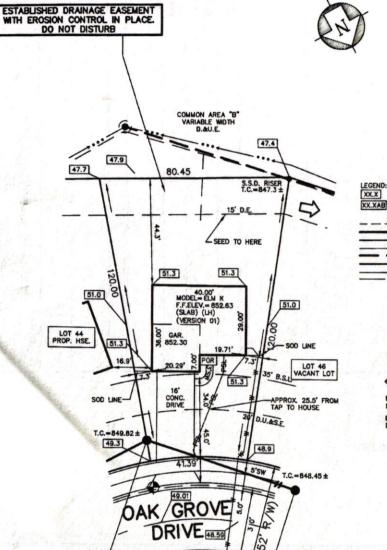

PROPOSED GRADE PER PLAN

XX.XAB

AS BUILT GRADE

S.S.D.

SUB-SURFACE DRAIN
SANITARY SEWER

6" AS BUILT SANITARY LATERAL

5" PROPOSED SANITARY LATERAL

W WATER MAIN

WATER MAIN

SANITARY MANHOLE

STORM MANHOLE

CURB INLET

DEALE

DRAINAGE LASEMENT

B.S.L.

BUILDING SETBACK LINE

DRAINAGE WITLITY &

SEWER EASEMENT

DRAINAGE UNILLY CASEMENT

30" MINIMUM PRONT YARD 15" MINIMUM REAR YARD 5" MINIMUM SIDE YARD 10" MINIMUM BETWEEN STRUCTURE

SOD: SEEDING: 2,754 ± Sq. Ft. 603 ± Sq. Ft. 603 ± Sq. Ft. 36 ± Sq. Ft. 176 ± Sq. Ft. 1


BENCHMARK
TOP OF CURB=849.01


ALL UNDERGROUND SEWERS AND UTILITIES SHOWN ARE PLOTTED BY SCALE FROM DESIGN PLANS FURNISHED BY ENGINEER THE ACTUAL FIELD LOCATION MAY VARY.



NOTE: THIS DRAWING IS NOT INTENDED TO BE REPRESENTED AS A RETRACEMENT OR ORIGINAL BOUNDARY SURVEY, A ROUTE SURVEY OR A SURVEYOR LOCATION REPORT.



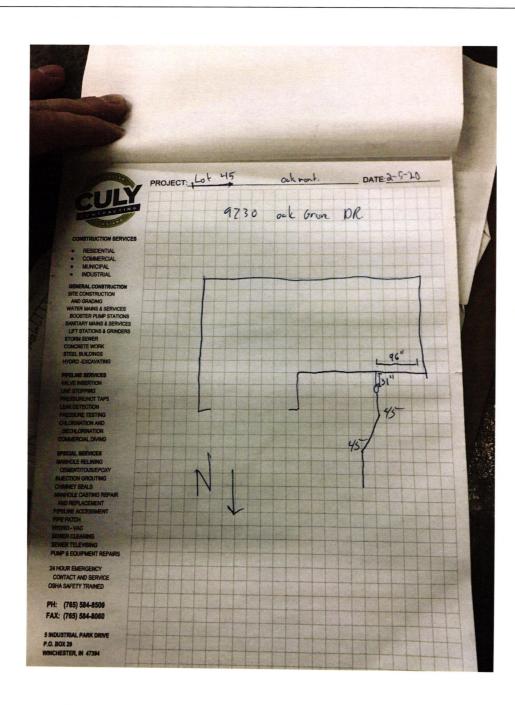

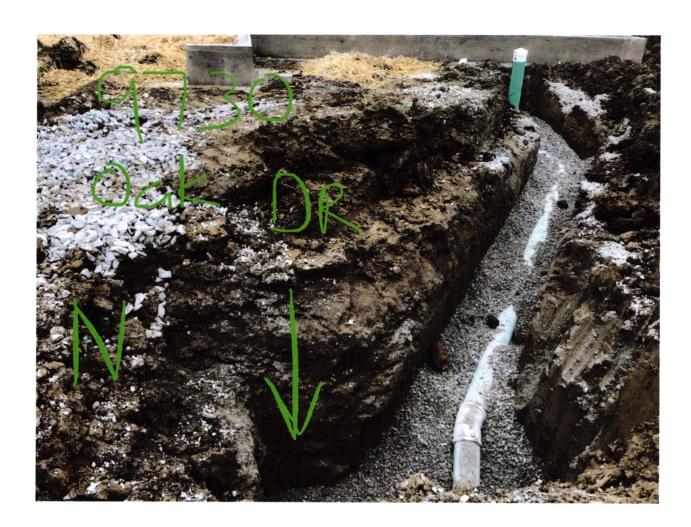

70075	-	FAT.T.	CREEK	REGIONAL.	WACTE

12/17/2019

	70075 FALL CREEK	KLIOTOMILL	****	, 1 12						12/1//2019
VENDOR ACCOUNT	INVOICE NUMBER	INVOICE DATE	СО	DIV	СМ	LOT	U	PH/A	ACCT	AMOUNT
	OM45SEWER OM45SEWER	12-17-19 12-17-19				0045 0045		012A 012A		570.00 2,800.00
		No.								
		A. A.								
			1							
					16					
		1)					14			
SEWER PERMIT				87						
OAKMONT 45 9730 OAK GRO	2.3	2						79		
		<u>S</u>								

FALL CREEK REGIONAL WASTE PO BOX 59 PENDLETON IN 46064

REMITTANCE ADVICE

DETACH BEFORE DEPOSITING CHECK THE FRONT OF THIS CHECK CHANGES COLOR GRADUALLY AND EVENLY FROM DARK TO LIGHT.

Bank of America, N.A.

RYAN HOMES NVHOMES HEARTLAND HOMES NVR BUILDING PRODUCTS

DATE 12/17/19

VENDOR # 70075 300492

PAY

*3,370.00

EXACTLY:

THREE THOUSAND THREE HUNDRED SEVENTY DOLLARS AND 00 CENTS

PAY TO THE ORDER OF:

VOID AFTER 90 DAYS

NVR, INC.

CHECK NOT VALID OVER \$50,000.00

FALL CREEK REGIONAL WASTE

SECURITY FEATURES INCLUDED [1] DETAILS ON BACK