

Fall Creek Regional Waste District

#7101

9378 S 650 W, P.O. Box 59, Pendleton, IN 46064

765-778-7544

Agreement for Sanitary Sewer Service

This Agreement made and entered into this 15 day of January 2020 between Fall Creek Regional Waste District ("District") and Ryan Jones ("Applicant") regarding the provision of sanitary sewer service, and the assignment of capacity in and connection to, the District's facilities for the premises located at Lot #34 Oakmont.

Street Address: 9743 Oak Grove Dr. Pendleton IN 46064

Now therefore, the parties, in consideration of the mutual promises set out in this Agreement, the receipt and sufficiency of which is hereby acknowledged, agree as follows:

1. The Applicant agrees that all workmanship and materials shall conform to all District ordinances and the District's construction standards. District must accept and approve all work and materials before backfilling and final connection is made to the sewer mains. Any violation of this provision will cause all lines and appurtenances in violation to be removed and replaced at the Applicant's expense.
2. The District shall have the right to enter upon the Applicant's premises at all reasonable times to inspect, repair, or replace any equipment used in connection with the District's service or which has an impact on said service.
3. The Applicant shall be responsible for all monthly user rates, capacity charges, and tap fees. The failure to pay any rate charge or fee may result in a lien against the property and/or the termination of service to the property, the cost of which will be borne by Applicant, including, but not limited to, all attorney's fees and collection costs.
4. The District shall not be responsible for any damages as a result of any failure to supply service unless said damages are due to default, neglect or culpability on the part of the District.
5. If there is an available sanitary sewer within three hundred (300) feet of the property line, the property owner shall be required to connect to the District's sanitary sewer system.
6. The Applicant and District agree that the provision of sanitary sewer service touches and concerns the property and the terms of this Agreement bind the District and Applicant and their heirs, executors, administrators, personal representatives, successors, agents, attorneys, assigns, designees, and transferees.

The parties hereto have read and fully understand the above provisions and agree to comply with said provisions.

FALL CREEK REGIONAL WASTE DISTRICT

Signature


APPLICANT

Signature

STATE OF INDIANA)

) SS:

COUNTY OF MADISON)

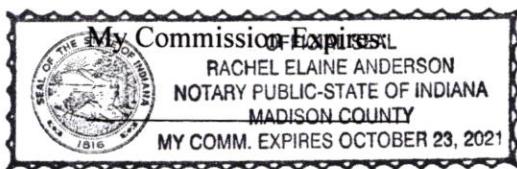SUBSCRIBED and sworn to before me this 15 day of January 2020

Signature

Printed

Notary Public

Resident of Madison County

Inspector Don Date Inspected 2-21-20 Approved ✓ Rejected _____

Reason for Rejection _____

Date Reinspected _____ Approved _____ Rejected _____

Notes:

Size Pipe 6" Type Pipe PVC 35Basement Yes NoSump Pump Yes NoDownspout to Ground Yes NoSeptic Tank Pumped & Filled Yes NoContractor Wills Ex.

Special Conditions _____

Existing Home _____

New Construction ✓

North ↑

Drawing
+
2 pictures
attached




STOEPPELWERTH

ALWAYS ON

7965 East 106th Street, Fishers, IN 46038-2505
phone: 317.849.5935 fax: 317.849.5942

JOB ID OAKMONT.34

CONTROL# 90045 RYAN

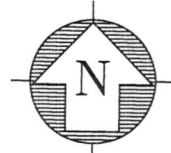

9743 OAK GROVE DRIVE
PENDLETON, IN 46064

1" = 30'

LOT AREA: 6,426 Sq. Ft.

LOT 34
OAKMONT
SECTION ONE
INST. #2019R002446

LEGEND:

XX.X

PROPOSED GRADE PER PLAN


XX.XAB

AS BUILT GRADE

— S.S.D. — SUB-SURFACE DRAIN
— SANITARY SEWER
— 6" AS BUILT SANITARY LATERAL
— 6" PROPOSED SANITARY LATERAL
— STORM SEWER
— WATER MAIN
— 3/4" WATER CONNECTION
— SWALE

● SANITARY MANHOLE
● STORM MANHOLE
■ CURB INLET
☼ FIRE HYDRANT
▼ END SECTION
← EMERGENCY FLOOD ROUTE

D.&U.E. DRAINAGE & UTILITY EASEMENT
B.S.L. BUILDING SETBACK LINE
D.E. DRAINAGE EASEMENT

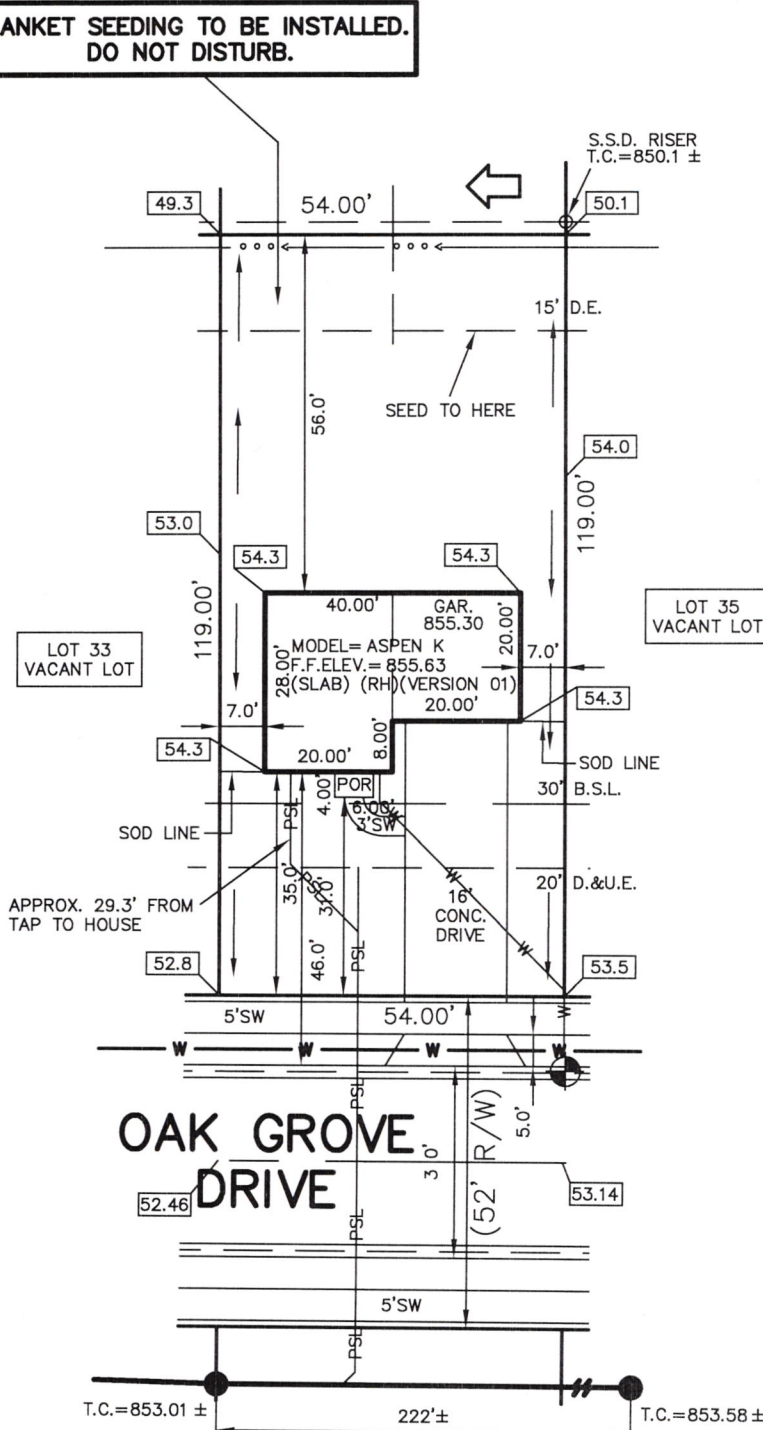

CONTRACTOR SHALL CUT 10' OFF OF LATERAL
AND BEGIN FROM THAT POINT AND CONNECT
TO HOUSE FOLLOWING PLOT PLAN.

30' MINIMUM FRONT YARD
15' MINIMUM REAR YARD
5' MINIMUM SIDE YARD
10' MINIMUM BETWEEN STRUCTURE

SOD: 175 ± Sq. Yd.
SEEDING: 2,550 ± Sq. Ft.
CONC. DRIVEWAY: 704 ± Sq. Ft.
PRIVATE WALK: 32 ± Sq. Ft.
PUBLIC WALK: 190 ± Sq. Ft.
APRON: 175 ± Sq. Ft.
HOUSE WIDTH: 40.00 Ft.
HOUSE DEPTH: 28.00 Ft.



BENCHMARK
TOP OF CURB=853.14

ALL UNDERGROUND SEWERS AND UTILITIES
SHOWN ARE PLOTTED BY SCALE FROM
DESIGN PLANS FURNISHED BY ENGINEER
THE ACTUAL FIELD LOCATION MAY VARY.




David J. Stoeppelwerth


NOTE: THIS DRAWING IS NOT INTENDED TO BE
REPRESENTED AS A RETRACEMENT OR ORIGINAL
BOUNDARY SURVEY, A ROUTE SURVEY OR A
SURVEYOR LOCATION REPORT.



Common
Willis Ex.

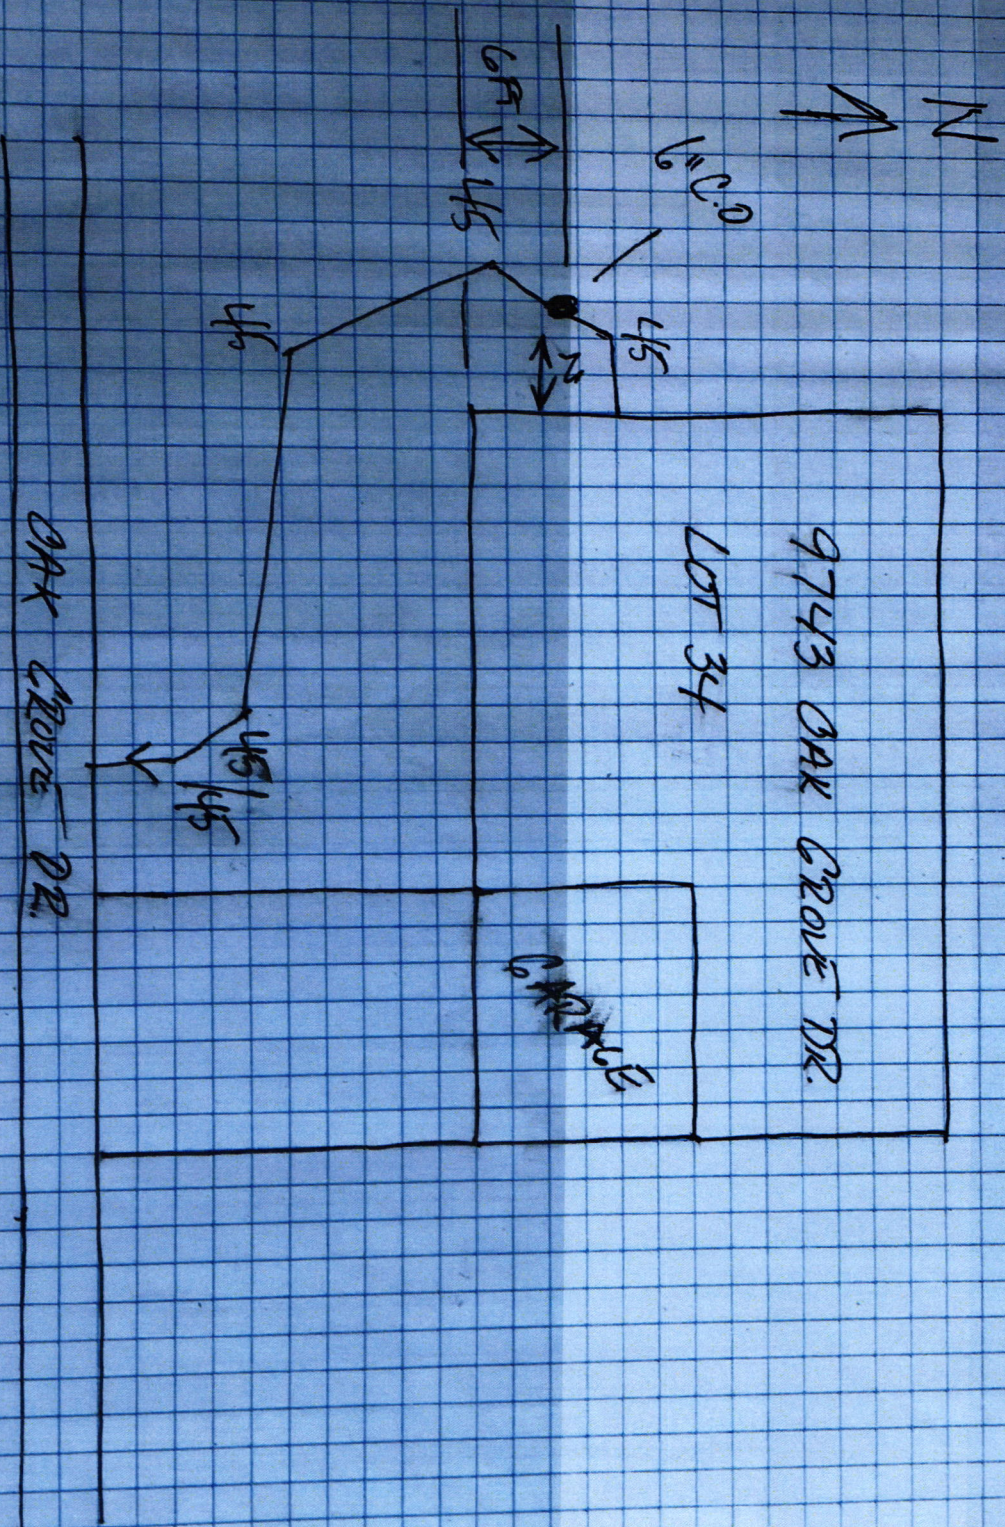



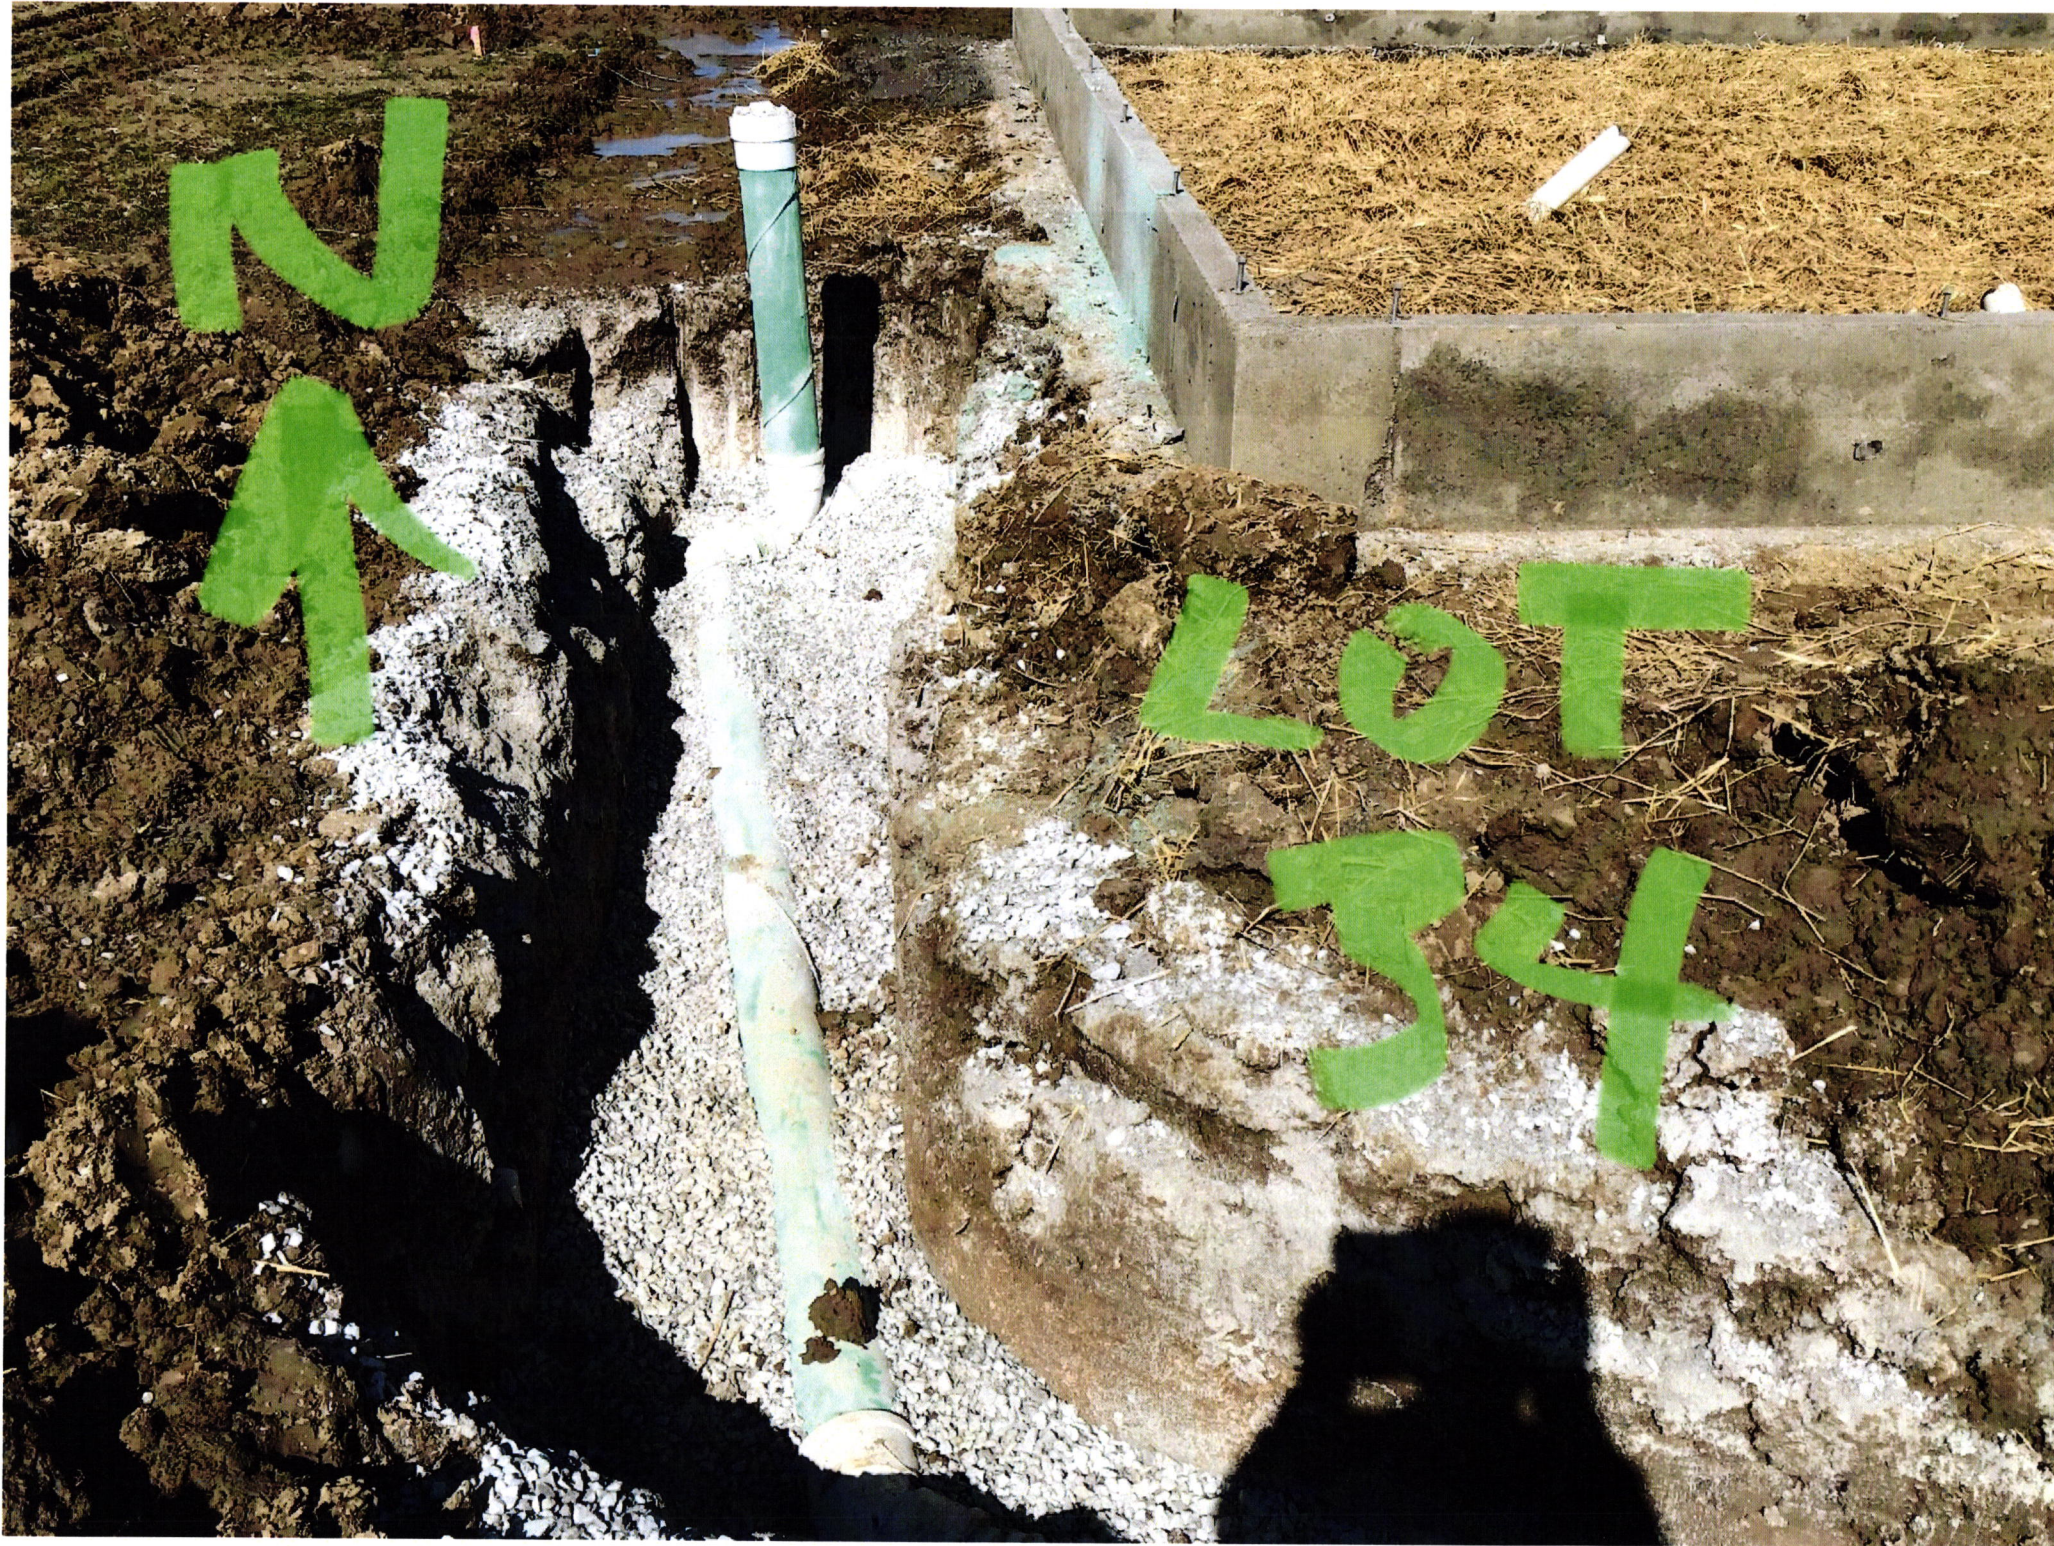

Q943 cat house N
Calmar Lot 34
Don Moore 2-21-2020

Bank of America, N.A.
Atlanta, Dekalb County, Georgia



RYAN HOMES
NVHOMES
HEARTLAND HOMES
NVR BUILDING PRODUCTS

FIELD ACCOUNT

64-127
6411

334553

DATE 01/14/20
VENDOR # 70075
CHECK # 334553

PAY *****3,370.00

EXACTLY:

THREE THOUSAND THREE HUNDRED SEVENTY DOLLARS AND 00 CENTS

PAY TO THE ORDER OF:

VOID AFTER 90 DAYS

NVR, INC.

CHECK NOT VALID OVER \$50,000.00

FALL CREEK REGIONAL WASTE


AUTHORIZED SIGNATURE

Rec # 011109