Fall Creek Regional Waste District 9378 S 650 W, P.O. Box 59, Pendleton, IN 46064 765-778-7544

Agreement for Sanitary Sewer Service

This Agreement made and enter	ed into this 20 day of	July, 20,21, between Fall Cre	eek
Regional Waste District ("District")	and Arbor Homes	s 0 ("Applicant") regard	ing the
		pacity in and connection to, the Distri	ict's
facilities for the premises located at _	Estes Park Lot 7		

	-							
Street Address:		9832	DLy	Mpic	Blvd			
			J	1				1


Now therefore, the parties, in consideration of the mutual promises set out in this Agreement, the receipt and sufficiency of which is hereby acknowledged, agree as follows:

- 1. The Applicant agrees that all workmanship and materials shall conform to all District ordinances and the District's construction standards. District must accept and approve all work and materials before backfilling and final connection is made to the sewer mains. Any violation of this provision will cause all lines and appurtenances in violation to be removed and replaced at the Applicant's expense.
- 2. The District shall have the right to enter upon the Applicant's premises at all reasonable times to inspect, repair, or replace any equipment used in connection with the District's service or which has an impact on said service.
- 3. The Applicant shall be responsible for all monthly user rates, capacity charges, and tap fees. The failure to pay any rate charge or fee may result in a lien against the property and/or the termination of service to the property, the cost of which will be borne by Applicant, including, but not limited to, all attorney's fees and collection costs.
- 4. The District shall not be responsible for any damages as a result of any failure to supply service unless said damages are due to default, neglect or culpability on the part of the District.
- 5. If there is an available sanitary sewer within three hundred (300) feet of the property line, the property owner shall be required to connect to the District's sanitary sewer system.
- 6. The Applicant and District agree that the provision of sanitary sewer service touches and concerns the property and the terms of this Agreement bind the District and Applicant and their heirs, executors, administrators, personal representatives, successors, agents, attorneys, assigns, designees, and transferees.

The parties hereto have read and fully understand the above provisions and agree to comply with said provisions.

FALL CREEK REGIONAL WASTE DISTRICT	Γ	APPLICANT
Signature	_	Signature
STATE OF INDIANA)) SS:		\vee
COUNTY OF MADISON)		
SUBSCRIBED and sworn to before me this	day of	, 20
My Commission Expires:	Signature	
	Printed	
*****	No Re	otary Public esident of County
Inspector See Date Inspected 7-20-2 Reason for Rejecton Date Reinspected Notes: Size Pipe 6Type Pipe 35 Basement Yes No Sump Pump Yes No Sump Pump Yes No Downspout to Ground Yes No Septic Tank Pumped & Filled Yes No Contractor Special Conditions Existing Home New Construction		

#7969

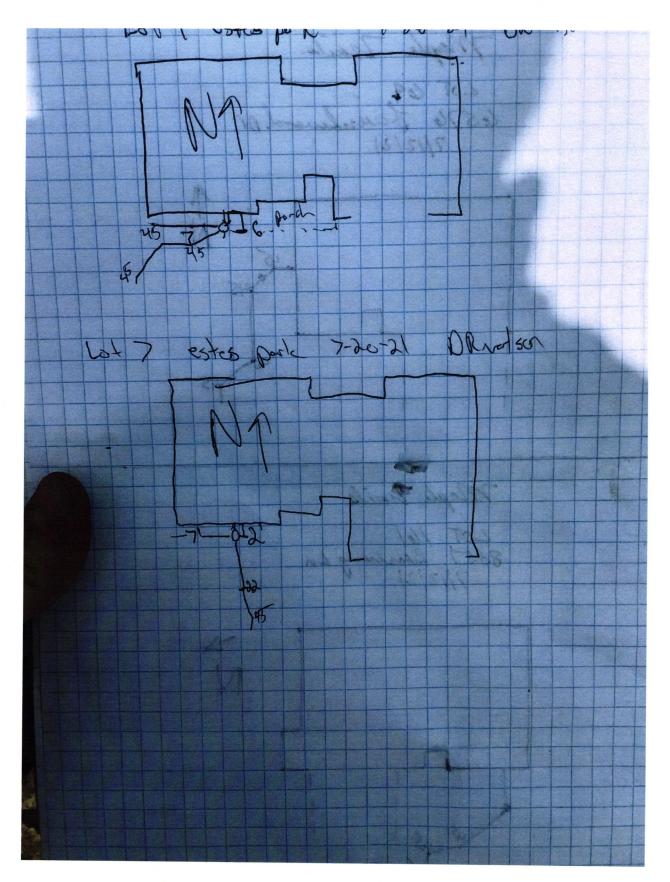



Estes Park Lot 7 Sean Mitchel 7/20/2021

