

Agreement for Sanitary Sewer Service

COPY

This Agreement made and entered into this 2 day of June, 2011, between Fall Creek Regional Waste District ("District") and James Coleman ("Applicant") regarding the provision of sanitary sewer service, and the assignment of capacity in and connection to, the District's facilities for the premises located at 9896 S Durbin Lane.

Now therefore, the parties, in consideration of the mutual promises set out in this Agreement, the receipt and sufficiency of which is hereby acknowledged, agree as follows:

1. The Applicant agrees that all workmanship and materials shall conform to all District ordinances and the District's construction standards. District must accept and approve all work and materials before backfilling and final connection is made to the sewer mains. Any violation of this provision will cause all lines and appurtenances in violation to be removed and replaced at the Applicant's expense.
2. The District shall have the right to enter upon the Applicant's premises at all reasonable times to inspect, repair, or replace any equipment used in connection with the District's service or which has an impact on said service.
3. The Applicant shall be responsible for all monthly sewer charges and tap fees. The failure to pay any rate charge or fee may result in termination of service to the property, the cost of which shall be borne by the Applicant, but not limited to, all attorney's fees and collection costs.
4. The District shall not be responsible for any damages to the property or the sewer line, unless said damages are due to default, neglect or misuse of the property.
5. If there is an available sanitary sewer within three feet of the property line, the property owner shall be required to connect to the sewer line.
6. The Applicant and District agree that the provisions of this Agreement shall bind the Applicant and their heirs, executors, administrators, personal representatives, successors, agents, attorneys, assigns, designees, and transferees.

The parties hereto have read and fully understand the above provisions and agree to comply with said provisions.

FALL CREEK REGIONAL WASTE DISTRICT
Signature Rebecca Hunter

APPLICANT

Signature _____

[illegible]

SUBSCRIBED and sworn to before me this 2 day of June, 2011

My Commission Expires:



Commission Expires November 20, 2015
A Resident of
Hamilton County, Indiana
Rebecca Lynn Hunter, Notary Public

Signature_____

Printed

Notary Public

Resident of Hamilton County

Inspector Tim Date Inspected 6-1-11 Approved ☒ Rejected ☐

Reason for Rejection

Date Reinspected _____ Approved _____ Rejected _____

Notes:

Size Pipe 4" / 1 1/2 Type Pipe 35 / 160

Basement Yes No ✓

Sump Pump Yes ☒ No

Downspout to Ground Yes ☒ No


Septic Tank Pumped & Filled Yes ☒ No ☐

Contractor SELF / O & B (Ron)

Special Conditions

Existing Home ☒

New Construction

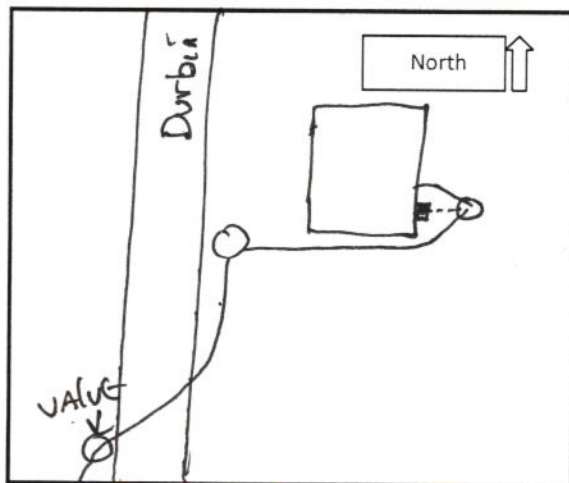

CR1000

Agreement for Sanitary Sewer Service

This Agreement made and entered into this 2 day of June, 2011, between Fall Creek Regional Waste District ("District") and James Coleman ("Applicant") regarding the provision of sanitary sewer service, and the assignment of capacity in and connection to, the District's facilities for the premises located at 9896 S Durbin Lane.

Now therefore, the parties, in consideration of the mutual promises set out in this Agreement, the receipt and sufficiency of which is hereby acknowledged, agree as follows:

1. The Applicant agrees that all workmanship and materials shall conform to all District ordinances and the District's construction standards. District must accept and approve all work and materials before backfilling and final connection is made to the sewer mains. Any violation of this provision will cause all lines and appurtenances in violation to be removed and replaced at the Applicant's expense.
2. The District shall have the right to enter upon the Applicant's premises at all reasonable times to inspect, repair, or replace any equipment used in connection with the District's service or which has an impact on said service.
3. The Applicant shall be responsible for all monthly user rates, capacity charges, and tap fees. The failure to pay any rate charge or fee may result in a lien against the property and/or the termination of service to the property, the cost of which will be borne by Applicant, including, but not limited to, all attorney's fees and collection costs.
4. The District shall not be responsible for any damages as a result of any failure to supply service unless said damages are due to default, neglect or culpability on the part of the District.
5. If there is an available sanitary sewer within three hundred (300) feet of the property line, the property owner shall be required to connect to the District's sanitary sewer system.
6. The Applicant and District agree that the provision of sanitary sewer service touches and concerns the property and the terms of this Agreement bind the District and Applicant and their heirs, executors, administrators, personal representatives, successors, agents, attorneys, assigns, designees, and transferees.

The parties hereto have read and fully understand the above provisions and agree to comply with said provisions.

FALL CREEK REGIONAL WASTE DISTRICT
Rebecca Hunter
Signature

APPLICANT

[Signature]
Signature

STATE OF INDIANA)
) SS:
COUNTY OF MADISON)

SUBSCRIBED and sworn to before me this 2 day of June, 2011

My Commission Expires:



Commission Expires November 20, 2015
A Resident of
Hamilton County, Indiana
Rebecca Lynn Hunter, Notary Public

Signature

Rebecca Lynn Hunter

Printed

Rebecca Lynn Hunter

Notary Public

Resident of Hamilton County

Inspector _____ Date Inspected _____ Approved _____ Rejected _____

Reason for Rejection _____
Date Reinspected _____ Approved _____ Rejected _____

Notes:

Size Pipe _____ Type Pipe _____

Basement Yes _____ No _____

Sump Pump Yes _____ No _____

Downspout to Ground Yes _____ No _____


Septic Tank Pumped & Filled Yes _____ No _____

Contractor _____

Special Conditions _____

Existing Home _____

New Construction _____

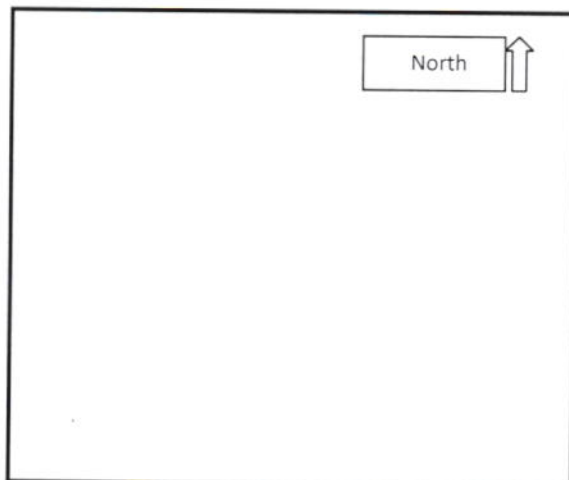

Fall Creek Regional Waste District
P.O. Box 59
Pendleton, IN 46064-0059
765-778-7544 WWW.FCRWD.COM

Date: 06/02 Time: 12:06

CREDIT CARD SALE

R-E-P-R-I-N-T

Card Data:	*****5468 S
Tran Amount:	2230.64
Approval Code:	050612
Clerk ID:	FCRWD
Record #:	008
Name:	James A Coleman

Customer Copy

paid tap fee
paid grinder
has pay agree
for capacity
fee

RECEIPT

FALL CREEK REGIONAL WASTE DISTRICT

P.O. BOX 59, CO. RD. 650 WEST

No 9921

General

FUND

PENDLETON IN. 46064

6/220 11

RECEIVED FROM

James A. Coleman\$2,230.64

THE SUM OF

two thousand two hundred thirty & 64/100

DOLLARS

ON ACCOUNT OF

sewer permit & tap & ~~capacity fee~~ grinder9896 S. Durbin Lane

PAYMENT TYPE & AMOUNT

CASH

CHECK

M.O.

E.F.T.

C.C./B.C.

#050612

OTHER

VISARebecca J. McClintick

AUTHORIZED SIGNATURE