



FALL CREEK REGIONAL WASTE DISTRICT

Box 44, Pendleton, Indiana 46064

1-0001605.00

Nº 000201

APPLICATION FOR SEWER PERMIT

Permit No. _____ Date _____

Permit Void 90 days from Date of Issuance

Owner Name Anna May Lasley

Property Address R2 Box 257 9964 S. 750 W.

Lot # _____ P.O. Box _____

Town Fortville, IN Zip Code 46040

Phone 485- Water Meter Inalls "

\$ 150.00 Tap on Fee Paid

\$ 25.00 Inspection fee paid

Application is hereby made for connection to the Fall Creek Regional Waste District Sewer System for the above listed property - Permit Type: Residential ☒, Commercial _____, Industrial _____, or Governmental/Institutional _____. User Information _____.

All workmanship and materials shall conform to the standards of the District Ordinance as described in Ordinance 84-2 and 84-3 as amended. Acceptance and approval must be made by the District inspector or his duly authorized representative before backfilling and final connection is made to the main sewer lines. Any violation of applicable regulations will cause all lines and appurtenances in violation to be removed and replaced at the owners expense.

The Fall Creek Regional Waste District is responsible for the inspection, approval of materials, and installation techniques only. All costs for materials and installation and any liabilities resulting from same is the sole responsibility of the property owner.

I have read and fully understand the above provisions and agree to comply by said provisions.

Anna May Lasley
APPLICANT(S) SIGNATURE

INSPECTOR Tim

Date inspected 10-16-85 Approved ☒ Rejected _____

Reason for rejection _____

Date reinspected _____ Approved _____ Rejected _____

Notes:

Size Pipe 6" "

Type Pipe PVC

Basement Yes _____ No ☒


Sump Pump Yes _____ No ☒

Downspout to Ground Yes _____ No ☒

Septic Tank Pumped & filled Yes ☒ No _____

Contractor Flatford

Special Conditions _____

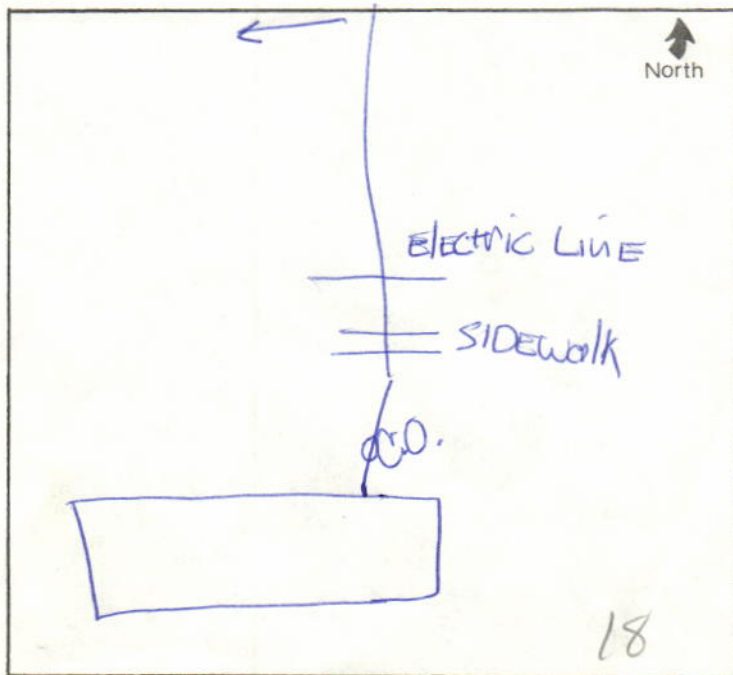

18