



# FALL CREEK REGIONAL WASTE DISTRICT

9378 S. 650 West PO Box 59  
Pendleton, IN 46064-0059 778-7544

No 2708

## APPLICATION FOR SEWER PERMIT

Date 10/14/99

Permit Void 90 days from Date of Issuance

Owner Name Pendleton Place Apartments - Phase II

Property Address \_\_\_\_\_

Lot # Building #6 P.O. Box \_\_\_\_\_

Town Pendleton, IN Zip Code \_\_\_\_\_

Phone \_\_\_\_\_ City Water ☒ Well \_\_\_\_\_

\$ \_\_\_\_\_ Tap on Fee Paid

\$ \_\_\_\_\_ Inspection fee paid

Application is hereby made for connection to the Fall Creek Regional Waste District Sewer System for the above listed property - Permit Type: Residential \_\_\_\_\_, Commercial \_\_\_\_\_, Industrial \_\_\_\_\_, or Governmental/Institutional \_\_\_\_\_. User Information \_\_\_\_\_.

All workmanship and materials shall conform to the standards of the District Ordinance as described in Ordinance 84-2 and 84-3 as amended. Acceptance and approval must be made by the District inspector or his duly authorized representative before backfilling and final connection is made to the main sewer lines. Any violation of applicable regulations will cause all lines and appurtenances in violation to be removed and replaced at the owners expense.

The Fall Creek Regional Waste District is responsible for the inspection, approval of materials, and installation techniques only. All costs for materials and installation and any liabilities resulting from same is the sole responsibility of the property owner.

I have read and fully understand the above provisions and agree to comply by said provisions.

APPLICANT(S) SIGNATURE \_\_\_\_\_

INSPECTOR Dan/Ber


Date inspected 10-13-99 Approved ☒ Rejected \_\_\_\_\_

Reason for rejection \_\_\_\_\_

Date reinspected \_\_\_\_\_ Approved \_\_\_\_\_ Rejected \_\_\_\_\_

Notes:  
Size Pipe 6 "  
Type Pipe PVC  
Basement Yes ☒ No ☒  
Sump Pump Yes ☒ No ☒  
Downspout to Ground Yes ☒ No ☒  
Septic Tank Pumped & filled Yes ☒ No ☒  
Contractor \_\_\_\_\_  
Special Conditions \_\_\_\_\_

Existing Home \_\_\_\_\_  
New Construction ☒

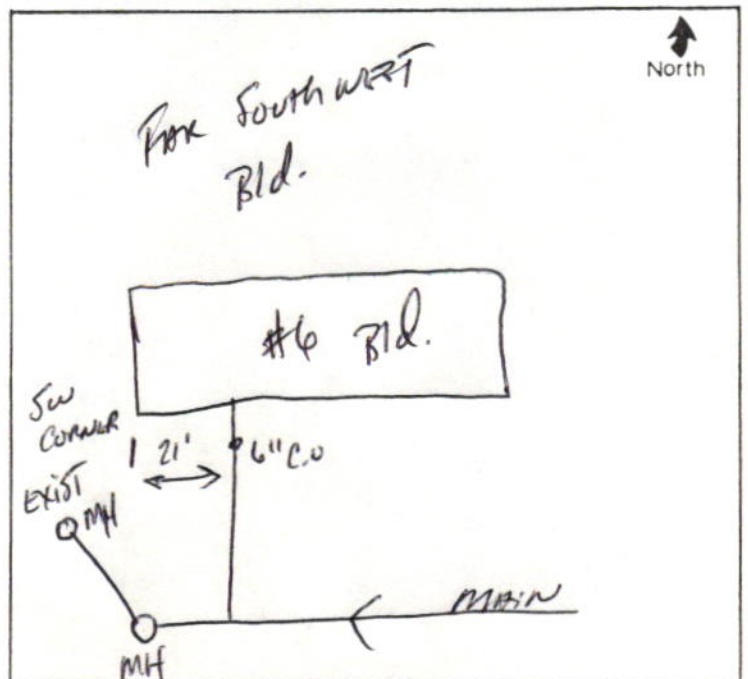

PENDLETON PLACE APARTMENTS II, LP  
6930 ATRIUM BOARDWALK S., STE. 100  
INDIANAPOLIS, IN 46250-2028

Date 7-12-00

1028  
20-104/740  
913

Pay to the Order of Fall Creek Regional Waste District

\$ 104,400.00

One Hundred Four Thousand Four Hundred and 00/100 \*\*\*\*\*  
Dollars

Security features  
are included.  
Details on back.



KeyBank National Association  
Indianapolis, Indiana 46204  
1-800-KEY2YOU

For (Connection Fees)

⑆074001048⑆

*James G. Lintz* MP  
1028