



# FALL CREEK REGIONAL WASTE DISTRICT

9378 S. 650 West PO Box 59  
Pendleton, IN 46064-0059 778-7544

No 2710

## APPLICATION FOR SEWER PERMIT

Date 10/18/99

Permit Void 90 days from Date of Issuance

Owner Name Pendleton Place Apartments - Phase II

Property Address \_\_\_\_\_

Lot # Building #7 P.O. Box \_\_\_\_\_

Town Pendleton, IN Zip Code 46064

Phone \_\_\_\_\_ City Water ☒ Well \_\_\_\_\_

\$ \_\_\_\_\_ Tap on Fee Paid

\$ \_\_\_\_\_ Inspection fee paid

Application is hereby made for connection to the Fall Creek Regional Waste District Sewer System for the above listed property - Permit Type: Residential \_\_\_\_\_, Commercial \_\_\_\_\_, Industrial \_\_\_\_\_, or Governmental/Institutional \_\_\_\_\_. User Information \_\_\_\_\_.

All workmanship and materials shall conform to the standards of the District Ordinance as described in Ordinance 84-2 and 84-3 as amended. Acceptance and approval must be made by the District inspector or his duly authorized representative before backfilling and final connection is made to the main sewer lines. Any violation of applicable regulations will cause all lines and appurtenances in violation to be removed and replaced at the owners expense.

The Fall Creek Regional Waste District is responsible for the inspection, approval of materials, and installation techniques only. All costs for materials and installation and any liabilities resulting from same is the sole responsibility of the property owner.

I have read and fully understand the above provisions and agree to comply by said provisions.

APPLICANT(S) SIGNATURE \_\_\_\_\_

INSPECTOR DW

Date inspected 10-18-99 Approved ☒ Rejected \_\_\_\_\_

Reason for rejection \_\_\_\_\_

Date reinspected \_\_\_\_\_ Approved \_\_\_\_\_ Rejected \_\_\_\_\_

Notes:

Size Pipe 6 "

Type Pipe PVC 35

Basement Yes \_\_\_\_\_ No ☒

Sump Pump Yes \_\_\_\_\_ No ☒

Downspout to Ground Yes ☒ No no


Septic Tank Pumped & filled Yes \_\_\_\_\_ No \_\_\_\_\_

Contractor L.D. Mech. Cont.

Special Conditions \_\_\_\_\_

Existing Home \_\_\_\_\_

New Construction ☒

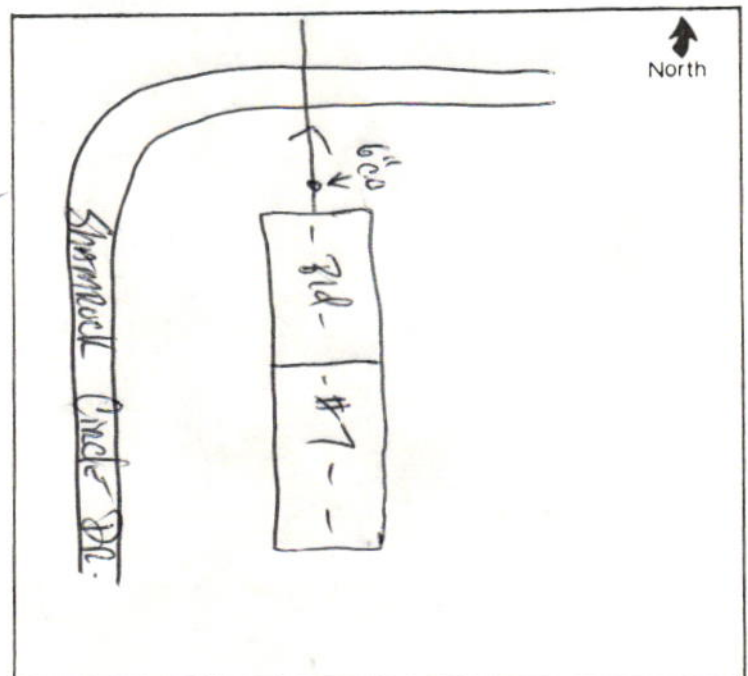

*Perfect form*

Phase 2  
Ponditon Place Apts.

Tap fee \$1,200

Cap fee \$103,200



**boyce**  
FORMS • SYSTEMS

P.O. Box 2039 - 501 W. Riggan Rd.  
Muncie, Indiana 47307-0039  
800-382-8702 or 765-289-2233, FAX 765-289-2376