

Gidw.


PROJECT Phase II SHEET _____ OF _____

SUBJECT _____ DATE 4-6-18


JOB NO. 4447

BY Atlas

Empty lot south of 401 Franklin

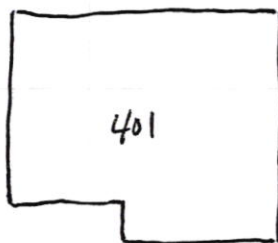

Empty lot

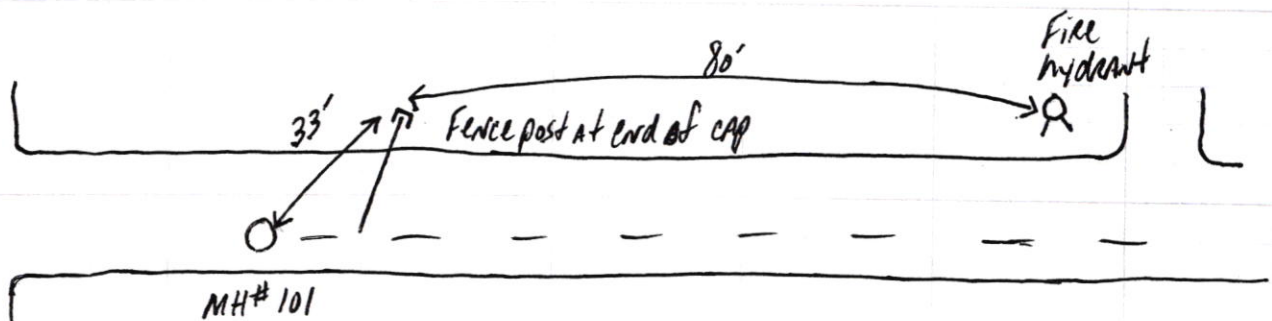

Empty Lot
South of
401 Franklin

SRP
Phase II

4.11.18

Fence post @ end
of lateral

