
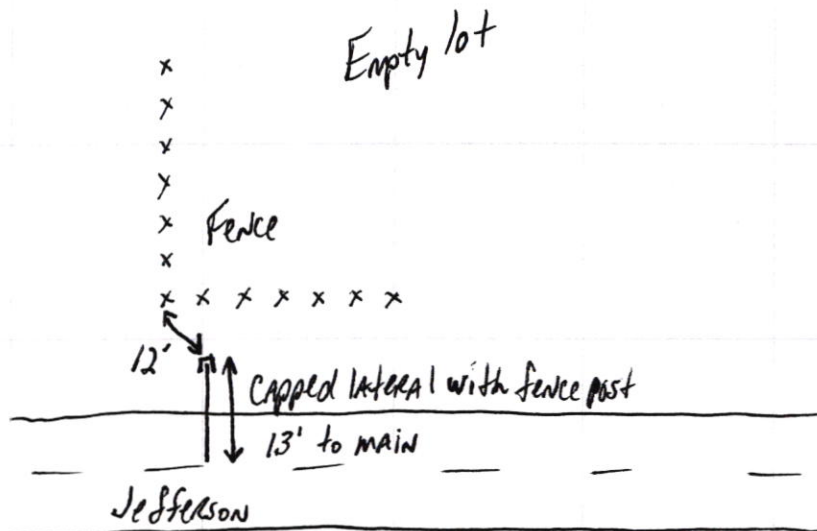


Gidw.

PROJECT Phase II SHEET _____ OF _____
SUBJECT _____ DATE 4-6-18
JOB NO. 4447
BY Atlas

Empty lot in front of 217 S. Jefferson

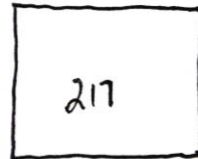

Empty lot
in front of
217 Jefferson

SRF
Phase II

4.11.18

Fence post @
end of lateral

