



FALL CREEK REGIONAL WASTE DISTRICT

9378 S. 650 West PO Box 59
Pendleton, IN 46064-0059 778-7544

Nº 2617

APPLICATION FOR SEWER PERMIT

Date _____

Permit Void 90 days from Date of Issuance

Owner Name Chuck Clevenger

Property Address Falls Park Plaza II

Lot # _____ P.O. Box _____

Town Pendleton, IN Zip Code 46064

Phone _____ City Water ☒ Well _____

\$ _____ Tap on Fee Paid

\$ _____ Inspection fee paid

Application is hereby made for connection to the Fall Creek Regional Waste District Sewer System for the above listed property - Permit Type: Residential _____, Commercial ☒, Industrial _____, or Governmental/Institutional _____. User Information _____.

All workmanship and materials shall conform to the standards of the District Ordinance as described in Ordinance 84-2 and 84-3 as amended. Acceptance and approval must be made by the District inspector or his duly authorized representative before backfilling and final connection is made to the main sewer lines. Any violation of applicable regulations will cause all lines and appurtenances in violation to be removed and replaced at the owners expense.

The Fall Creek Regional Waste District is responsible for the inspection, approval of materials, and installation techniques only. All costs for materials and installation and any liabilities resulting from same is the sole responsibility of the property owner.

I have read and fully understand the above provisions and agree to comply by said provisions.

APPLICANT(S) SIGNATURE

North
Buildings

(Dollar General)

INSPECTOR B

Date inspected 10-1-98 Approved / Rejected _____

Reason for rejection _____

Date reinspected _____ Approved _____ Rejected _____

Notes:

Size Pipe 6"

Type Pipe SDR35

Basement Yes _____ No ☒

Sump Pump Yes _____ No ☒

Downspout to Ground Yes ☒ No _____


Septic Tank Pumped & filled Yes _____ No _____

Contractor M&M

Special Conditions _____

Existing Home _____

New Construction ☒

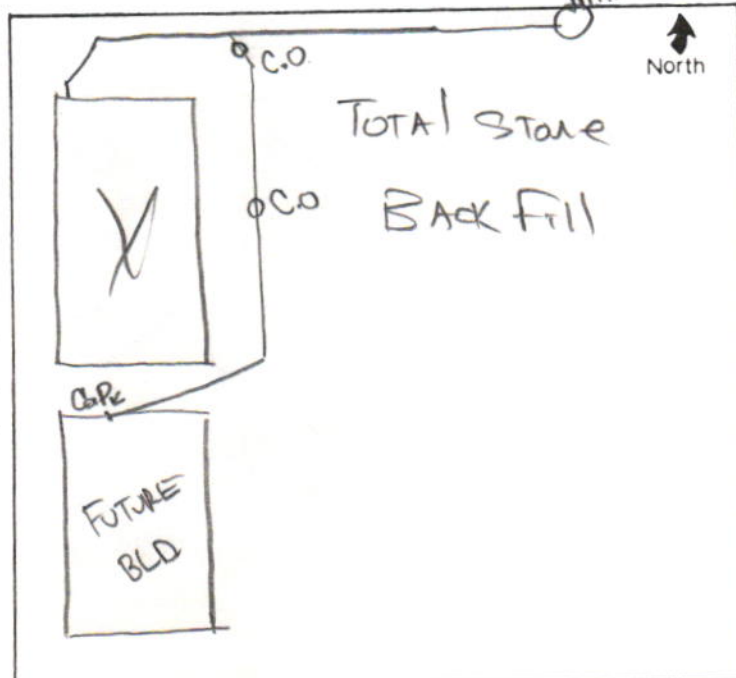



FALL CREEK REGIONAL WASTE DISTRICT

9378 S. 650 West PO Box 59
Pendleton, IN 46064-0059 778-7544

APPLICATION FOR SEWER PERMIT

Nº 2529

Date 6/16/98

Permit Void 90 days from Date of Issuance

Owner Name Chuck Clwenger

Property Address Falls Park Plaza II

Lot # _____ P.O. Box _____

Town Pendleton, IN Zip Code 46064

Phone _____ City Water ☒ Well _____

\$ 400 Tap on Fee Paid

\$ 32,300 capacity ~~inspection~~ fee paid

Application is hereby made for connection to the Fall Creek Regional Waste District Sewer System for the above listed property - Permit Type: Residential _____, Commercial ☒, Industrial _____, or Governmental/Institutional _____. User Information _____.

All workmanship and materials shall conform to the standards of the District Ordinance as described in Ordinance 84-2 and 84-3 as amended. Acceptance and approval must be made by the District inspector or his duly authorized representative before backfilling and final connection is made to the main sewer lines. Any violation of applicable regulations will cause all lines and appurtenances in violation to be removed and replaced at the owners expense.

The Fall Creek Regional Waste District is responsible for the inspection, approval of materials, and installation techniques only. All costs for materials and installation and any liabilities resulting from same is the sole responsibility of the property owner.

I have read and fully understand the above provisions and agree to comply by said provisions.

APPLICANT(S) SIGNATURE

INSPECTOR FRED

Date inspected 7/13/98 Approved ☒ Rejected _____
Reason for rejection _____

Date reinspected _____ Approved _____ Rejected _____

Notes:

Size Pipe 6"

Type Pipe PVC

Basement Yes _____ No ☒

Sump Pump Yes _____ No ☒

Downspout to Ground Yes NA No _____

Septic Tank Pumped & filled Yes NA No _____


Contractor MJM ETC INC

Special Conditions (Partial lateral

Run for future Bldgs)

Existing Home _____

New Construction ☒

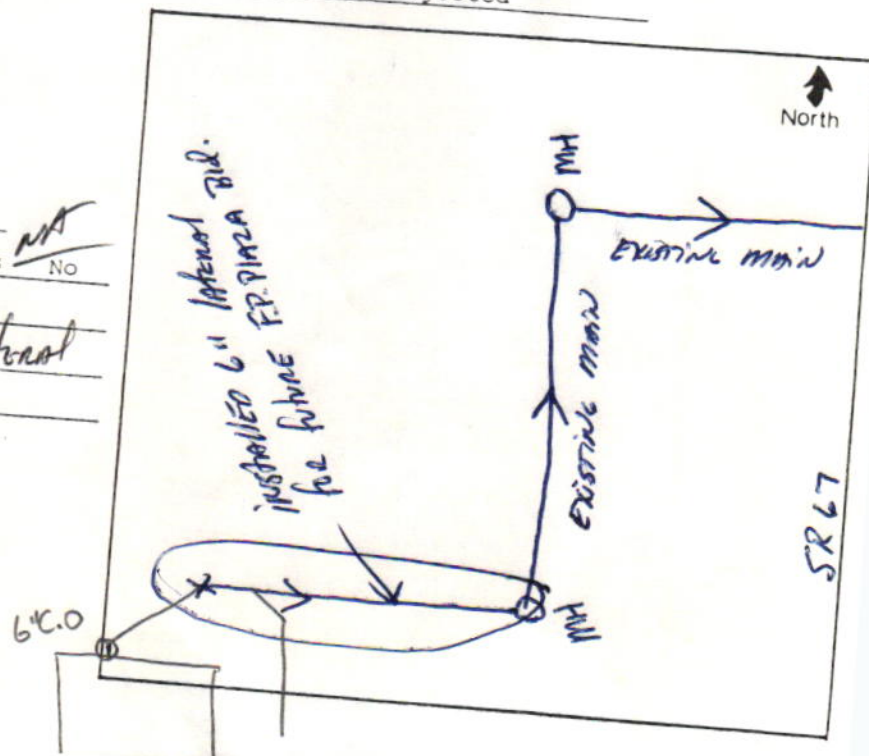

DOCUMENT CONTAINS COLORED BACKGROUND ON WHITE PAPER. "VOID" ANTI-COPY FEATURE. "VERIFICATION BOX" (TO RIGHT OF ARROW, HOLD BETWEEN THUMB AND FOREFINGER, OR BREATHE ON IT, COLOR WILL DISAPPEAR, THEN REAPPEAR)

BANK CASHIER'S CHECK

71-553
749

136367

PENDLETON, IN JUN 16, 1998

REMITTED BY

Pay to the order of

FALL CREEK REGIONAL WASTE

FALL CREEK REGIONAL WASTE

\$32,700.00

32,700 DOLLARS AND 00 CENTS



Pendleton
Banking Company
PENDLETON, INDIANA 46064

Jenna D Watts A.V.P.

PRESIDENT-CASHIER

DOCUMENT ALSO CONTAINS SIMULATED WATERMARK (REVERSE SIDE), FLUORESCENT FIBRES, MICRO-PRINT BORDER AND SIGNATURE LINE READ: "PENDLETON BANKING COMPANY" (USE MAGNIFIER). DO NOT CASH IF ANY FEATURE IS MISSING!

⑈ 136367 ⑈ ⑆074905539⑆