


Falls Park Plaza
& Water St

(Godbey) Ring **I**mplement.

Inspected 9-8-95
by Tim McGurk

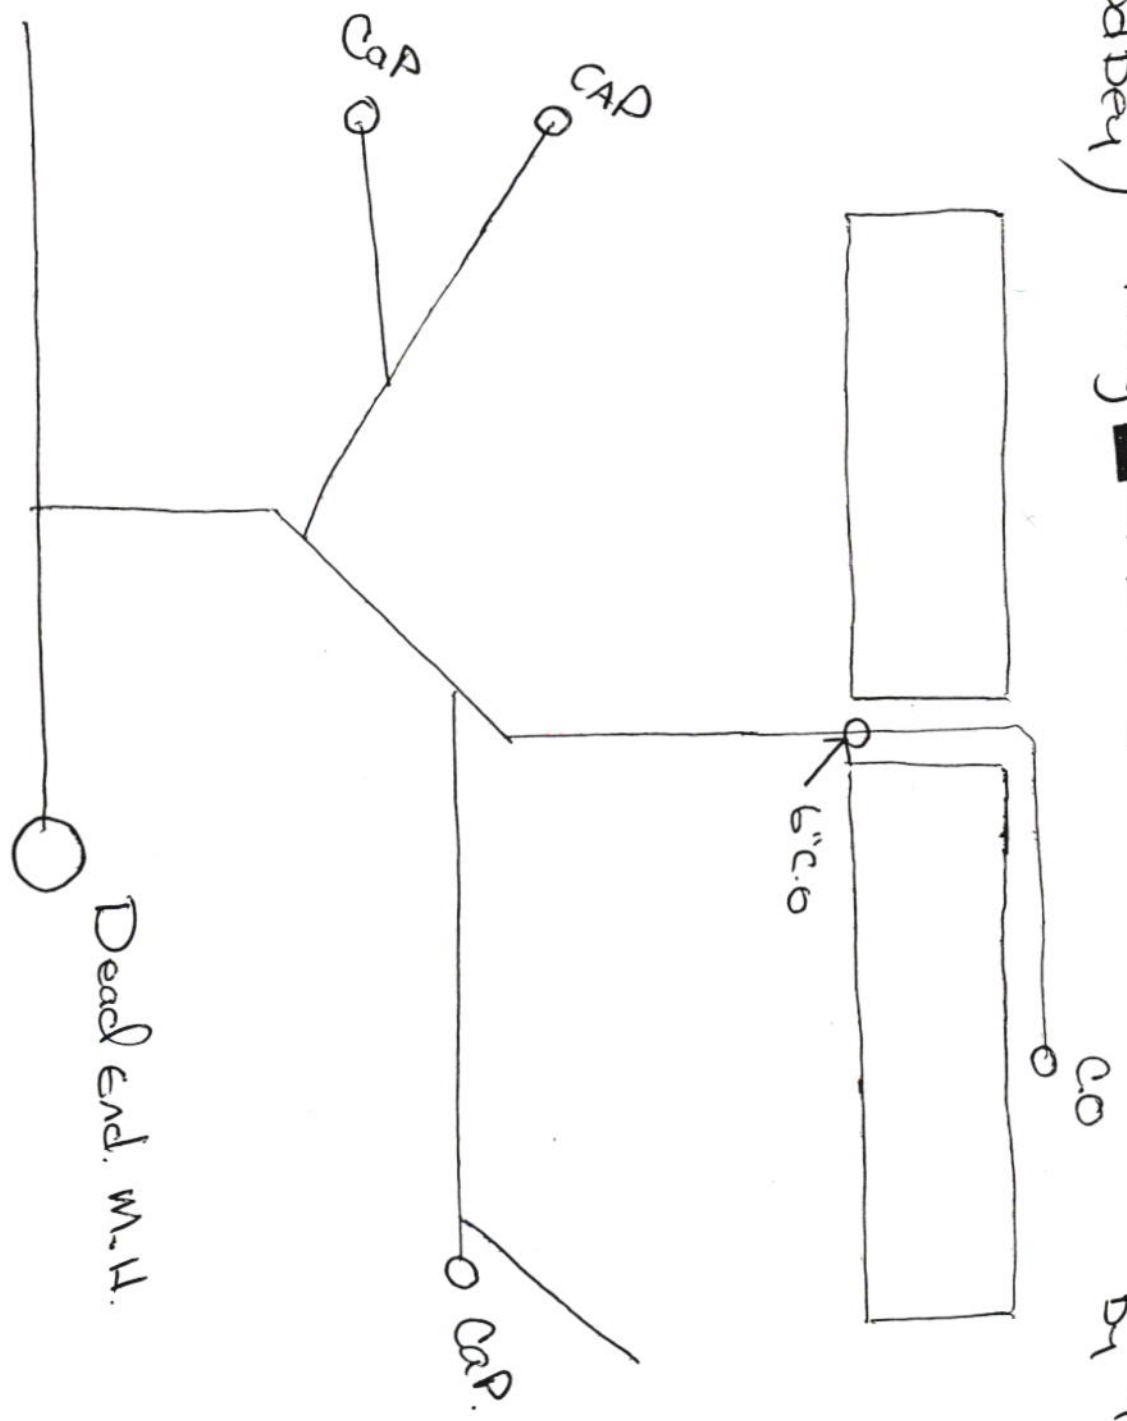

N →

East Water

Dead end. M.H.

S.R. 67