

27-00500.00

4740

FALL CREEK REGIONAL WASTE DISTRICT

9378 S 650 WEST, P.O. BOX 59, PENDLETON, IN 46064

765-778-7544

AGREEMENT FOR SANITARY SEWER SERVICE

This Agreement made and entered into this 13 day of April, 2000, between FALL CREEK REGIONAL WASTE DISTRICT ("District") and State Highway Manager ("Applicant") regarding the provision of sanitary sewer service, and the assignment of capacity in, and connection to, the District's facilities for the premises located at S.R. 13 & 69.

NOW THEREFORE, the parties, in consideration of the mutual promises set out in this Agreement, the receipt and sufficiency of which is hereby acknowledged, agree as follows:

1. The Applicant agrees that all workmanship and materials shall conform to all District ordinances and the District's construction standards. District must accept and approve all work and materials before backfilling and final connection is made to the sewer mains. Any violation of this provision will cause all lines and appurtenances in violation to be removed and replaced at the Applicant's expense.
2. The District shall have the right to enter upon the Applicant's premises at all reasonable times to inspect, repair, or replace any equipment used in connection with the District's service or which has an impact on said service.
3. The Applicant shall be responsible for all monthly user rates, capacity charges, and tap fees. The failure to pay any rate charge or fee may result in a lien against the property and/or the termination of service to the property, the cost of which will be borne by Applicant, including, but not limited to, all attorney's fees and collection costs.
4. The District shall not be responsible for any damages as a result of any failure to supply service unless said damages are due to default, neglect or culpability on the part of the District.
5. If there is an available sanitary sewer within three hundred (300) feet of the property line, the property owner shall be required to connect to the District's sanitary sewer system.
6. The Applicant and District agree that the provision of sanitary sewer service touches and concerns the property and the terms of this Agreement bind the District and Applicant and their heirs, executors, administrators, personal representatives, successors, agents, attorneys, assigns, designees, and transferees.

The parties hereto have read and fully understand the above provisions and agree to comply with said provisions.

FALL CREEK REGIONAL WASTE DISTRICT

APPLICANT

Signature

Signature

STATE OF INDIANA)
) SS:
COUNTY OF MADISON)

SUBSCRIBED and sworn to before me this 13 day of April, 2000.

My Commission Expires:

Signature

Printed

Notary Public
Resident of Madison County

INSPECTOR Steve DATE INSPECTED 1-8-03 APPROVED ✓ REJECTED

REASON FOR REJECTION

DATE REINSPECTED APPROVED REJECTED

NOTES: 1/2 4"
SIZE PIPE TYPE PIPE 160/35

BASEMENT YES (NO)

SUMP PUMP YES (NO)

DOWNSPOUT TO GROUND (YES) NO


SEPTIC TANK PUMPED & FILLED YES NO

CONTRACTOR STATE LANE

SPECIAL CONDITIONS

EXISTING HOME

NEW CONSTRUCTION

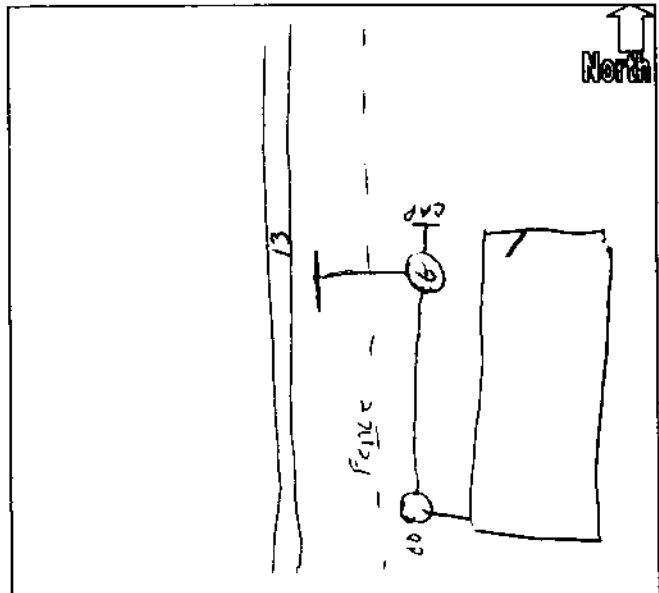



FALL CREEK REGIONAL WASTE DISTRICT

P.O. Box 59 • 9378 S. 650 West • Pendleton, Indiana 46064-0059 • (765) 778-7544

January 13, 2003

Mr. Tom Vanderpool
Indiana Department of Transportation
32 South Broadway
Greenfield, IN 46140

Re: Sewer Service to INDOT Facility at
State Road 13 and I-69 in Madison County, Indiana

Dear Mr. Vanderpool:

Pursuant to the Sewer Line Extension Agreement between Fall Creek Regional Waste District, please find attached the actual project costs in the amount of \$56,571.48 to extend FCRWD's existing sewer line along SR13 from County Road 800 South, north under Interstate 69, so as to make available sewer utility service, to the premises of property owned by INDOT located approximately 500 feet north of the intersection SR13 and I-69.

Exhibit A of the Sewer Agreement listed the estimated total cost at \$45,519.00. Since the estimated cost is less than the actual cost, FCRWD is billing INDOT for the estimated cost only.

Please consider this as your invoice for \$45,519.00, payable to Fall Creek Regional Waste District.

Please contact our General Manager Joe Rowlett at 765-778-7544 if you have any questions.

Respectfully,

Thomas A. Carr
Utility Supervisor

Attachment

**SANITARY SEWER CONSTRUCTION COSTS
INDOT PROJECT**

Materials	\$16,429.68
Returned Materials (Credit)	-\$1,211.20
Eagle Valley (Labor)	\$19,254.00
All-Bore (Bore under I69 + Casing)	\$11,480.00
All-Bore (Bore under MHP Entrance Drive)	\$1,500.00
Engineering Costs	\$5,460.00
Capacity Fee	\$2,160.00
Tap Fee	\$475.00
Grinder Pump	<u>\$1,024.00</u>
Total Cost	\$56,571.48

FUND/08JECT/CENTER
4000/560300/108030

DATE 03/03/03 WARRANT NO. 18021620
BOLP 0351574166

DATE	INVOICE/CREDIT MEMO	TYPE	DESCRIPTION	GROSS	DISCOUNT	NET
22403	513CV031126 020403			4551900	00	4551900
TOTALS				4551900	000	4551900

State Form 43379 (R/12/99)
APPROVED BY STATE BOARD OF ACCOUNTS
THIS WARRANT VOID AFTER 2 YEARS AFTER DEC. 31 OF THE YEAR OF ISSUE

45,519.00
AUDITOR OF STATE OF INDIANA
STATE HOUSE, INDIANAPOLIS, INDIANA 46204

20103
740
WARRANT NO. 18021620

18021620

PAY FORTY-FIVE THOUSAND FIVE HUNDRED NINETEEN DOLLARS AND NO CENTS

To Treasurer of State

PAY TO THE ORDER OF
FALL CREEK REGIONAL WASTE DIST
PO BOX 59, 9378 S 650 W
PENDLETON IN 46064

DATE 03/03/2003 THE SUM OF 45,519.00

Conrad, Jay Mass
AUDITOR OF STATE

18021620 0740010351 8000000 211