



# FALL CREEK REGIONAL WASTE DISTRICT

Box 44, Pendleton, Indiana 46064

1-0003019.00

Nº 000368

## APPLICATION FOR SEWER PERMIT

Permit No. \_\_\_\_\_ Date 10-23-85  
Permit Void 90 days from Date of Issuance  
Owner Name Ingaels Christian Church  
Property Address Randall St. 102 n Randall  
Lot # \_\_\_\_\_ P.O. Box \_\_\_\_\_  
Town Ingaels, IN Zip Code 46048  
Phone \_\_\_\_\_ Water Meter no"  
\$ 150.00 Tap on Fee Paid  
\$ 25.00 Inspection fee paid

Application is hereby made for connection to the Fall Creek Regional Waste District Sewer System for the above listed property - Permit Type: Residential \_\_\_\_\_, Commercial \_\_\_\_\_, Industrial \_\_\_\_\_, or Governmental/Institutional ✓. User Information \_\_\_\_\_.

All workmanship and materials shall conform to the standards of the District Ordinance as described in Ordinance 84-2 and 84-3 as amended. Acceptance and approval must be made by the District inspector or his duly authorized representative before backfilling and final connection is made to the main sewer lines. Any violation of applicable regulations will cause all lines and appurtenances in violation to be removed and replaced at the owners expense.

The Fall Creek Regional Waste District is responsible for the inspection, approval of materials, and installation techniques only. All costs for materials and installation and any liabilities resulting from same is the sole responsibility of the property owner.

I have read and fully understand the above provisions and agree to comply by said provisions.

Ingaels Christian Church M. Gardiner Deas  
APPLICANT(S) SIGNATURE

\*\*\*\*\*

INSPECTOR Long

Date inspected 11/20/85 Approved ✓ Rejected \_\_\_\_\_

Reason for rejection \_\_\_\_\_

Date reinspected \_\_\_\_\_ Approved \_\_\_\_\_ Rejected \_\_\_\_\_

### Notes:

Size Pipe 6" "

Type Pipe P.V.C

Basement Yes ✓ No \_\_\_\_\_


Sump Pump Yes \_\_\_\_\_ No ✓

Downspout to Ground Yes \_\_\_\_\_ No ✓

Septic Tank Pumped & filled Yes ✓ No \_\_\_\_\_

Contractor FLATFORD

Special Conditions \_\_\_\_\_

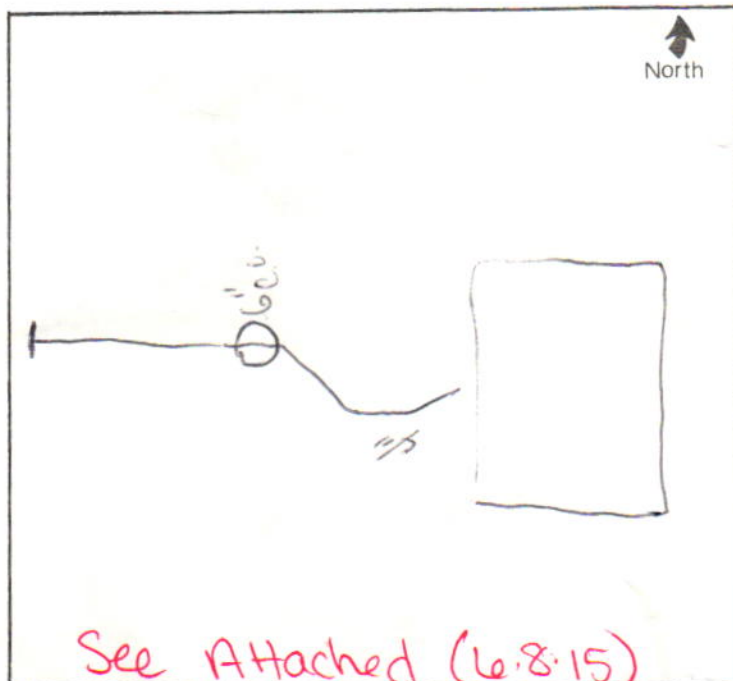

2922

P22

SUBJECT

Tralls Christian Church.



gai consultants

BY

DATE

PROJ. NO.

CHKD. BY

Tim

DATE

6-8-15

SHEET NO.

1

OF

1



4- units  
All Drain To The  
So. West. End of Building

C.O.

Scott Studebaker

Still needs to

Sign agreement  
(6.9.15)

BSH