

FALL CREEK REGIONAL WASTE DISTRICT

9378 S 650 WEST, P.O. BOX 59, PENDLETON, IN 46064

765-778-7544

No 5069

27-10510.00

AGREEMENT FOR SANITARY SEWER SERVICE

This Agreement made and entered into this 19th day of December, 2003, between FALL CREEK REGIONAL WASTE DISTRICT ("District") and Pilot Travel Centers ("Applicant") regarding the provision of sanitary sewer service, and the assignment of capacity in, and connection to, the District's facilities for the premises located at SR 13 & I-69.

NOW THEREFORE, the parties, in consideration of the mutual promises set out in this Agreement, the receipt and sufficiency of which is hereby acknowledged, agree as follows:

1. The Applicant agrees that all workmanship and materials shall conform to all District ordinances and the District's construction standards. District must accept and approve all work and materials before backfilling and final connection is made to the sewer mains. Any violation of this provision will cause all lines and appurtenances in violation to be removed and replaced at the Applicant's expense.
2. The District shall have the right to enter upon the Applicant's premises at all reasonable times to inspect, repair, or replace any equipment used in connection with the District's service or which has an impact on said service.
3. The Applicant shall be responsible for all monthly user rates, capacity charges, and tap fees. The failure to pay any rate charge or fee may result in a lien against the property and/or the termination of service to the property, the cost of which will be borne by Applicant, including, but not limited to, all attorney's fees and collection costs.
4. The District shall not be responsible for any damages as a result of any failure to supply service unless said damages are due to default, neglect or culpability on the part of the District.
5. If there is an available sanitary sewer within three hundred (300) feet of the property line, the property owner shall be required to connect to the District's sanitary sewer system.
6. The Applicant and District agree that the provision of sanitary sewer service touches and concerns the property and the terms of this Agreement bind the District and Applicant and their heirs, executors, administrators, personal representatives, successors, agents, attorneys, assigns, designees, and transferees.

The parties hereto have read and fully understand the above provisions and agree to comply with said provisions.

FALL CREEK REGIONAL WASTE DISTRICT

Signature

APPLICANT

Signature

STATE OF INDIANA)
) SS:
COUNTY OF MADISON)

SUBSCRIBED and sworn to before me this _____ day of _____, 200 ____.

My Commission Expires:

Signature

Printed

Notary Public
Resident of Madison County

INSPECTOR T DATE INSPECTED 4-26-07 APPROVED / REJECTED /

REASON FOR REJECTION

DATE REINSPECTED _____ APPROVED _____ REJECTED _____

NOTES:

SIZE PIPE 4" TYPE PIPE sch 40

BASEMENT YES / NO /

SUMP PUMP YES / NO /

DOWNSPOUT TO GROUND YES / NO /


SEPTIC TANK PUMPED & FILLED YES NA NO /

CONTRACTOR SELF

SPECIAL CONDITIONS Duplex Grinder

EXISTING HOME / Zoller

NEW CONSTRUCTION /

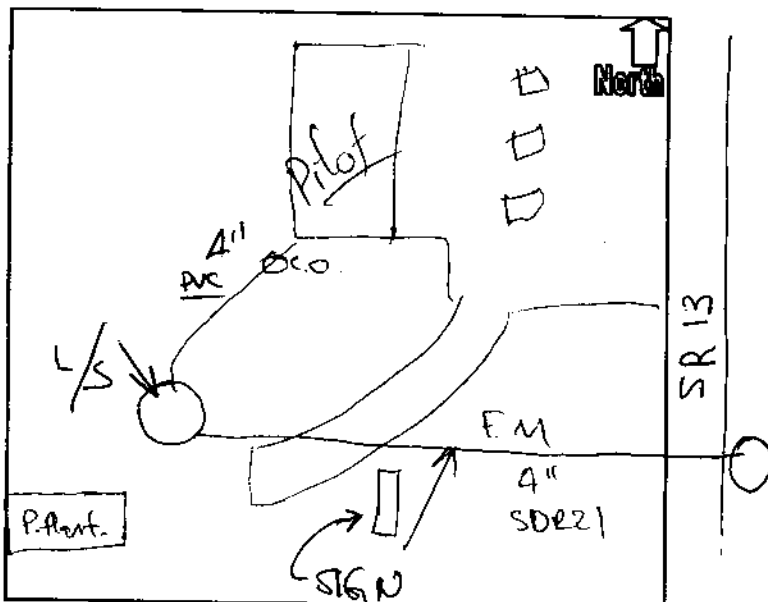

1671901	12/16/03	13435.00	0.00	13435.00
Pilot Travel Centers Knoxville, TN 37939		13435.00	0.00	13435.00

Please Carefully Fold, Crease, and Tear Along Perforation Before Depositing

WARNING: THE FACE OF THIS DOCUMENT HAS A COLORED BACKGROUND - NOT A WHITE BACKGROUND

Pilot Travel Centers LLCP.O. Box 10146
Knoxville, TN 37939-0146
(865) 588-7487**Pilot**AM South
Knoxville, TN
Check Date

12/16/03

807-307
641Check No.
1671901

Vendor No. 43303

Amount
\$ *****13,435.00

PAY THIRTEEN THOUSAND FOUR HUNDRED THIRTY-FIVE AND 00/100

DOLLARSPAY
TO THE
ORDER
OFFALL CREEK REGIONAL WASTE DIST
P O BOX 59
PENGLETON IN 46064-0059Pilot Travel Centers - Accounts Payable Account
Jeffrey S. Carrick
Authorized Signature

PHOTOCOPYING THIS DOCUMENT WILL PRODUCE WORD VOID IN BACKGROUND

⑈01671901⑈ ⑆064103079⑆ 1000080210⑈

**Pilot Travel Centers LLC**
P.O. Box 10146
Knoxville, TN 37939-0146

Vendor No. 43303

FALL CREEK REGIONAL WASTE DIST
P O BOX 59
PENGLETON IN 46064-0059SEE REVERSE SIDE FOR
OPENING INSTRUCTIONS

OPENING INSTRUCTIONS