

2:30

flatford 2-2:30
9-4-85



FALL CREEK South Broadway DISTRICT
Box 44, from 67 2 6064
house on right

Bill to
Alice Humphrey
R2, Box 327

APPLICATION FOR SEWER PERMIT

Nº 000114

Permit No. _____ Date 8-20-85 3-0001260

Permit Void 90 days from Date of Issuance

Owner Name Paul H. Freyhard, Jr. (253-5409)

Property Address R2, Box 327,

Lot # _____ P.O. Box _____

Town Perinton, IN Zip Code 46064

Phone _____ Water Meter Yes

\$ 150.00 Tap on Fee Paid

\$ 25.00 Inspection fee paid

Application is hereby made for connection to the Fall Creek Regional Waste District Sewer System for the above listed property - Permit Type: Residential ☒, Commercial _____, Industrial _____, or Governmental/Institutional _____. User Information _____.

All workmanship and materials shall conform to the standards of the District Ordinance as described in Ordinance 84-2 and 84-3 as amended. Acceptance and approval must be made by the District inspector or his duly authorized representative before backfilling and final connection is made to the main sewer lines. Any violation of applicable regulations will cause all lines and appurtenances in violation to be removed and replaced at the owners expense.

The Fall Creek Regional Waste District is responsible for the inspection, approval of materials, and installation techniques only. All costs for materials and installation and any liabilities resulting from same is the sole responsibility of the property owner.

I have read and fully understand the above provisions and agree to comply by said provisions.

APPLICANT(S) SIGNATURE


INSPECTOR T.M.

Date inspected 9-4-85 Approved ☒ Rejected _____

Reason for rejection _____

Date reinspected _____ Approved _____ Rejected _____

Notes:
Size Pipe 6"
Type Pipe PVC
Basement Yes ☒ No ☒
Sump Pump Yes ☒ No ☒
Downspout to Ground Yes ☒ No ☒
Septic Tank Pumped & filled Yes ☒ No ☒
Contractor FLATORD
Special Conditions NO DOWNSPOUT
DRAINS

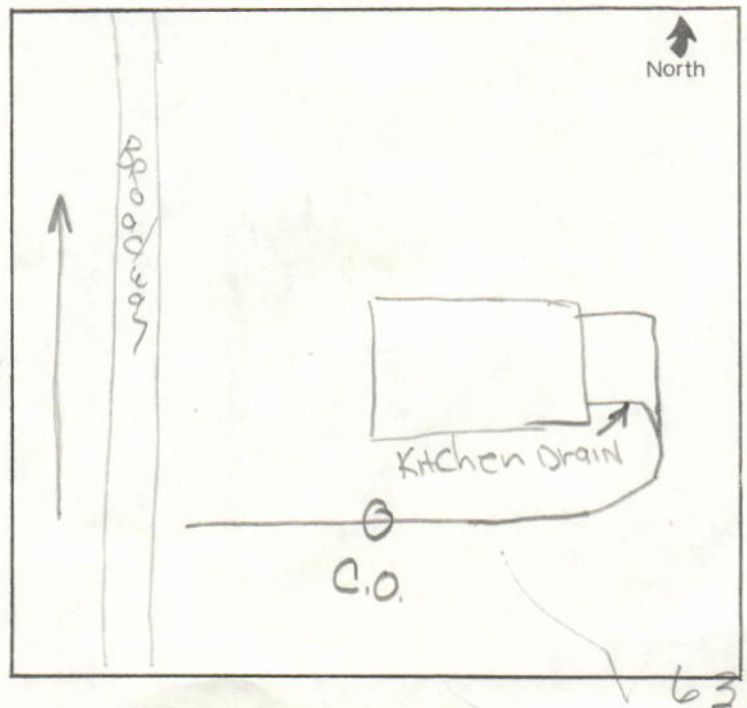

PAUL H. JEZZARD, JR.
8143 NORTH OAKLAND ROAD
INDIANAPOLIS, INDIANA 46240

August 19, 1985

*This letter
stays in
the office,
don't take
on inspection*

Fall Creek Regional Waste District
P.O. Box 59
Pendleton, IN 46064

Dear Sirs:

The attached check is to cover the tap-on fee of \$150.00 and inspection fee of \$25.00 for rental residential property which I co-own with Jos. P. Miller.

Our property is located on the east side of south Broadway at the edge of Pendleton. Legal description of the property is: Board of Trade, 1st Addn., Block 05, Lot 001.

Payment of the monthly sanitary service fee will be the responsibility of our tenant. Mailing address of the residence for billing the monthly charge is: RR 2, Box 327, Pendleton, IN 46064. Alice Humphrey is our tenant.

Please mail the permit for tap-on and any other documents related to hooking-up to my attention at the above Indianapolis address. My phone number is 1-253-5409.

Arrangements will be made with approved sewer contractor upon receipt of tap-on authorization from your office.

For your further information should the address of Jos. P. Miller be of necessity, it is: c/o Jasper State Bank P.O. Box 195, Jasper, IN 47546. Phone 812-482-3800.

Very truly yours,


Paul H. Jezard, Jr.

Attachment
cc: Jos. P. Miller