



FALL CREEK REGIONAL WASTE DISTRICT  
Box 44, Pendleton, Indiana 46064

No 001599

APPLICATION FOR SEWER PERMIT

Permit No. \_\_\_\_\_ Date 11-6-86  
Permit Void 90 days from Date of Issuance  
Owner Name Dick Godbey  
Property Address RR # 3 Madison Ave.  
Lot # \_\_\_\_\_ P.O. Box \_\_\_\_\_  
Town Pendleton, IN Zip Code 46064  
Phone \_\_\_\_\_ Water Meter \_\_\_\_\_  
\$ 500.00 (See attached invoice) Tap on Fee Paid  
\$ 25.00 Inspection fee paid

Application is hereby made for connection to the Fall Creek Regional Waste District Sewer System for the above listed property - Permit Type: Residential ☒, Commercial \_\_\_\_\_, Industrial \_\_\_\_\_, or Governmental/Institutional \_\_\_\_\_. User Information \_\_\_\_\_.

All workmanship and materials shall conform to the standards of the District Ordinance as described in Ordinance 84-2 and 84-3 as amended. Acceptance and approval must be made by the District inspector or his duly authorized representative before backfilling and final connection is made to the main sewer lines. Any violation of applicable regulations will cause all lines and appurtenances in violation to be removed and replaced at the owners expense.

The Fall Creek Regional Waste District is responsible for the inspection, approval of materials, and installation techniques only. All costs for materials and installation and any liabilities resulting from same is the sole responsibility of the property owner.

I have read and fully understand the above provisions and agree to comply by said provisions.

APPLICANT(S) SIGNATURE


\*\*\*\*\*

INSPECTOR Bex

Date inspected 10-15-86 Approved ☒ Rejected \_\_\_\_\_  
Reason for rejection \_\_\_\_\_

Date reinspected \_\_\_\_\_ Approved \_\_\_\_\_ Rejected \_\_\_\_\_

Notes:  
Size Pipe 6"  
Type Pipe PVC  
Basement Yes \_\_\_\_\_ No ☒  
Sump Pump Yes \_\_\_\_\_ No ☒  
Downspout to Ground Yes ☒ No \_\_\_\_\_  
Septic Tank Pumped & filled Yes ☒ No \_\_\_\_\_  
Contractor Dick Godbey  
Special Conditions New Connection

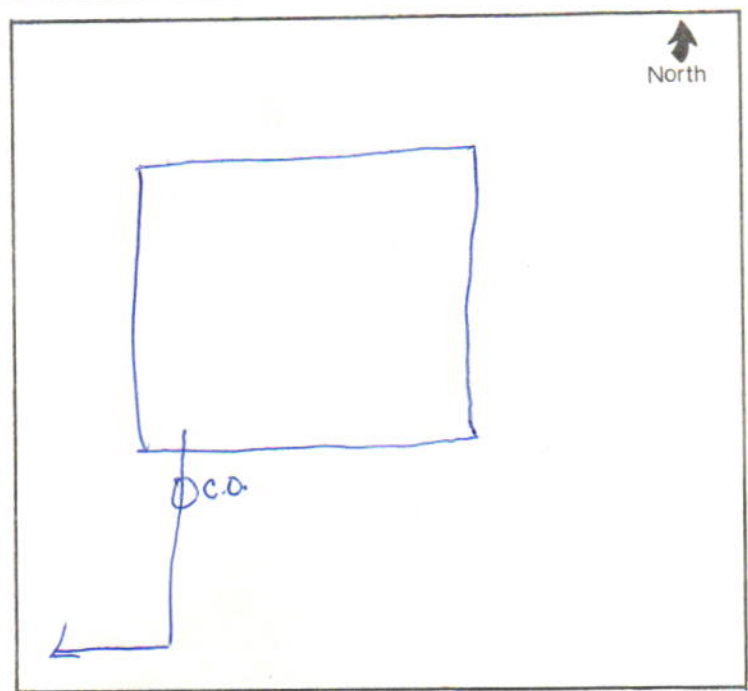

**RICHARD L. GODBEY**  
General Construction  
RR #2 Box 317a  
PENDLETON, INDIANA 46064

# INVOICE

1367

TO FCRWD  
RR #1  
Pendleton In

DATE

10/31/86

CUSTOMER ORDER NO.

SALESPERSON

VIA

TERMS:

QUANTITY	DESCRIPTION	PRICE	AMOUNT	
	Sewer Tap RR#3 Madison Ave		280	00
	Sewer Tap 300 Block South Main		220	00
			<hr/>	
			500	00

ORIGINAL

Thank You!

\*\*\*\*\*

INSPECTOR SB

Date inspected 10-15-86 Approved ✓ Rejected \_\_\_\_\_

Reason for rejection \_\_\_\_\_

Date reinspected \_\_\_\_\_ Approved \_\_\_\_\_ Rejected \_\_\_\_\_

Notes:

Size Pipe 6 "

Type Pipe PVC

Basement Yes \_\_\_\_\_ No X

Sump Pump Yes \_\_\_\_\_ No X

Downspout to Ground Yes X No \_\_\_\_\_

Septic Tank Pumped & filled Yes \_\_\_\_\_ No \_\_\_\_\_

Contractor Dick Goby

Special Conditions New Connection

North ↑

