



FALL CREEK REGIONAL WASTE DISTRICT

Box 44, Pendleton, Indiana 46064

APPLICATION FOR SEWER PERMIT

Nº 000018

3-1023392.01

10-23392.01

Permit No. _____ Date _____
Permit Void 90 days from Date of Issuance
Owner Name Bolis Chevrolet
Property Address SR 38 Body Shop
Lot # _____ P.O. Box 117
Town Pendleton, IN Zip Code 46064
Phone _____ Water Meter no
\$ 150.00 Tap on Fee Paid
\$ 25.00 Inspection fee paid

Application is hereby made for connection to the Fall Creek Regional Waste District Sewer System for the above listed property - Permit Type: Residential _____, Commercial ☒, Industrial _____, or Governmental/Institutional _____. User Information _____.

All workmanship and materials shall conform to the standards of the District Ordinance as described in Ordinance 84-2 and 84-3 as amended. Acceptance and approval must be made by the District inspector or his duly authorized representative before backfilling and final connection is made to the main sewer lines. Any violation of applicable regulations will cause all lines and appurtenances in violation to be removed and replaced at the owners expense.

The Fall Creek Regional Waste District is responsible for the inspection, approval of materials, and installation techniques only. All costs for materials and installation and any liabilities resulting from same is the sole responsibility of the property owner.

I have read and fully understand the above provisions and agree to comply by said provisions.

Willie Bolis
APPLICANT(S) SIGNATURE

INSPECTOR BEN

Date inspected 10-14-85 Approved ☒ Rejected _____

Reason for rejection _____

Date reinspected _____ Approved _____ Rejected _____

Notes:

Size Pipe 6"

Type Pipe PVC

Basement Yes _____ No ☒


Sump Pump Yes _____ No ☒

Downspout to Ground Yes ☒ No _____

Septic Tank Pumped & filled Yes ☒ No _____

Contractor Godboy Const

Special Conditions _____

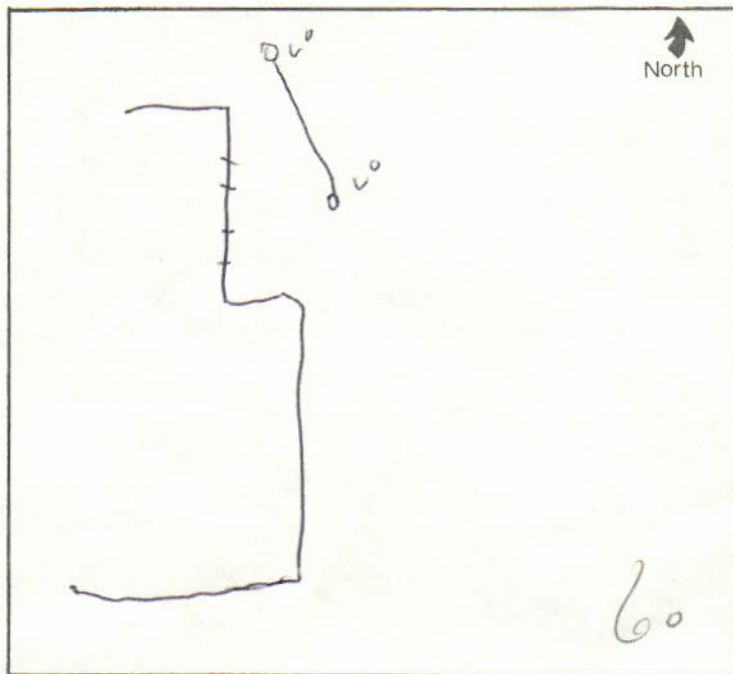

Project Name: boles lateral

Date: 11/21/2016 2:30:00 AM

Asset ID:

Location: heading southeast to bld Upstream MH Number:

Length Surveyed: 182.2

Downstream MH Number:

Run Number:

Direction Of Survey:


Pipe Size:

Pipe Material:

Severity
Light
Moderate
Average
Heavy
Severe

KEEP

SRF PHASE II

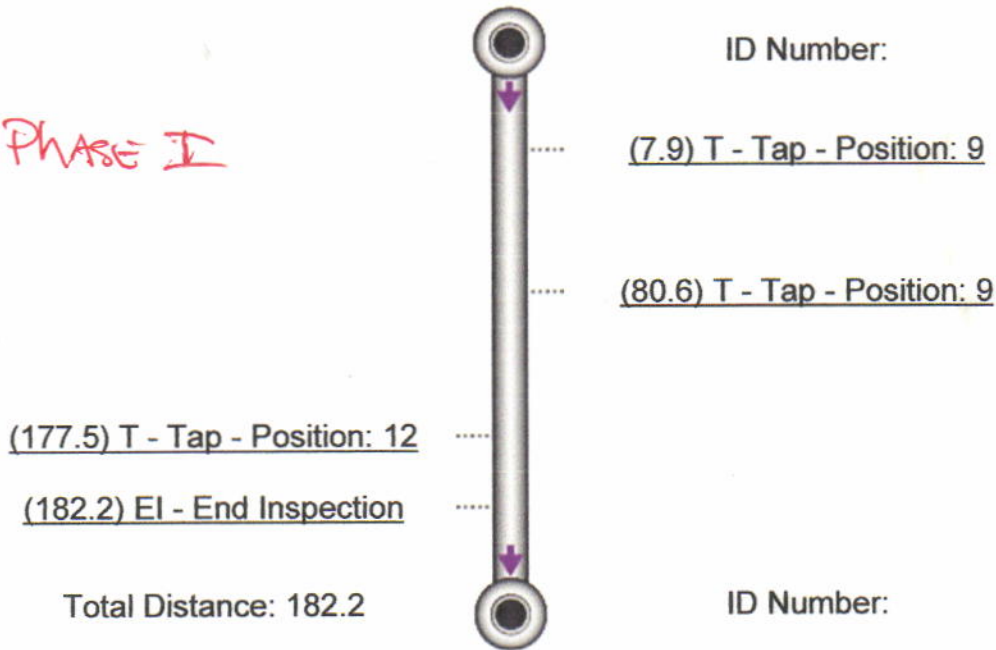

Project Name: boles lateral

Date: 11/21/2016 2:30:00 AM

Location: heading southeast to bld

Length Surveyed: 182.2

Run Number:

Pipe Size:


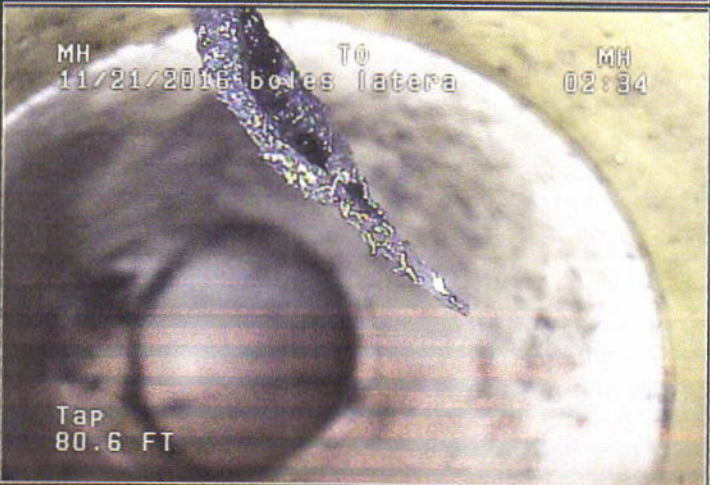
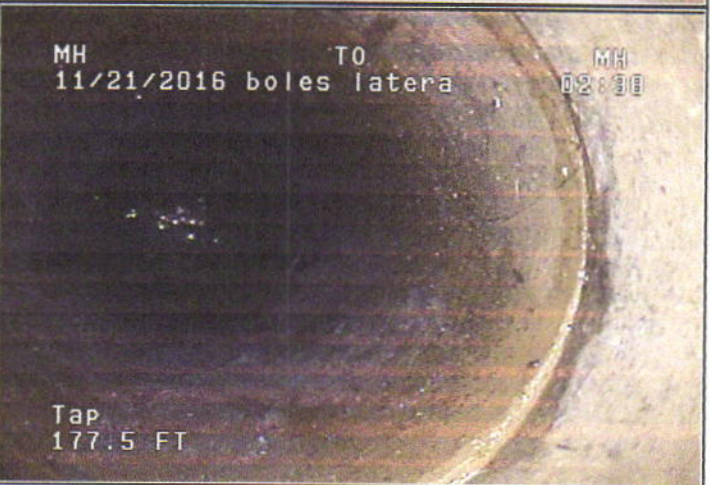
Asset ID:


Upstream MH Number:

Downstream MH Number:

Direction Of Survey:

Pipe Material:

Distance	Fault Observation	Time	Picture
7.9	Tap Position: 9 Severity: None	01:08	
80.6	Tap Position: 9 Severity: None	04:03	
177.5	Tap Position: 12 Severity: None	07:48	

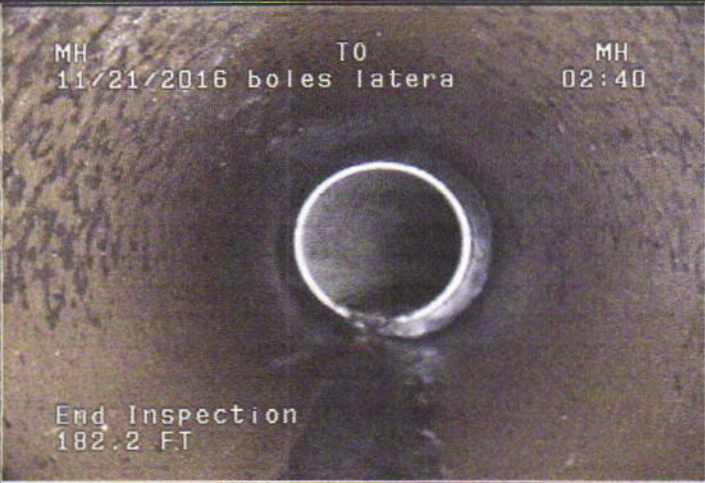Distance	Fault Observation	Time	Picture
182.2	End Inspection Severity: None	09:31	<div> <div>MH</div> <div>11/21/2016</div> <div>boles latera</div> <div>TO</div> <div>MH</div> <div>02:40</div> </div>  <div>End Inspection 182.2 FT</div>



Project

Project Name	boles lateral	Location	heading southeast to bld
Date	11/21/2016 02:30	Direction Of Survey	
City		PO Number	
Run Number		Purpose	
Operator Name		Completed	Yes
Comments			

Pipe

Asset ID		Pipe Size	
Pipe Material		Pipe Shape	
Lining Method		Total Length	
Length Surveyed	182.2	Year Laid	
Year Renewed		Sewer Use	

Manhole

Upstream MH Number		Upstream MH Depth	
UpstreamMH Location		Upstream MH Notes	
Downstream MH Number		Downstream MH Depth	
Downstream MH Location		Downstream MH Notes	
Amount of Flow		Signs Of Surcharge	

Other

Media Number		Truck Number	
Contractor Name		Weather	
VCR Start Index		VCR End Index	