




PROJECT Phase II SHEET _____ OF _____

SUBJECT _____ DATE 8-8-18

JOB NO. 4447

BY Atlas

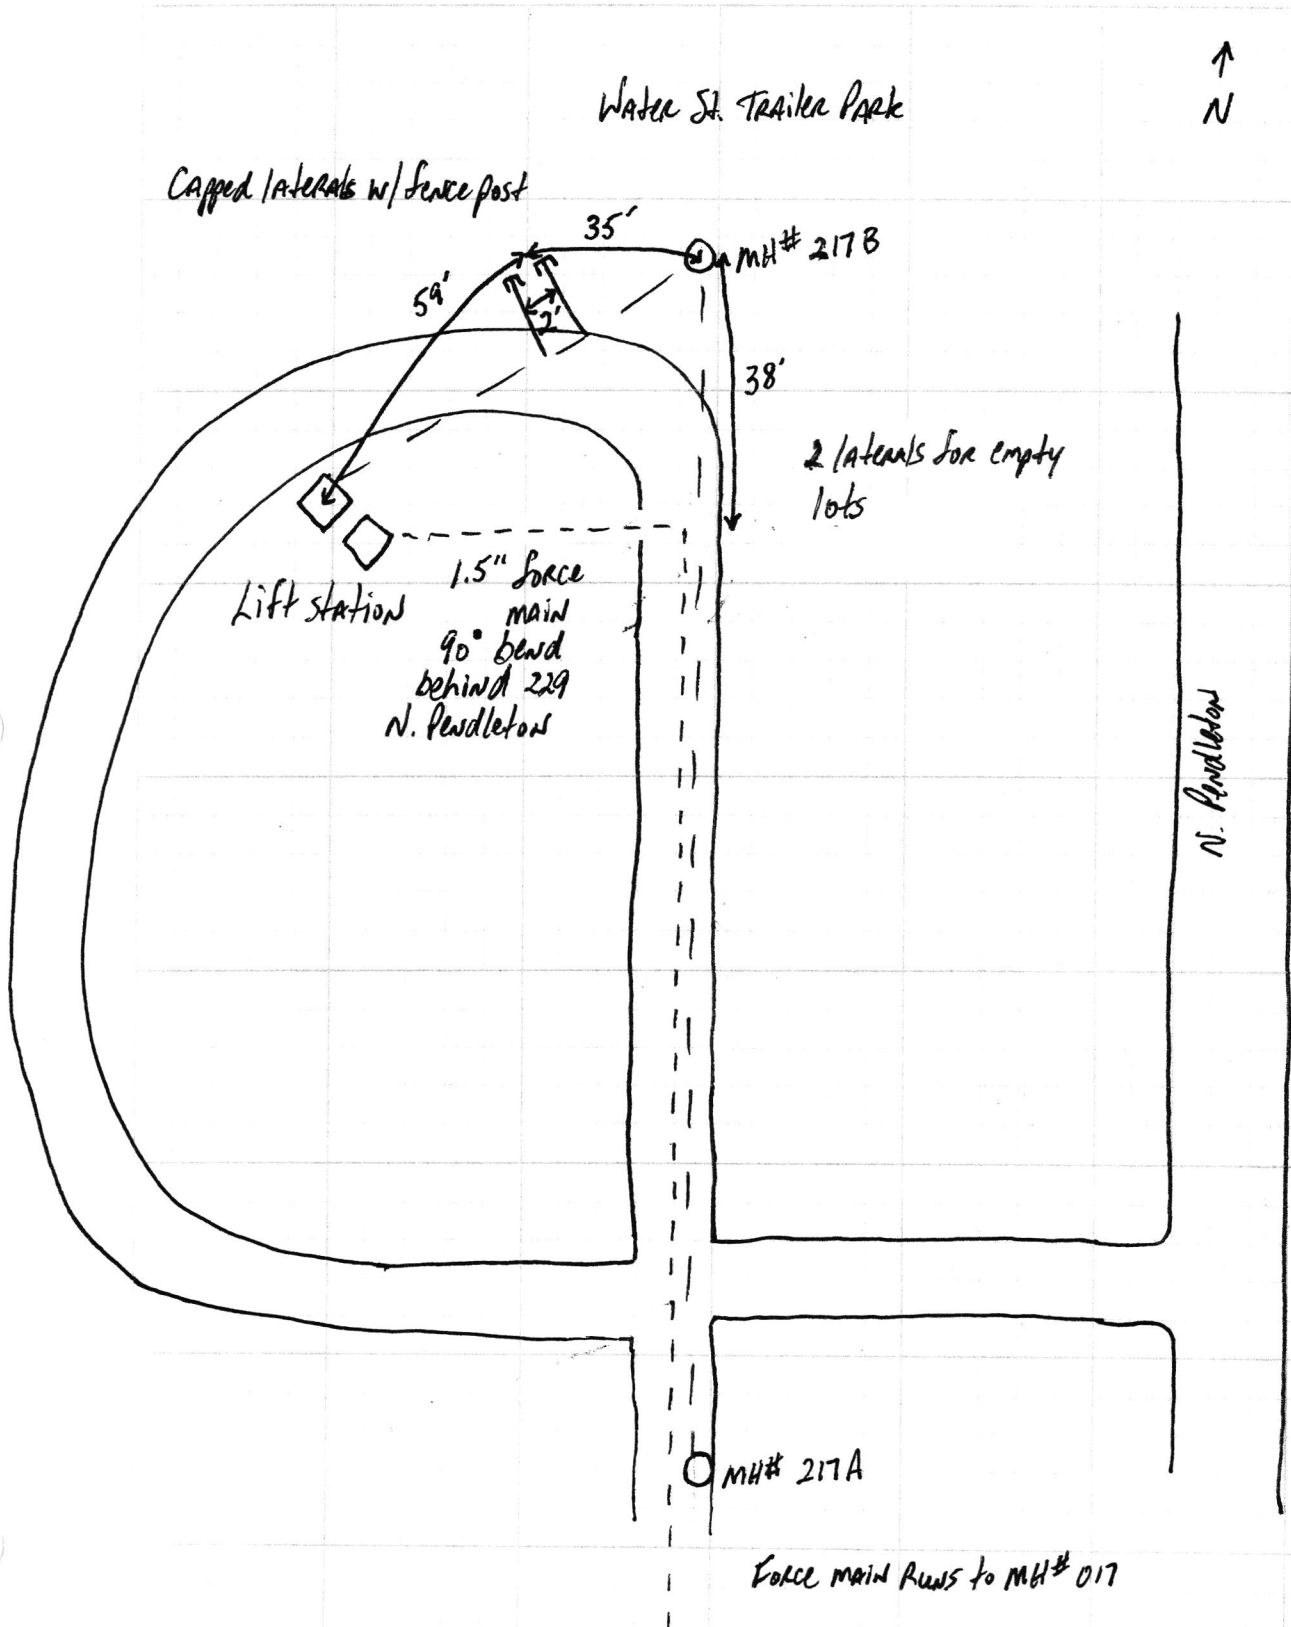



10' in. over water 5' trailer park SRP Phase II 8-15-18