


HOOSIER HILLS REGIONAL WATER DISTRICT

BLOCK HOLLOW SUBDIVISION

WATER MAIN EXTENSION

SITE VICINITY MAP

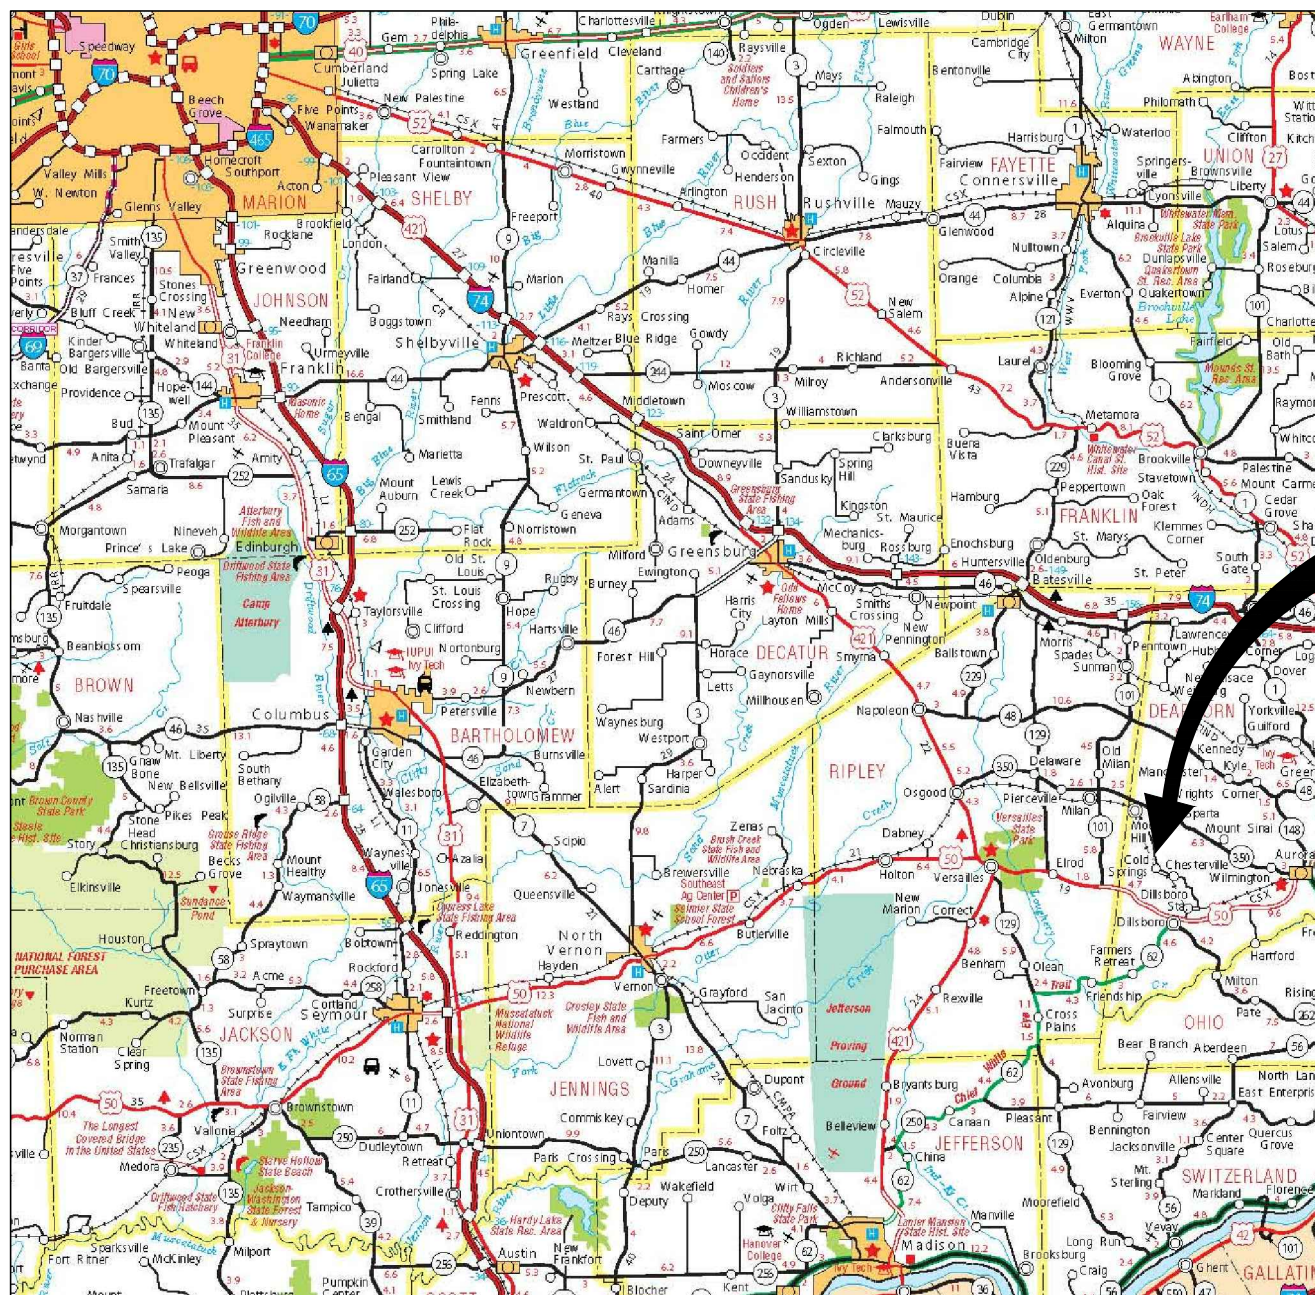

PROJECT LOCATION




GRW Engineers, Inc.
7112 WALDEMAR DRIVE
INDIANAPOLIS, IN. 46268
(317) 347-3650

INDIANAPOLIS, INDIANA
LEXINGTON & LOUISVILLE, KENTUCKY
KNOXVILLE & NASHVILLE, TENNESSEE
ARLINGTON, TEXAS
CINCINNATI, OHIO

INDEX OF DRAWINGS

SHEET NO.	DESCRIPTION
---	COVER SHEET
708	BLOCK HOLLOW SUBDIVISION WATER MAIN EXTENSION

SITE LOCATION MAP

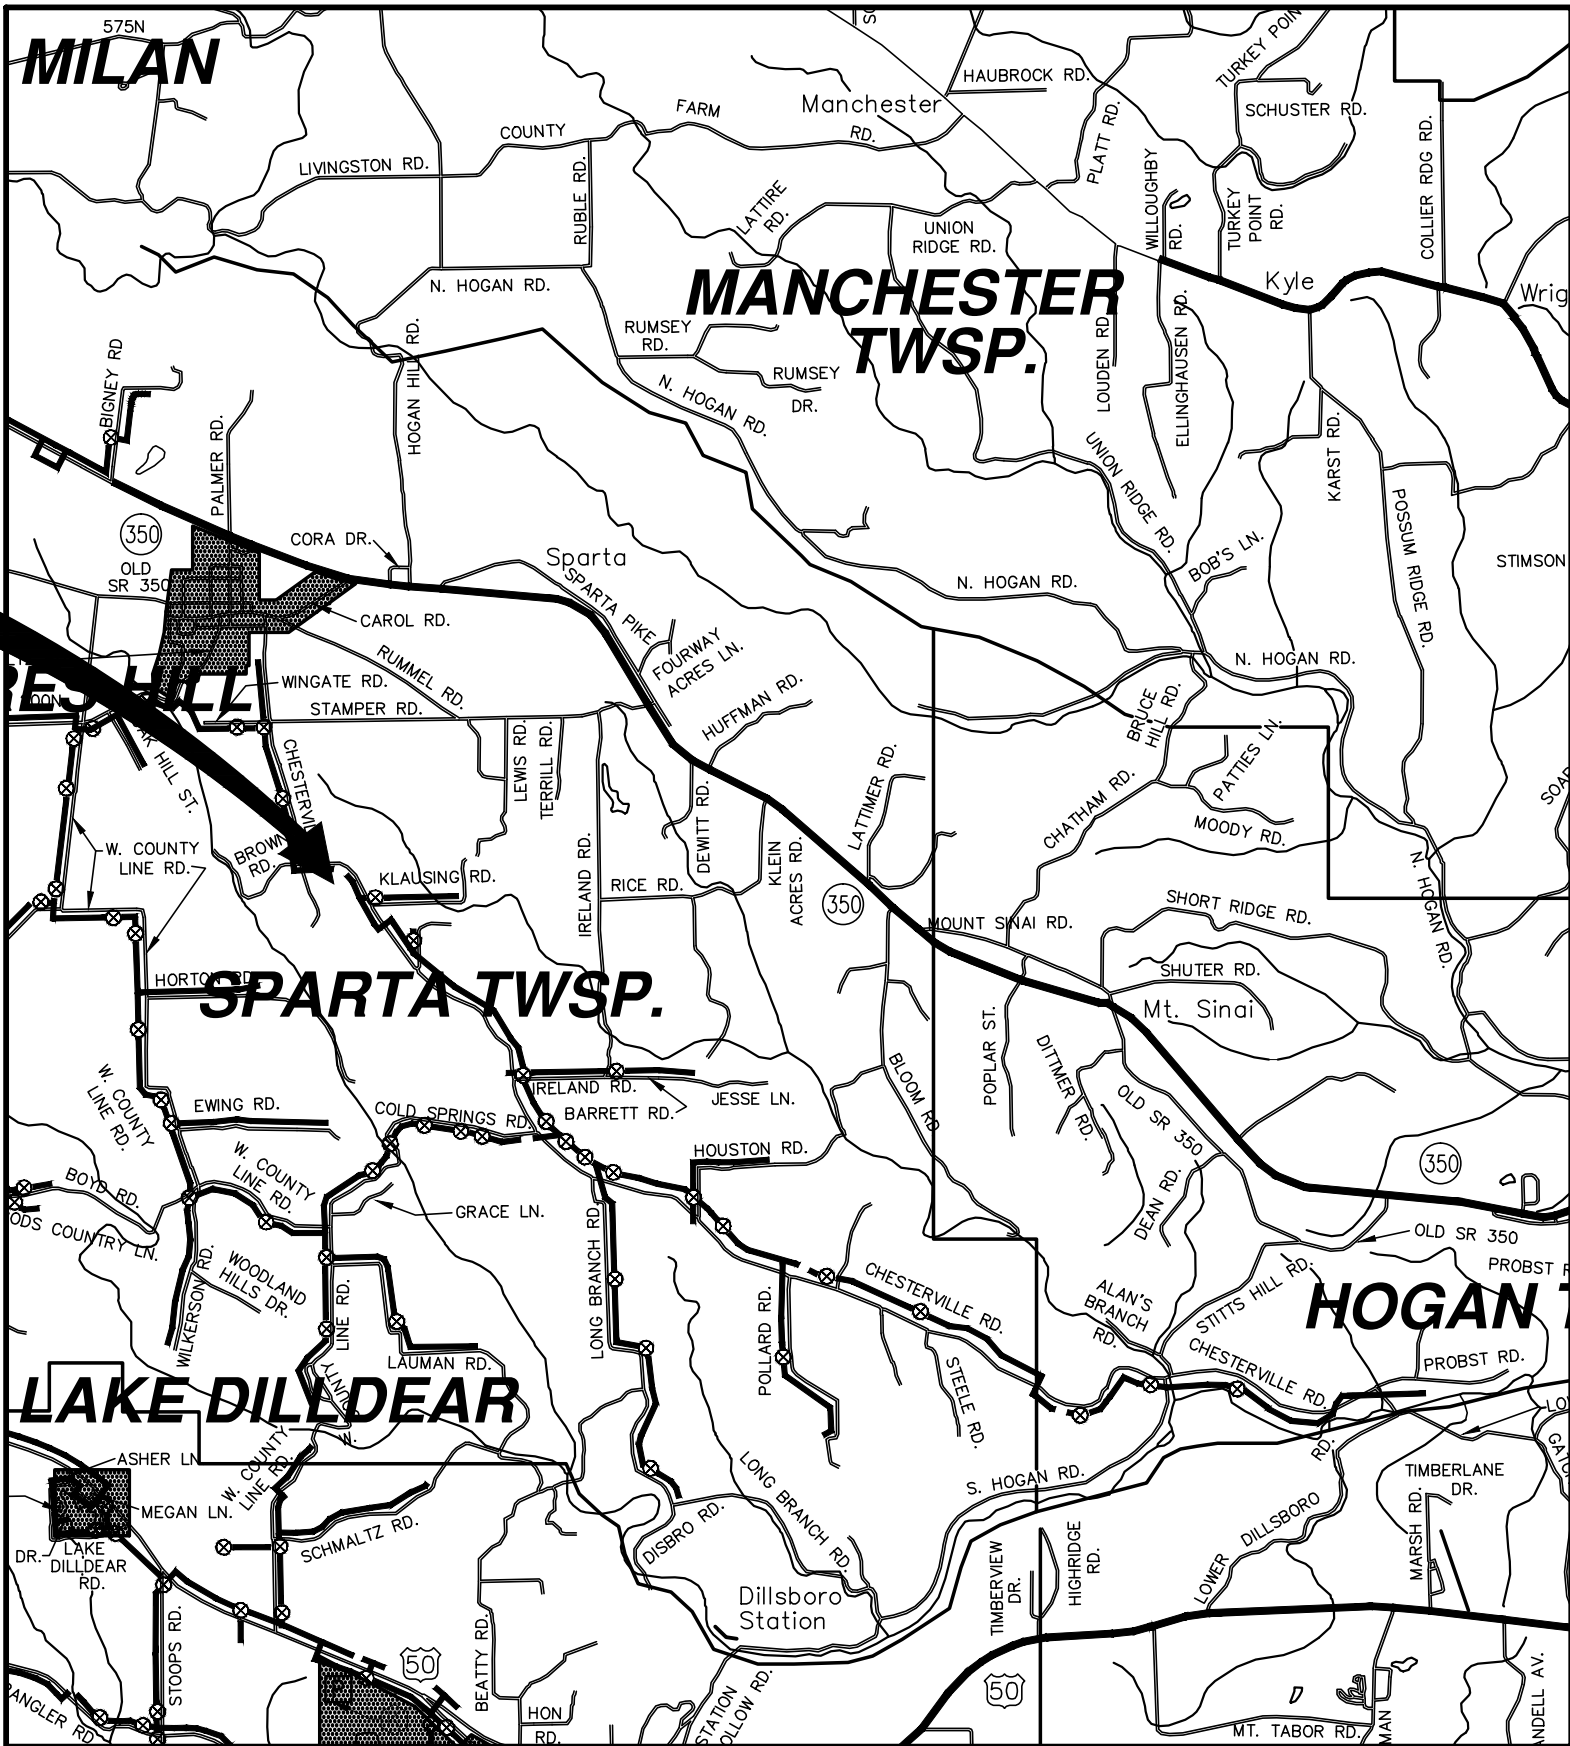


PROPOSED WATER MAIN
IMPROVEMENT LOCATION

RECORD DRAWING


This drawing has been revised from the original contract drawings to show minor/ major changes made during construction. This drawing is not warranted to be complete and accurate in all respects.

GRW Engineers, Inc.

Date: 04-05-10 By: NRE

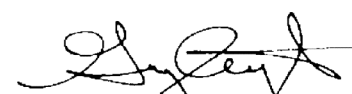
GREGORY A. WRIGHT, P.E.
INDIANA REG. NO. 19300607

DATE 22 APRIL 2004

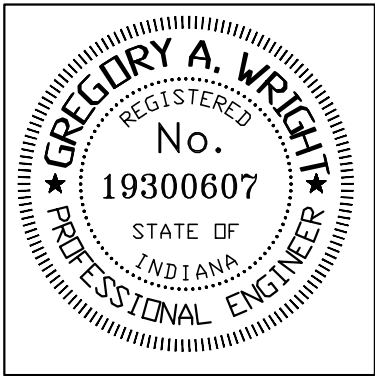

GRW PROJECT NO. 2543-67

APRIL 2004