

RECORD DRAWING

This drawing has been revised from the original contract drawings to show minor / major changes made during construction. This drawing is not warranted to be complete and accurate in all respects.

GRW Engineers, Inc.


Date: 04-05-10 By: NRE

- NOTES:
- 1). THE UTILITIES AND THEIR LOCATION SHOWN ON PLANS ARE APPROXIMATE. CONTRACTOR SHALL VERIFY ALL UTILITIES IN THE FIELD AND NOTIFY ALL UTILITY COMPANIES PRIOR TO INSTALLATION OF THE WATER LINE.
  - 2). ALL PIPING SHALL BE CLASS 200 PVC UNLESS OTHERWISE NOTED.
  - 3). 48" MINIMUM COVER REQUIRED OVER TOP OF WATER LINE.

1	AS-BUILT REVISIONS	04-05-10	NRE
NO.	DESCRIPTION	DATE	BY
REVISIONS			

HOOSIER HILLS REGIONAL  
WATER DISTRICT  
  
BLOCK HOLLOW SUBDIVISION  
WATER MAIN EXTENSION

GRW PROJECT NO. 2543-67

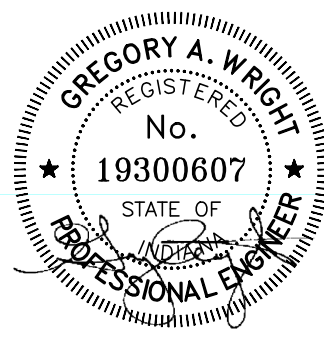

DRAWN: GCR	DATE: APRIL 2004
FILE NAME: SHT708.DWG	SCALE: 1" = 50'
CHECKED:	SHEET NO.
APPROVED:	708