


HOOSIER HILLS REGIONAL WATER DISTRICT COUNTY ROAD 1100 NORTH WATER MAIN EXTENSION


SITE VICINITY MAP

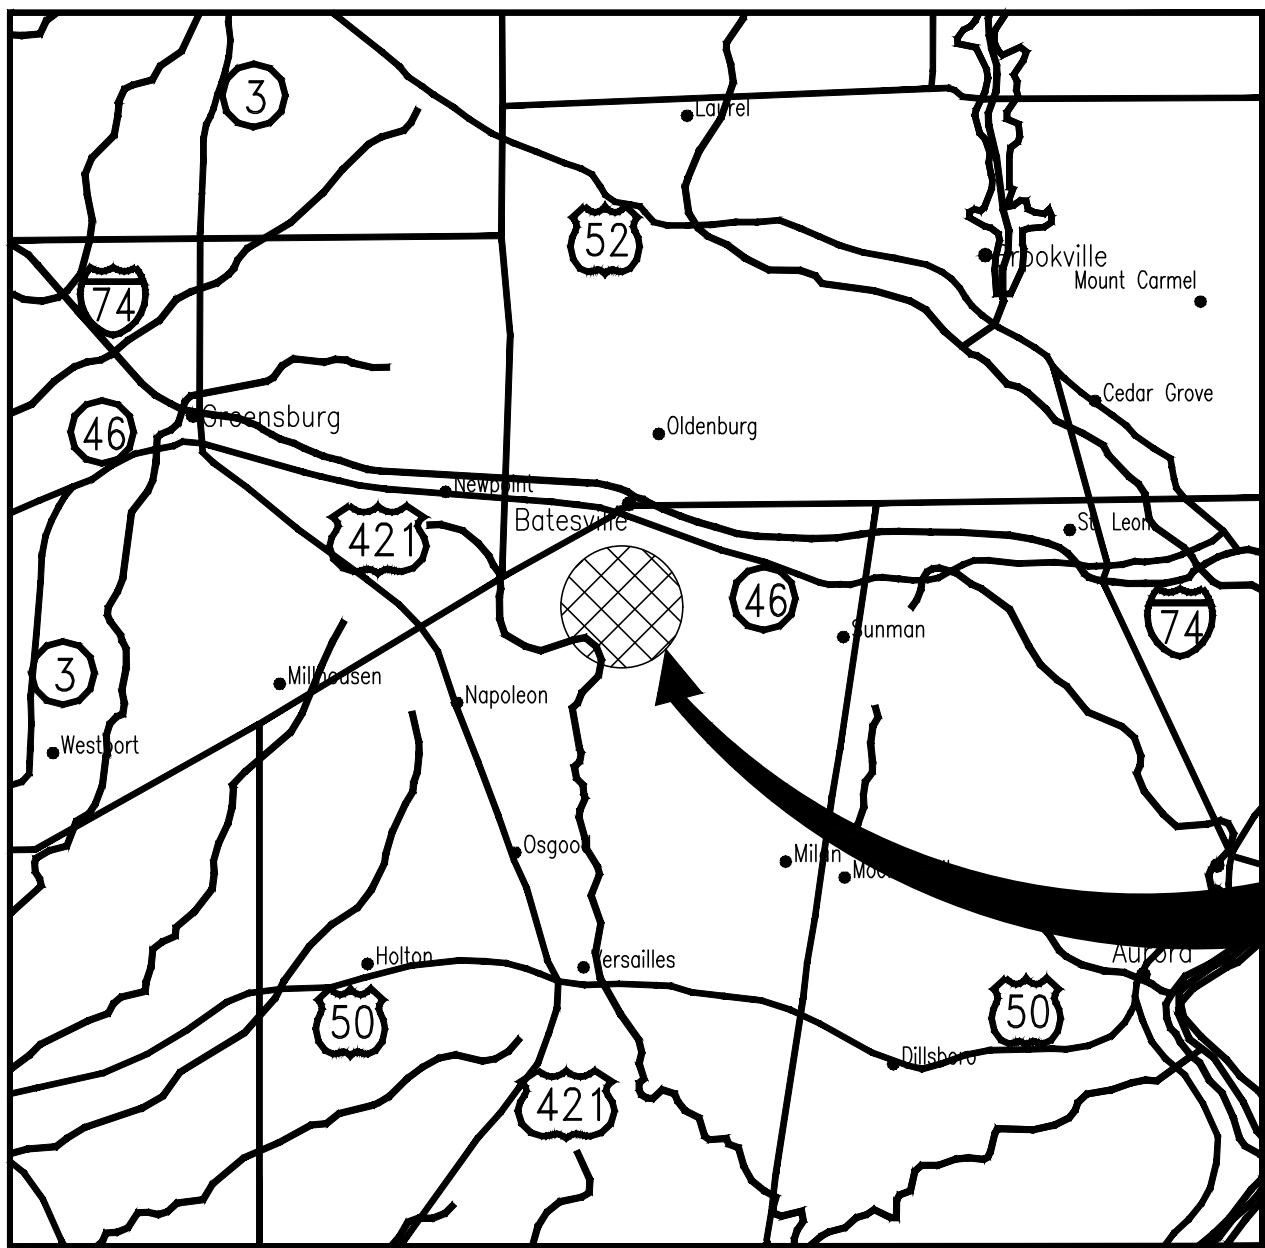

PROJECT LOCATION

INDEX OF DRAWINGS


SHEET NO.	DESCRIPTION
---	COVER SHEET
657	C.R. 1100 NORTH, STA. 10+00 TO 39+40
658	C.R. 1100 NORTH, STA. 39+40 TO 45+30

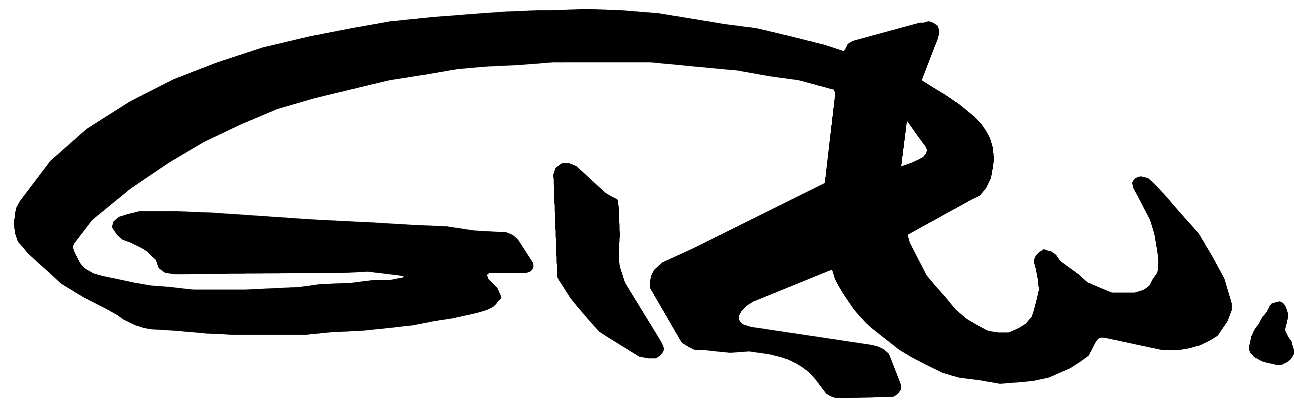

GRW Engineers, Inc.
7112 WALDEMAR DRIVE
INDIANAPOLIS, IN. 46268
(317) 347-3650

INDIANAPOLIS, INDIANA
LEXINGTON & LOUISVILLE, KENTUCKY
NASHVILLE, TENNESSEE
ARLINGTON, TEXAS
CINCINNATI, OHIO

SITE LOCATION MAP

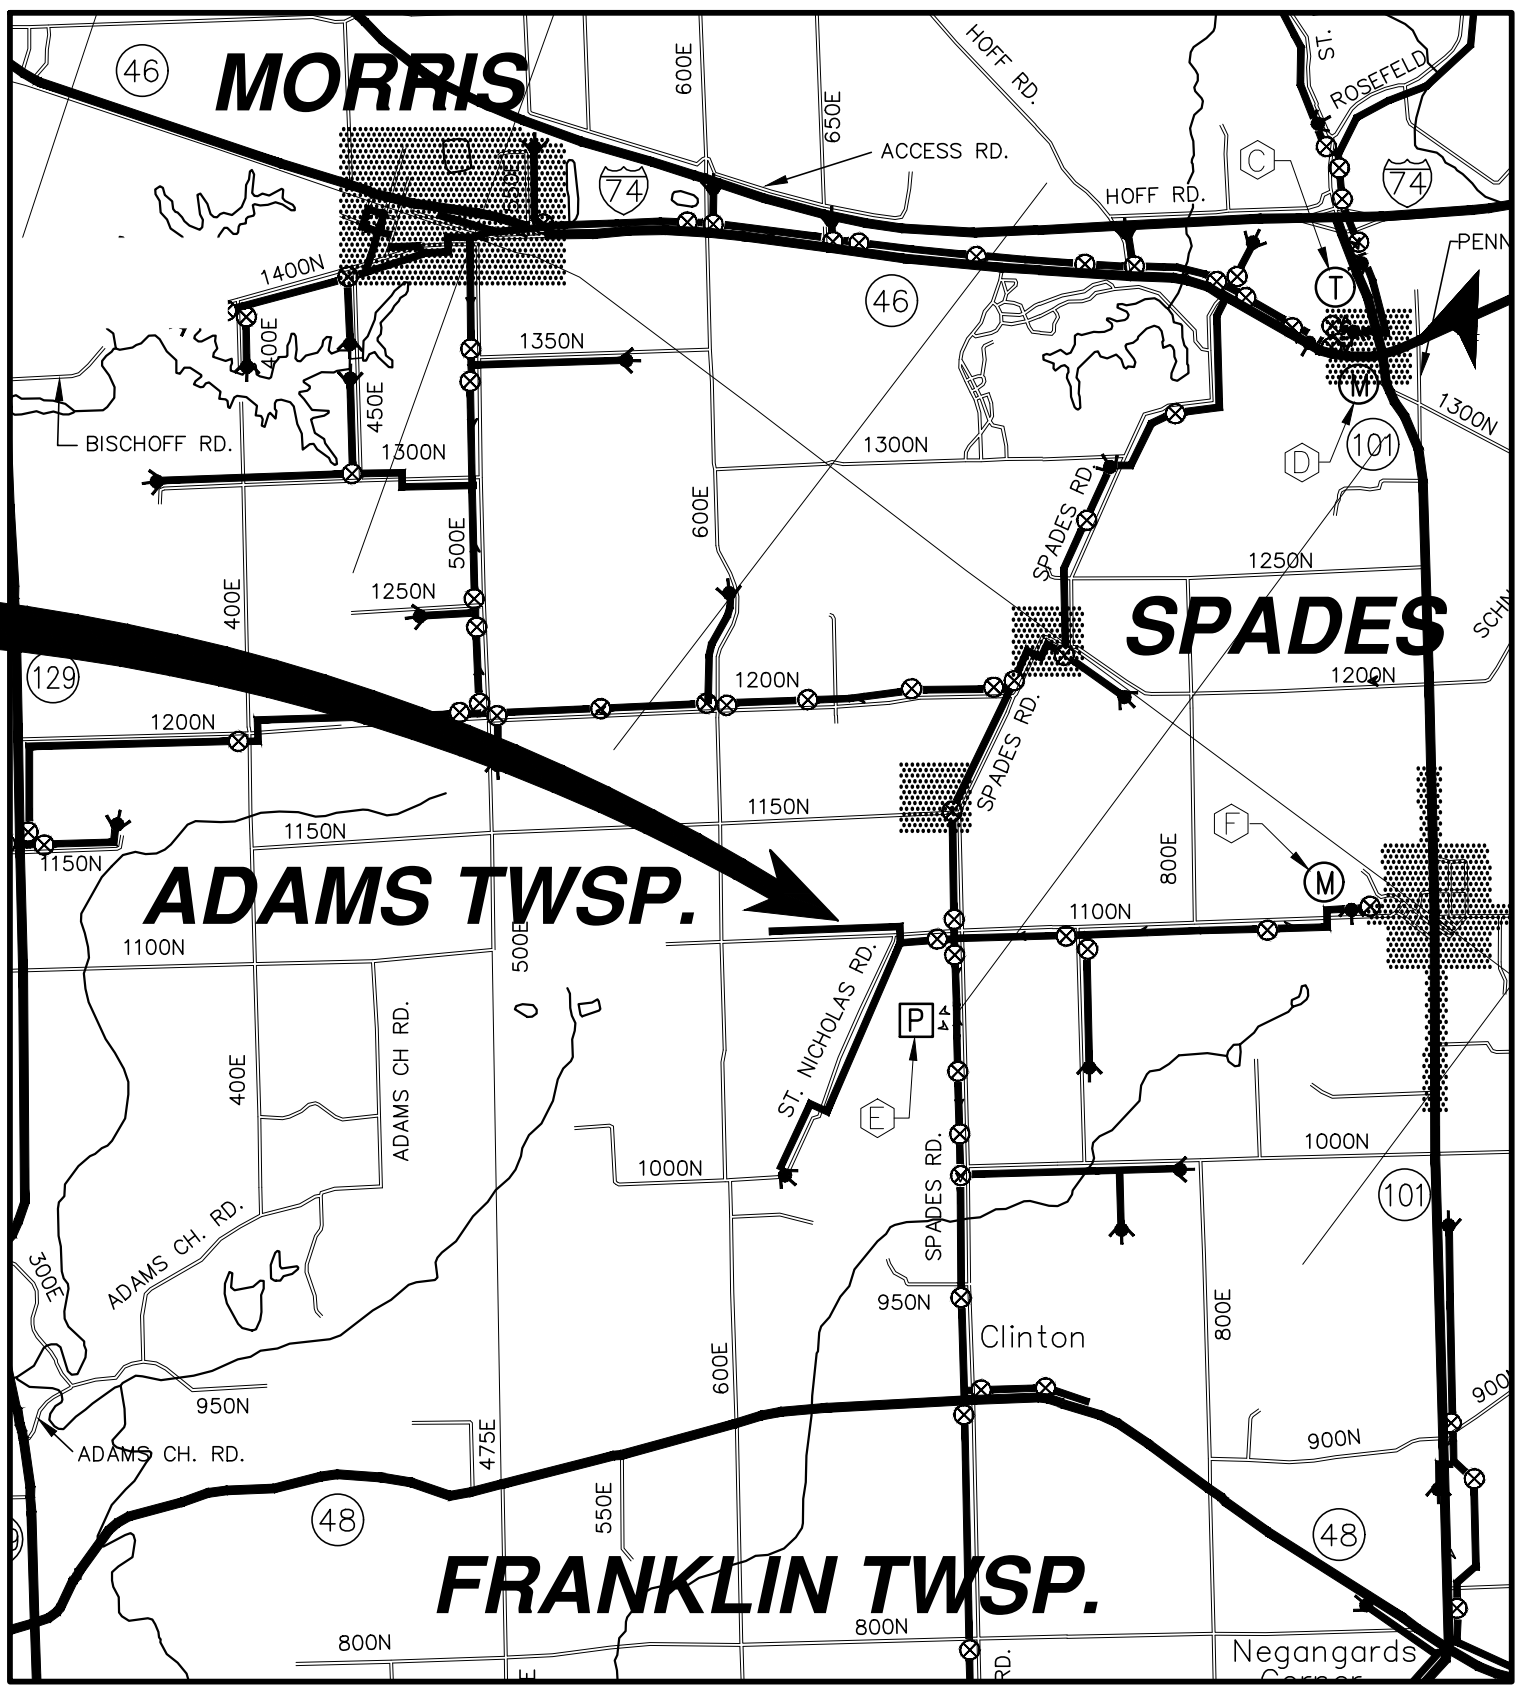

PROPOSED WATER MAIN
EXTENSION LOCATIONS

NOVEMBER 2000

RECORD DRAWING

This drawing has been revised from the original contract drawings to show minor/major changes made during construction. This drawing is not warranted to be complete and accurate in all respects.

GRW Engineers, Inc.

Date: 11-2001 By: GCR

CERTIFIED GREGORY A. WRIGHT, P.E. DATE _____
INDIANA REG. NO. 19300607

