
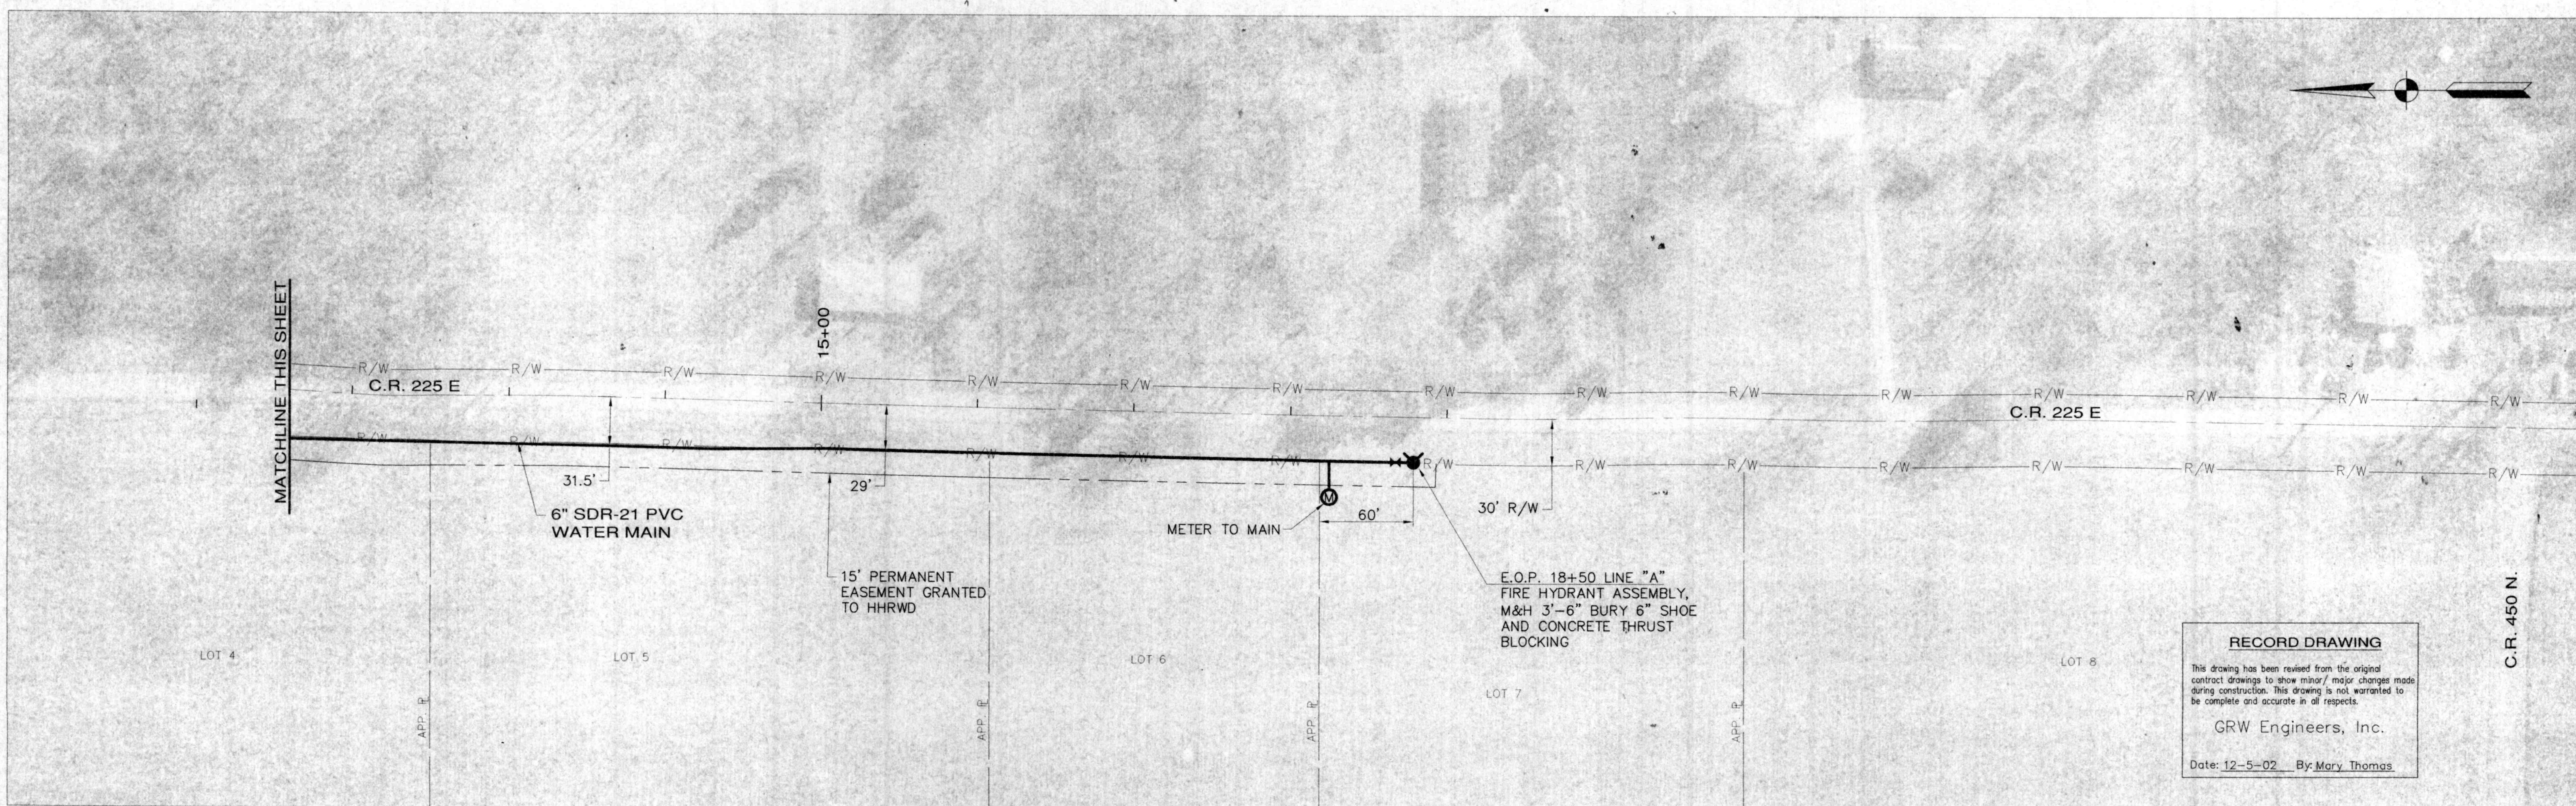


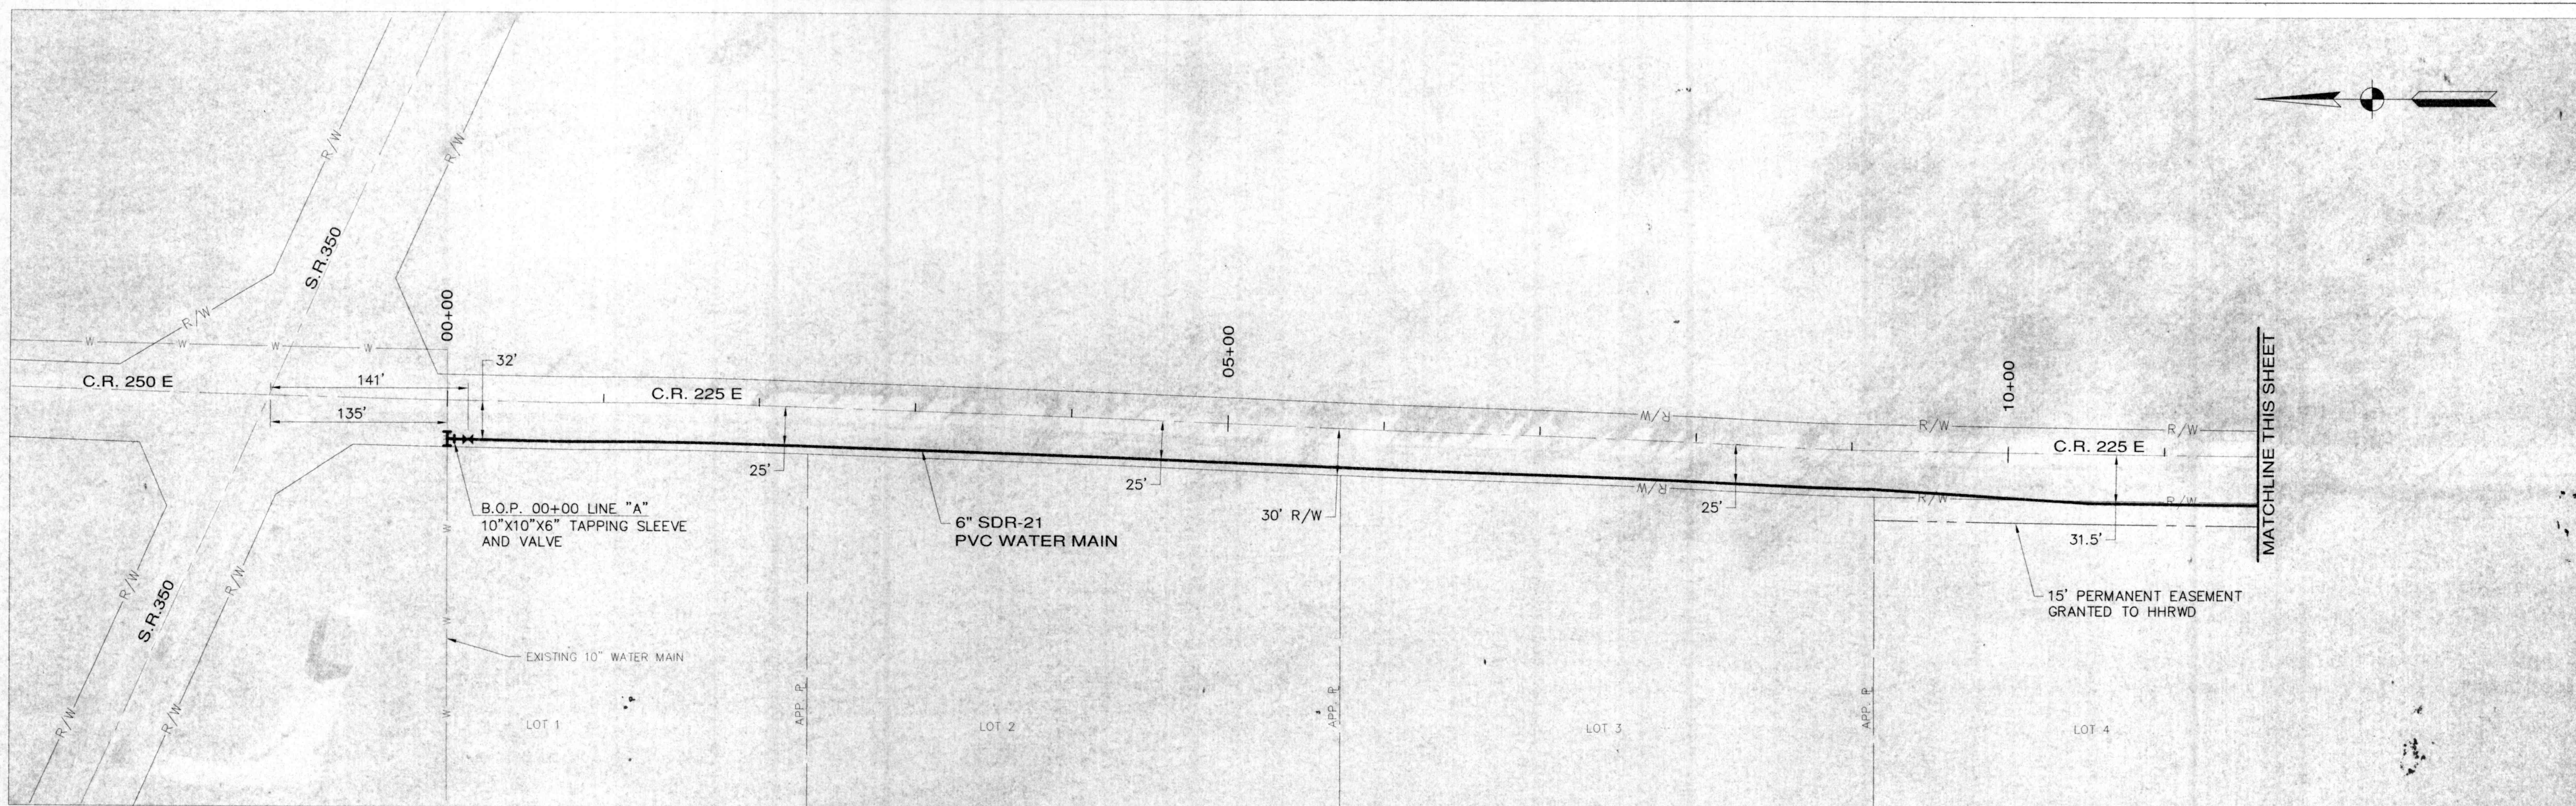


NOTES:

5			
4			
3			
2			
1	REVISED PER ASBUILT DRAWINGS	12-5-02	MAT
NO.	DESCRIPTION	DATE	BY
REVISIONS			

HOOSIER HILLS REGIONAL WATER DISTRICT
COUNTY ROAD 225 EAST

GRW PROJECT NO. 2543-55

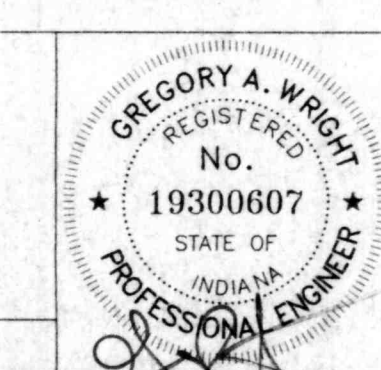

GRW Engineers, Inc.
Engineers, Architects, Planners
INDIANAPOLIS, INDIANA
LOUISVILLE & LEXINGTON, KENTUCKY
FORT MITCHELL, KENTUCKY
CINCINNATI, OHIO
NASHVILLE, TENNESSEE
ARLINGTON, TEXAS

RECORD DRAWING
This drawing has been revised from the original contract drawings to show minor / major changes made during construction. This drawing is not warranted to be complete and accurate in all respects.

GRW Engineers, Inc.
Date: 12-5-02 By: Mary Thomas

DRAWN:	MAT	DATE:	MAY 2002
FILE NAME:	2543-1.DWG	SCALE:	1" = 50'
CHECKED:		SHEET NO.	1
APPROVED:			