



HOOSIER HILLS REGIONAL WATER DISTRICT COUNTY ROAD 450 EAST WATER MAIN EXTENSION

SITE VICINITY MAP

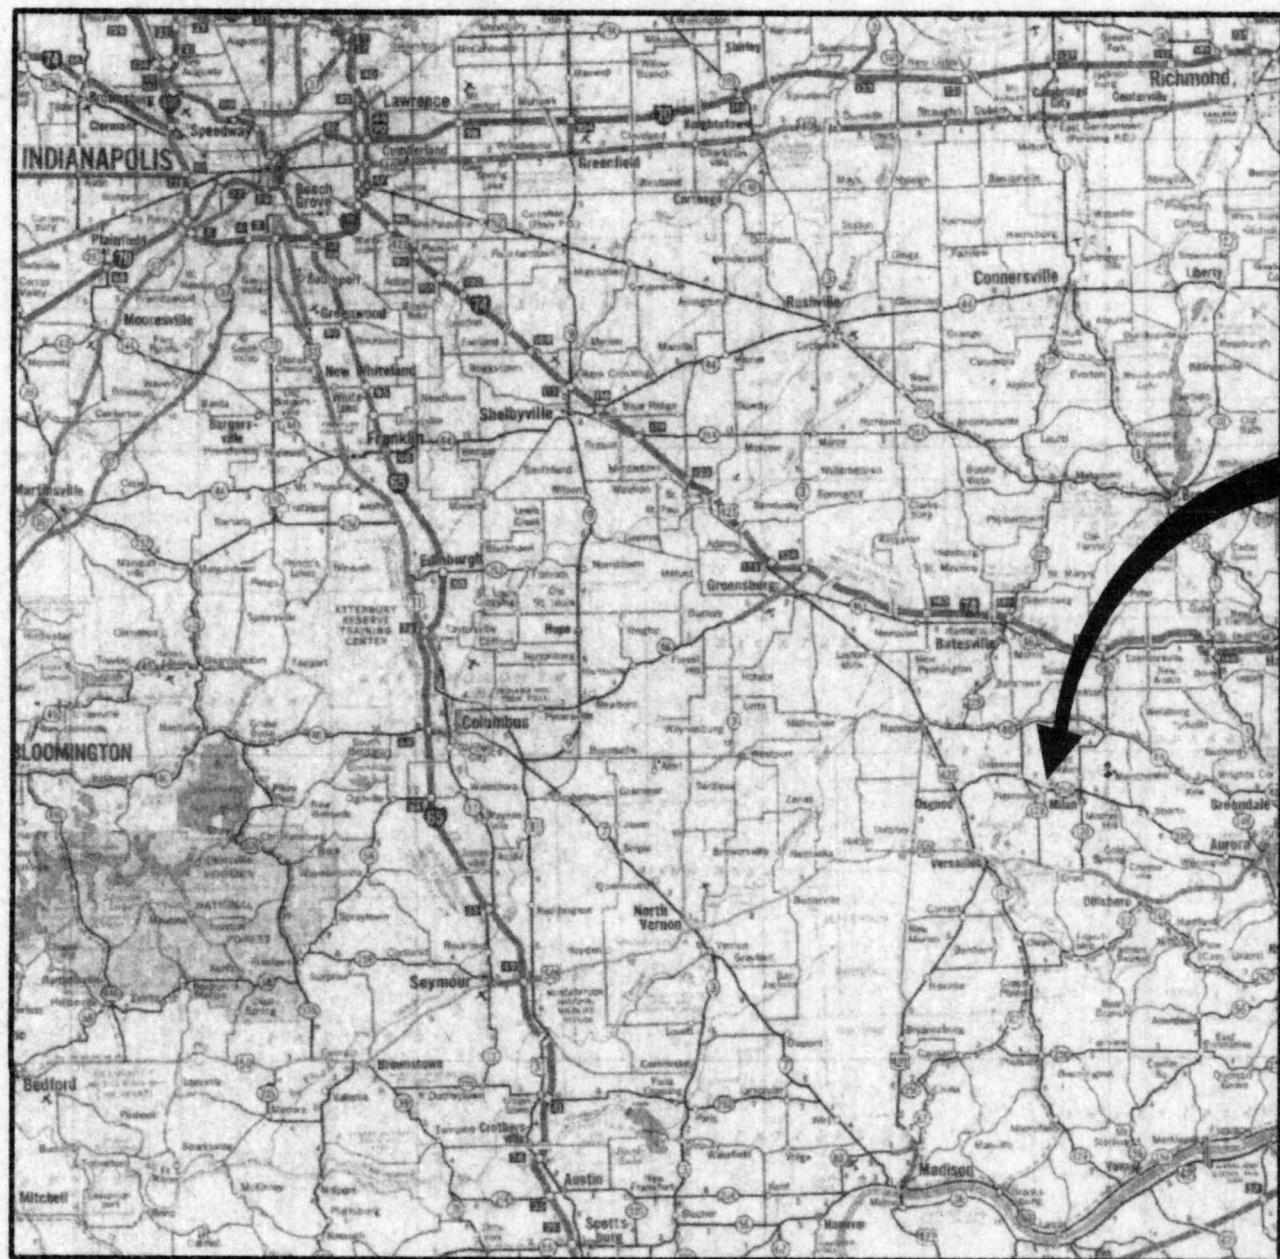

PROJECT LOCATION

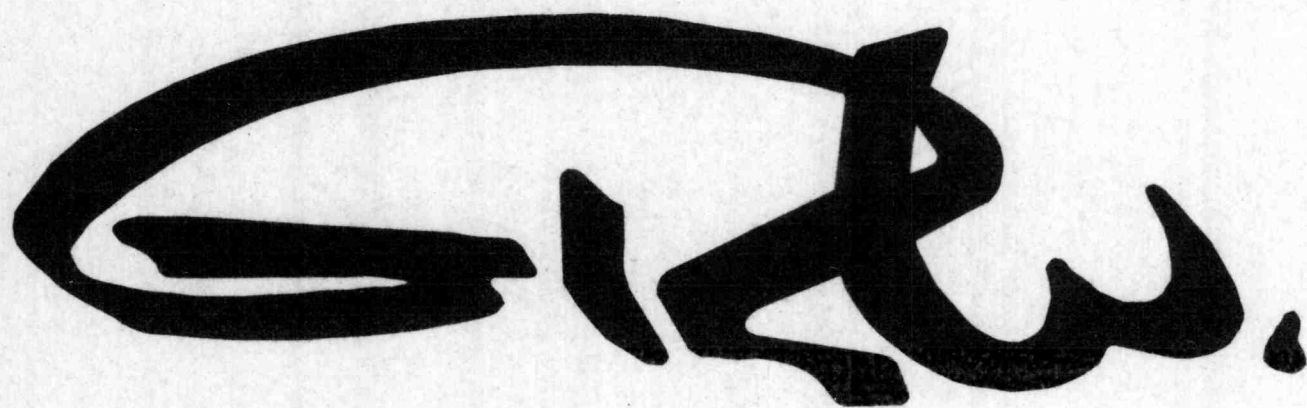


GRW Engineers, Inc.
7112 WALDEMAR DRIVE
INDIANAPOLIS, IN. 46268
(317) 347-3650

INDIANAPOLIS, INDIANA
LEXINGTON & LOUISVILLE, KENTUCKY
NASHVILLE, TENNESSEE
ARLINGTON, TEXAS
CINCINNATI, OHIO

INDEX OF DRAWINGS	
SHEET NO.	DESCRIPTION
---	COVER SHEET
1	C.R. 450 EAST EXTENSION
2	C.R. 450 EAST EXTENSION
3	C.R. 450 EAST EXTENSION

SITE LOCATION MAP

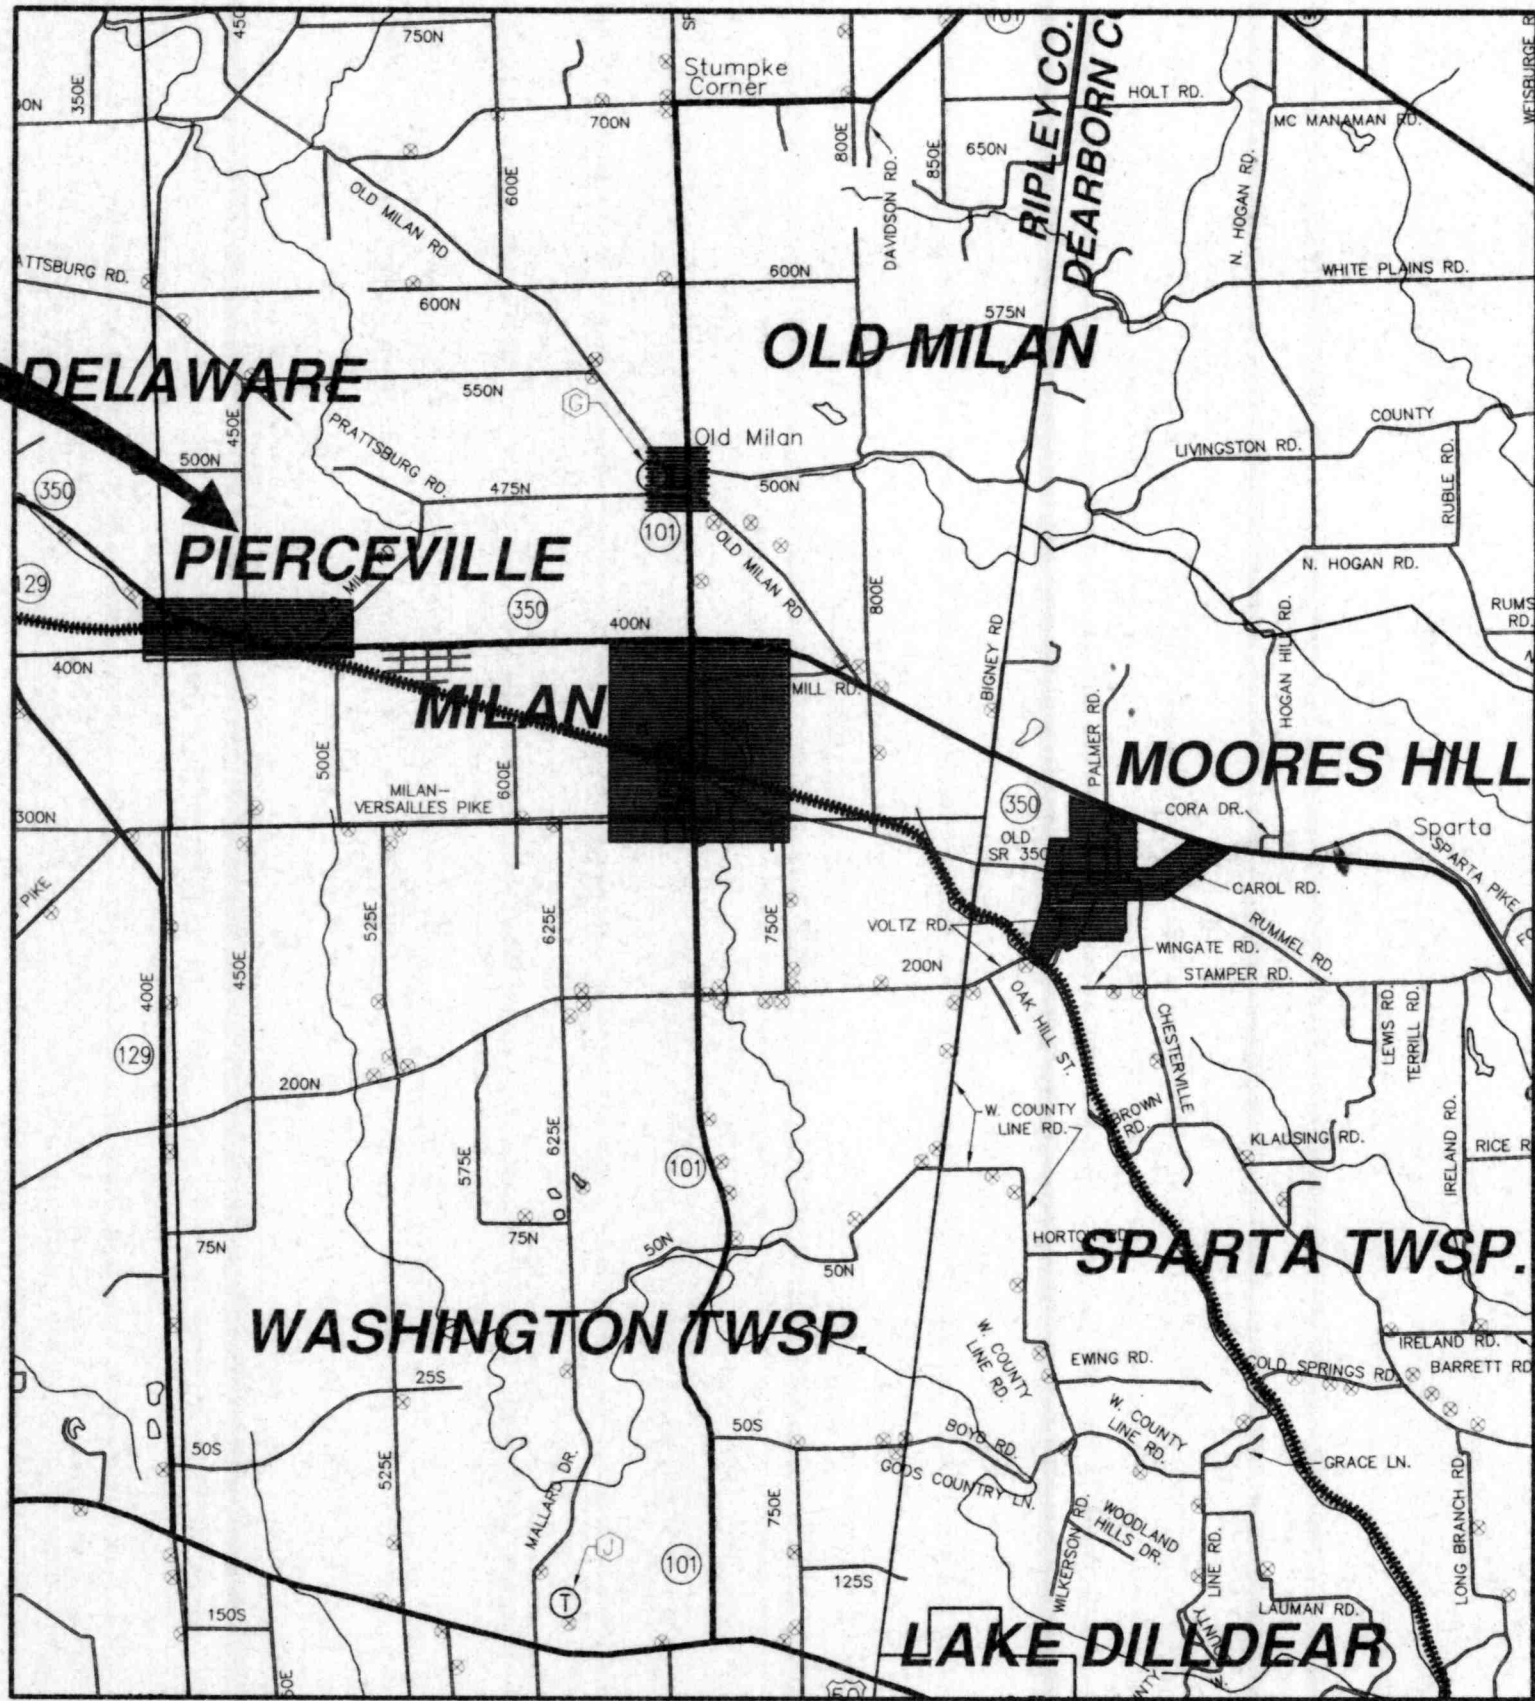

PROPOSED WATER MAIN
IMPROVEMENTS LOCATIONS

OCTOBER 2001

RECORD DRAWING
This drawing has been revised from the original
contract drawings to show minor / major changes made
during construction. This drawing is not warranted to
be complete and accurate in all respects.
GRW Engineers, Inc.
Date: 12-5-02 By: Mary Thomas

CERTIFIED

GREGORY A. WRIGHT, P.E.
INDIANA REG. NO. 19300607

DATE

10/17/01



GRW PROJECT NO. 2543-53