
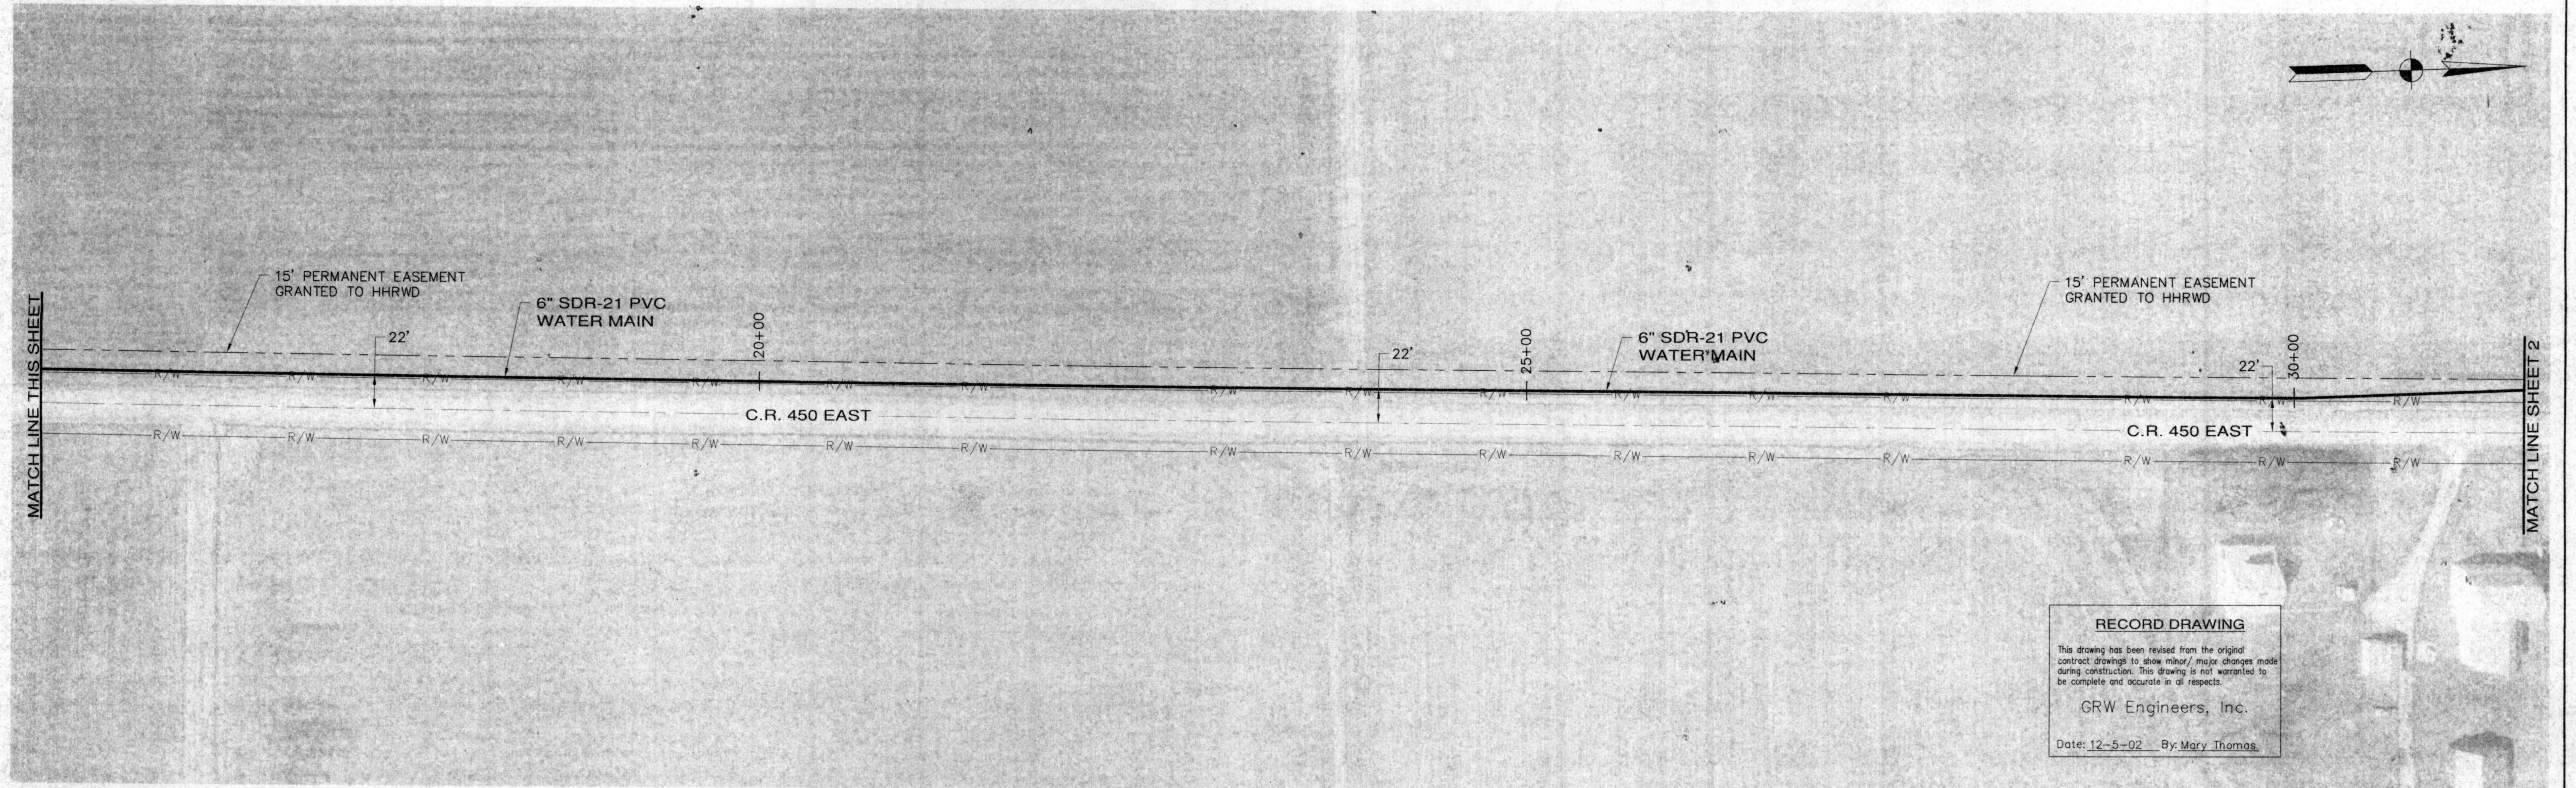


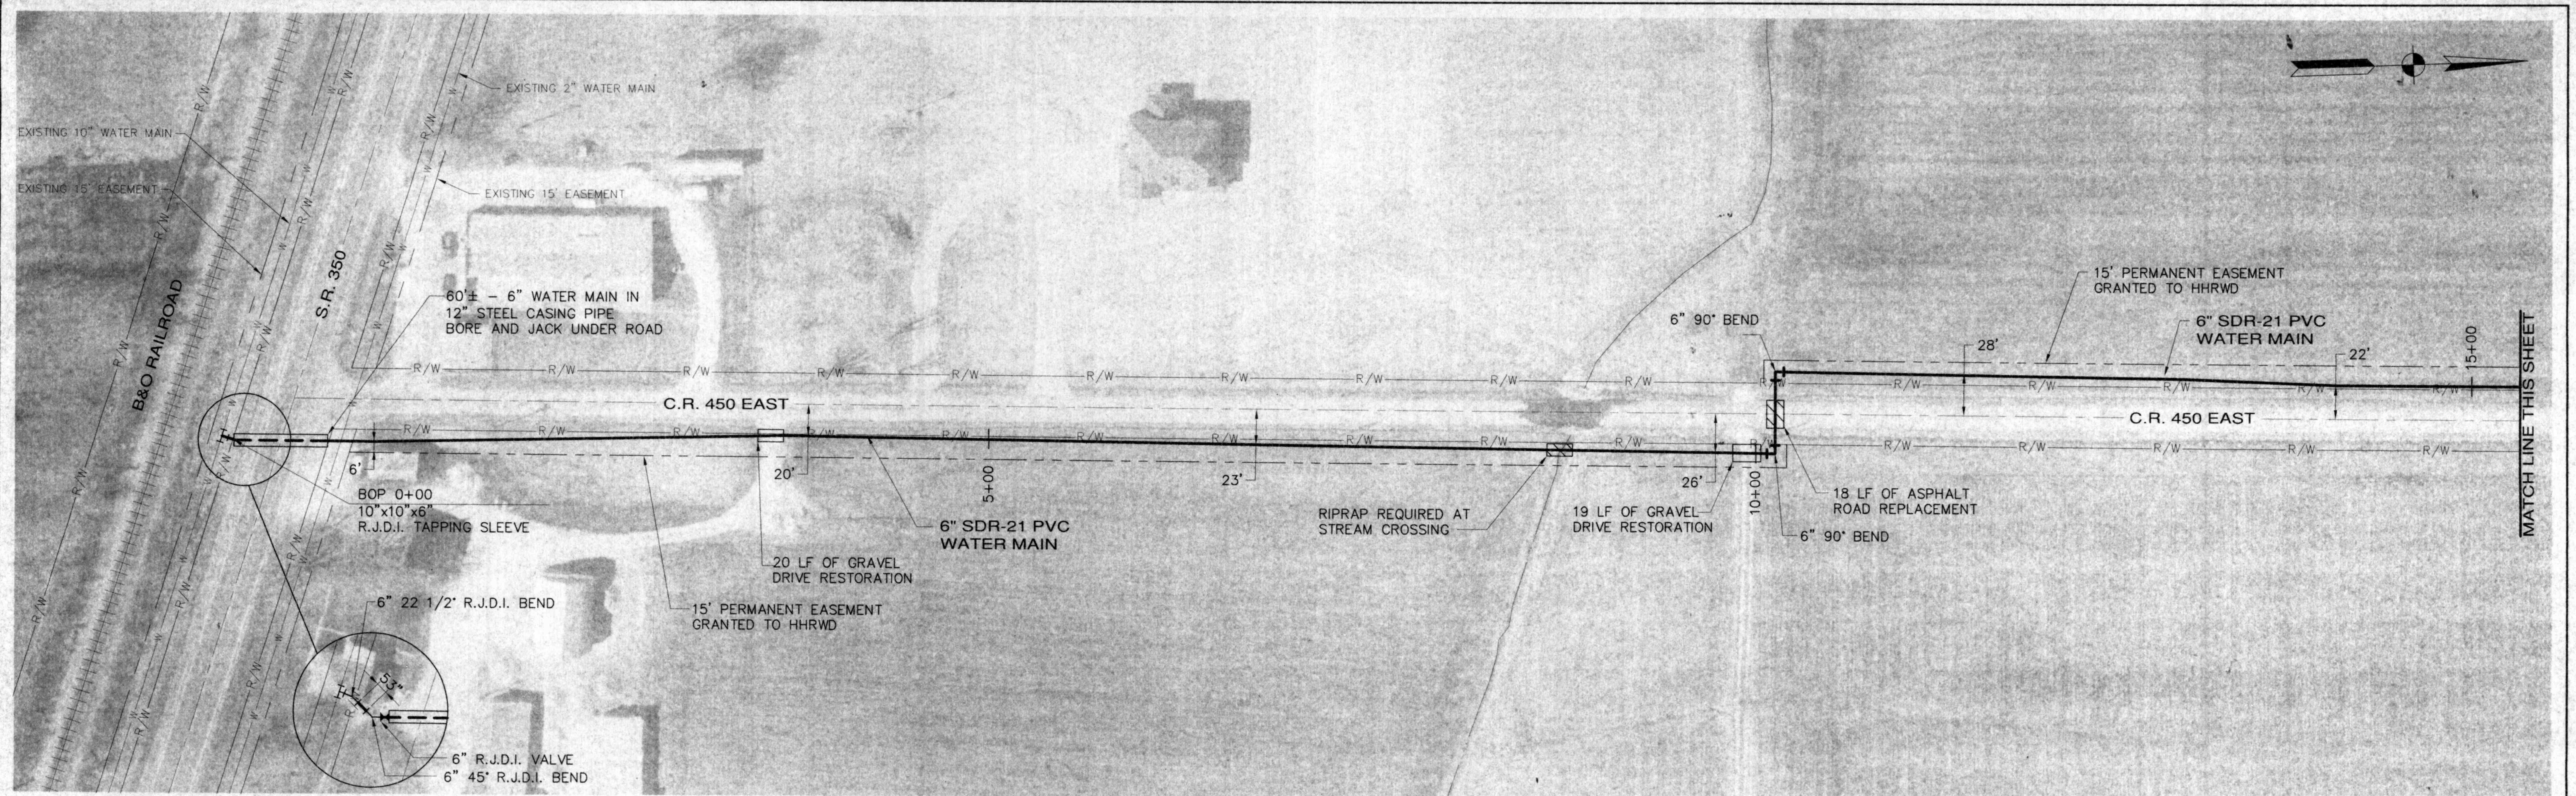

- NOTES:
- 1) THE UTILITIES AND THEIR LOCATION SHOWN ON PLANS ARE APPROXIMATE. CONTRACTOR SHALL VERIFY ALL UTILITIES IN THE FIELD AND NOTIFY ALL UTILITY COMPANIES PRIOR TO INSTALLATION OF THE WATER LINE.
 - 2) ALL PIPING SHALL BE CLASS 200 PVC UNLESS OTHERWISE NOTED.
 - 3) 48" MINIMUM COVER REQUIRED OVER TOP OF WATER LINE.

NO.	DESCRIPTION	DATE	BY
1	REVISED PER ASBUILT DRAWINGS	12-5-02	MAT
REVISIONS			

HOOSIER HILLS REGIONAL
WATER DISTRICT
COUNTY ROAD 450 EAST WATER MAIN EXTENSION
GRW PROJECT NO. 2543-53

GREGORY A. WRIGHT
REGISTERED
No. 19300607
STATE OF INDIANA
PROFESSIONAL ENGINEER

GRW Engineers, Inc.
Engineers, Architects, Planners
INDIANAPOLIS, INDIANA
LOUISVILLE & LEXINGTON, KENTUCKY
CINCINNATI, OHIO
NASHVILLE, TENNESSEE
ARLINGTON, TEXAS

DRAWN: SW
FILE NAME: SHEET1.DWG
CHECKED: [Signature]
APPROVED: [Signature]
DATE: October 2001
SCALE: 1" = 50'
SHEET NO. 1

RECORD DRAWING
This drawing has been revised from the original contract drawings to show minor / major changes made during construction. This drawing is not warranted to be complete and accurate in all respects.
GRW Engineers, Inc.
Date: 12-5-02 By: Mary Thomas