


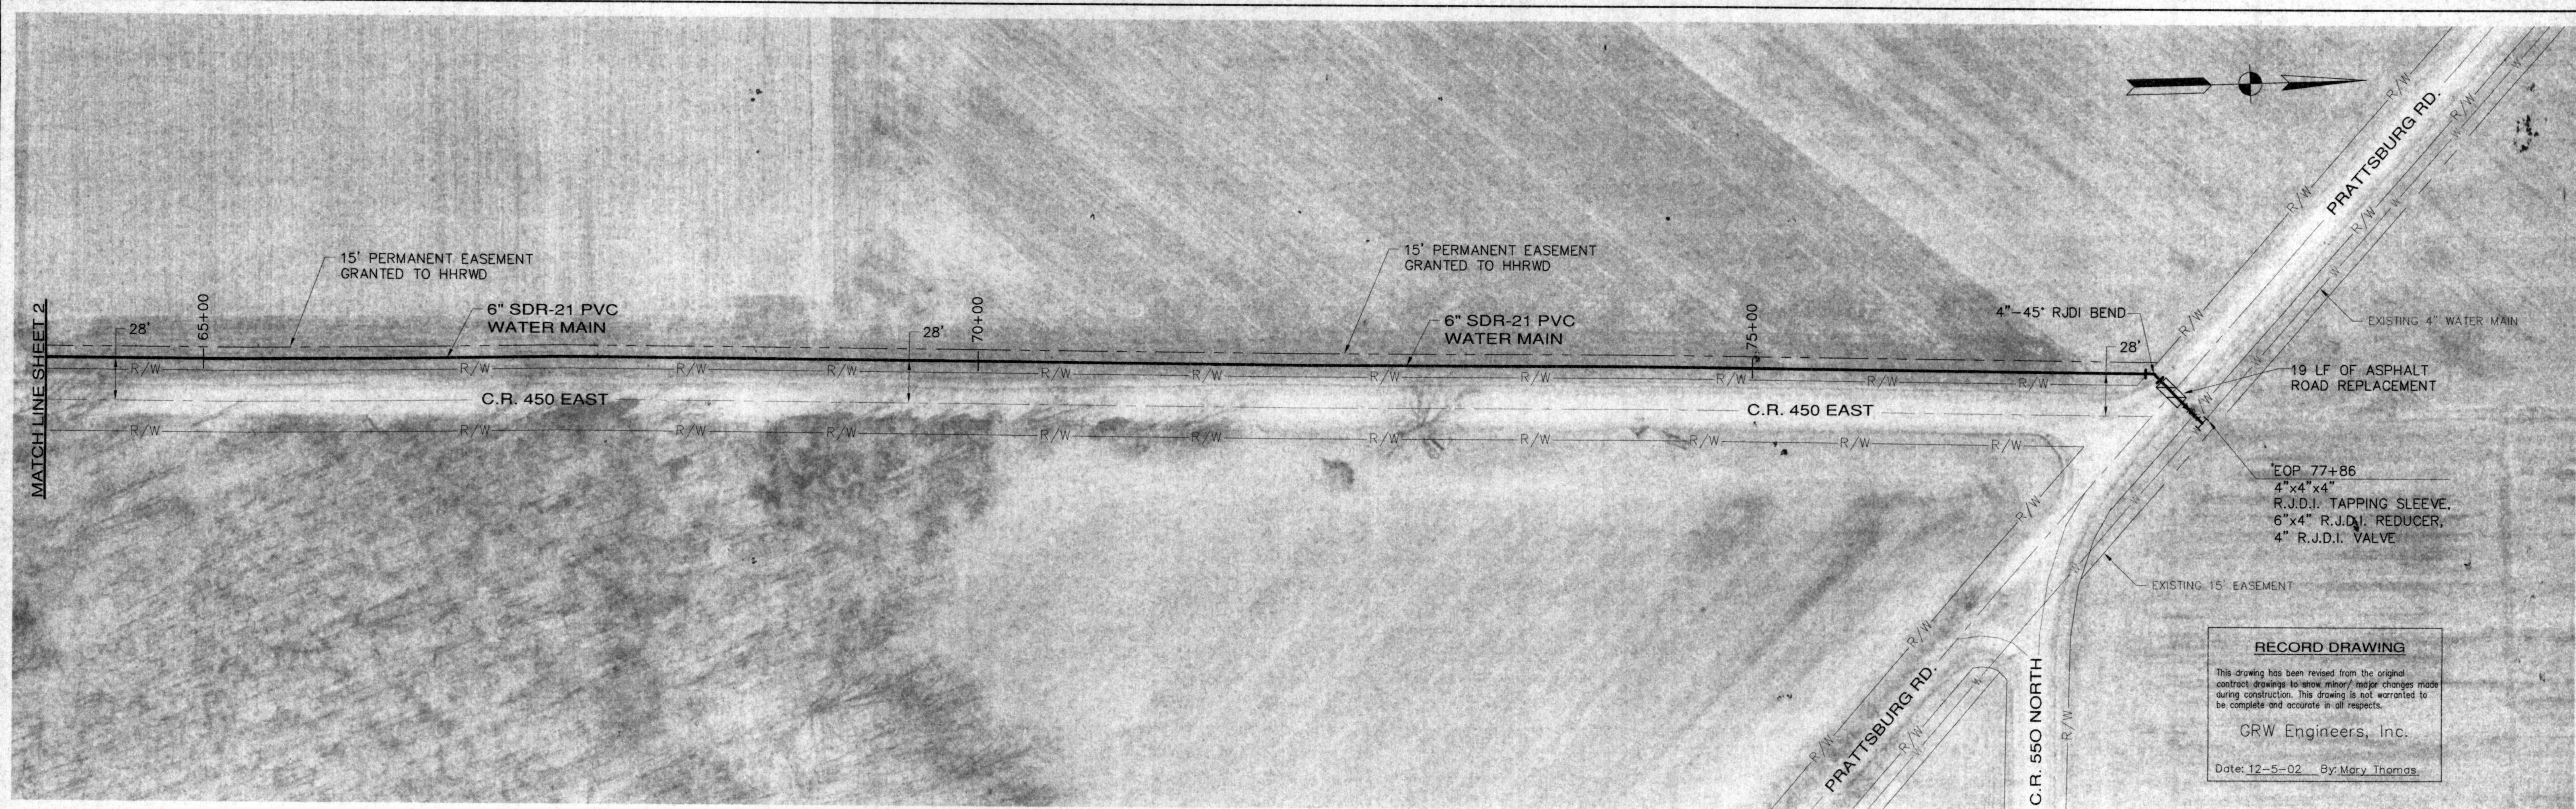


NOTES:

- 1). THE UTILITIES AND THEIR LOCATION SHOWN ON PLANS ARE APPROXIMATE. CONTRACTOR SHALL VERIFY ALL UTILITIES IN THE FIELD AND NOTIFY ALL UTILITY COMPANIES PRIOR TO INSTALLATION OF THE WATER LINE.
- 2). ALL PIPING SHALL BE CLASS 200 PVC UNLESS OTHERWISE NOTED.
- 3). 48" MINIMUM COVER REQUIRED OVER TOP OF WATER LINE.

NO.	DESCRIPTION	DATE	BY
1	REVISED PER ASBUILT DRAWINGS	12-5-02	MAT
REVISIONS			

HOOSIER HILLS REGIONAL
WATER DISTRICT
COUNTY ROAD 450 EAST WATER MAIN EXTENSION

GRW PROJECT NO. 2543-53

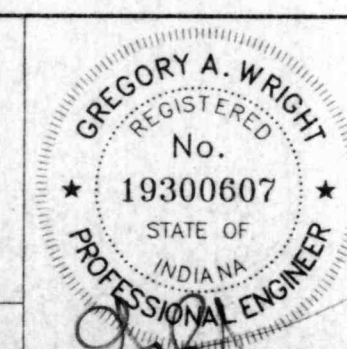

GRW Engineers, Inc.
Engineers, Architects, Planners
INDIANAPOLIS, INDIANA
LOUISVILLE & LEXINGTON, KENTUCKY
CINCINNATI, OHIO
NASHVILLE, TENNESSEE
ARLINGTON, TEXAS

DRAWN: SW	DATE: OCTOBER 2001
FILE NAME: SHEET3.DWG	SCALE: 1" = 50'
CHECKED:	SHEET NO.
APPROVED: <i>GW</i>	3