


HOOSIER HILLS REGIONAL WATER DISTRICT COUNTY ROAD 600 EAST WATER MAIN IMPROVEMENTS

SITE VICINITY MAP



PROJECT LOCATION

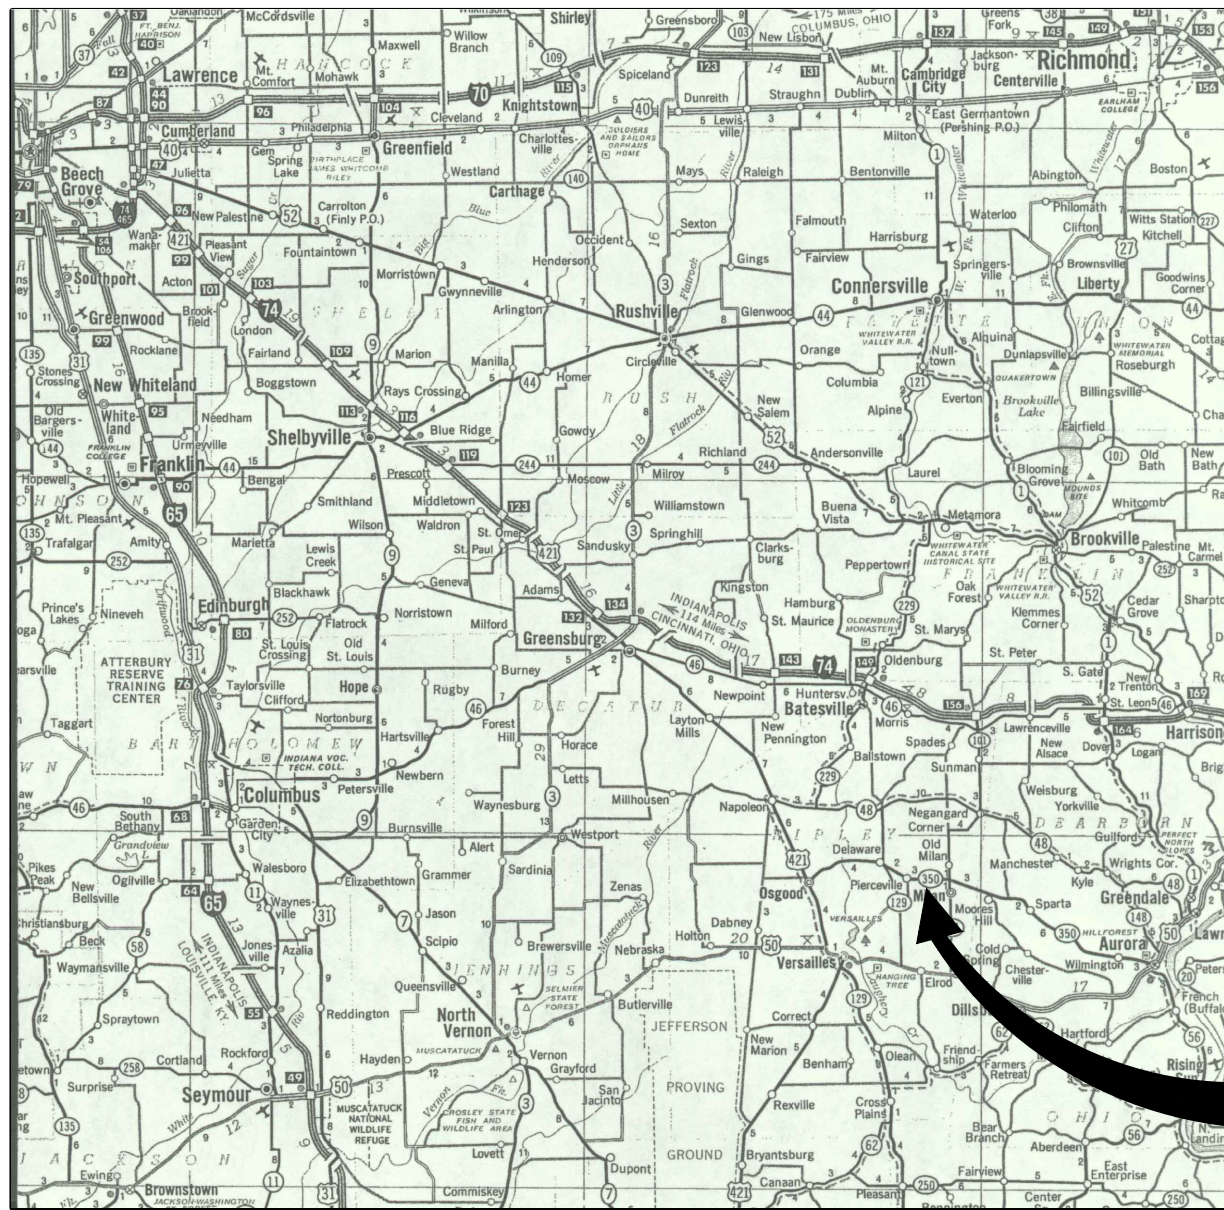


GRW Engineers, Inc.
7112 WALDEMAR DRIVE
INDIANAPOLIS, IN. 46268
(317) 347-3650

INDIANAPOLIS, INDIANA
LEXINGTON & LOUISVILLE, KENTUCKY
NASHVILLE, TENNESSEE
ARLINGTON, TEXAS
CINCINNATI, OHIO

SITE LOCATION MAP

PROPOSED WATER MAIN
EXTENSION LOCATIONS

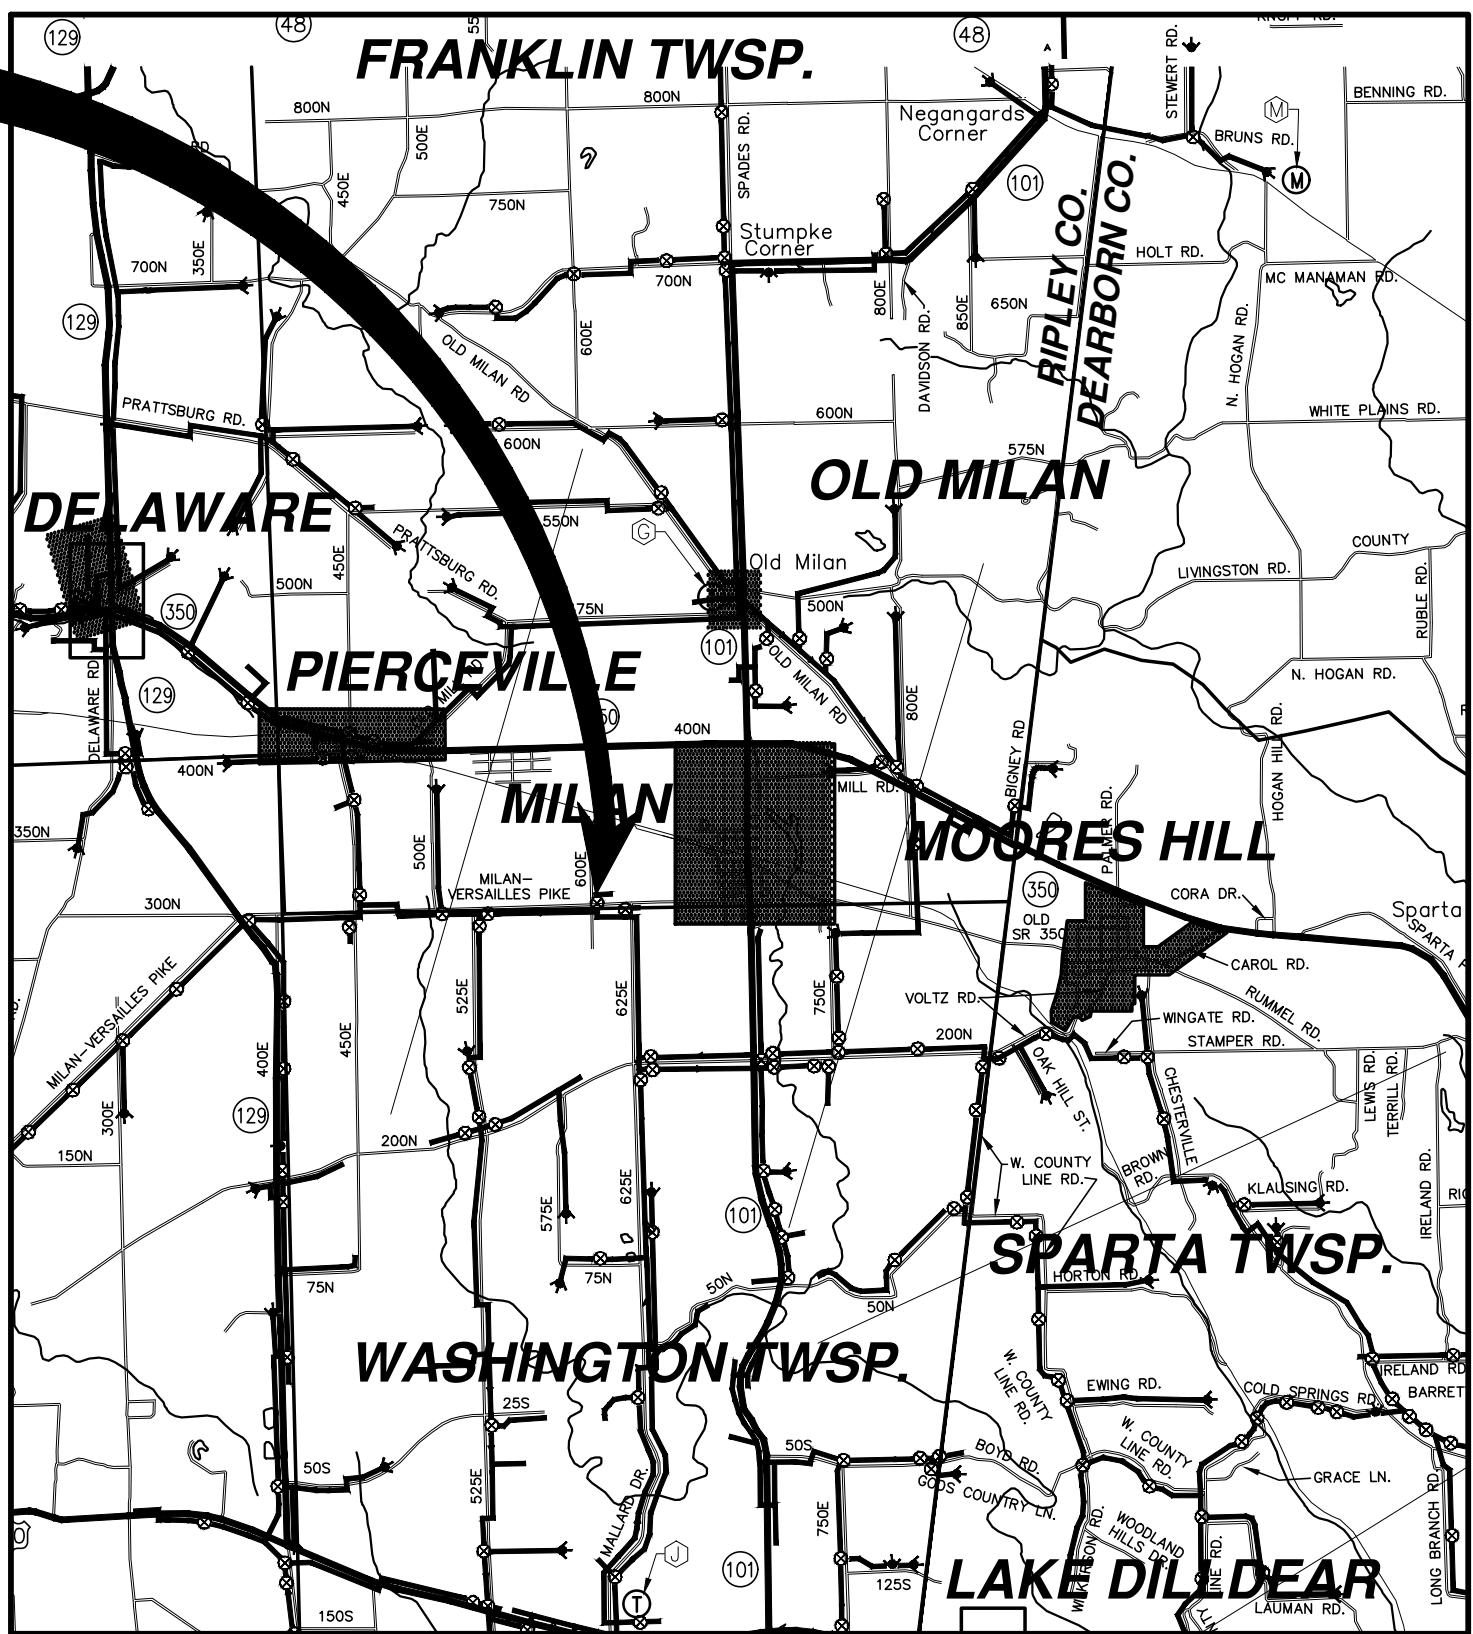

INDEX OF DRAWINGS

SHEET NO.	DESCRIPTION
---	COVER SHEET
654	C.R. 600 EAST, STA. 10+00 TO 34+00

RECORD DRAWING

This drawing has been revised from the original
original drawing. No other major or minor changes made
during construction. This drawing is not warranted to
be complete and accurate in all respects.


GRW Engineers, Inc.

Date: 8-8-01 By: M.A.T.

CERTIFIED

GREGORY A. WRIGHT, P.E.
INDIANA REG. NO. 19300607

DATE

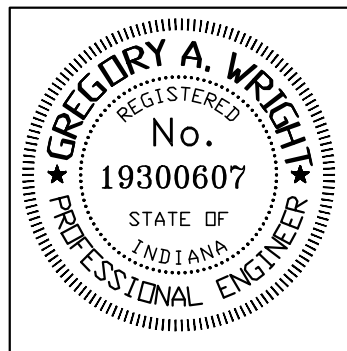

SEPTEMBER 2000