


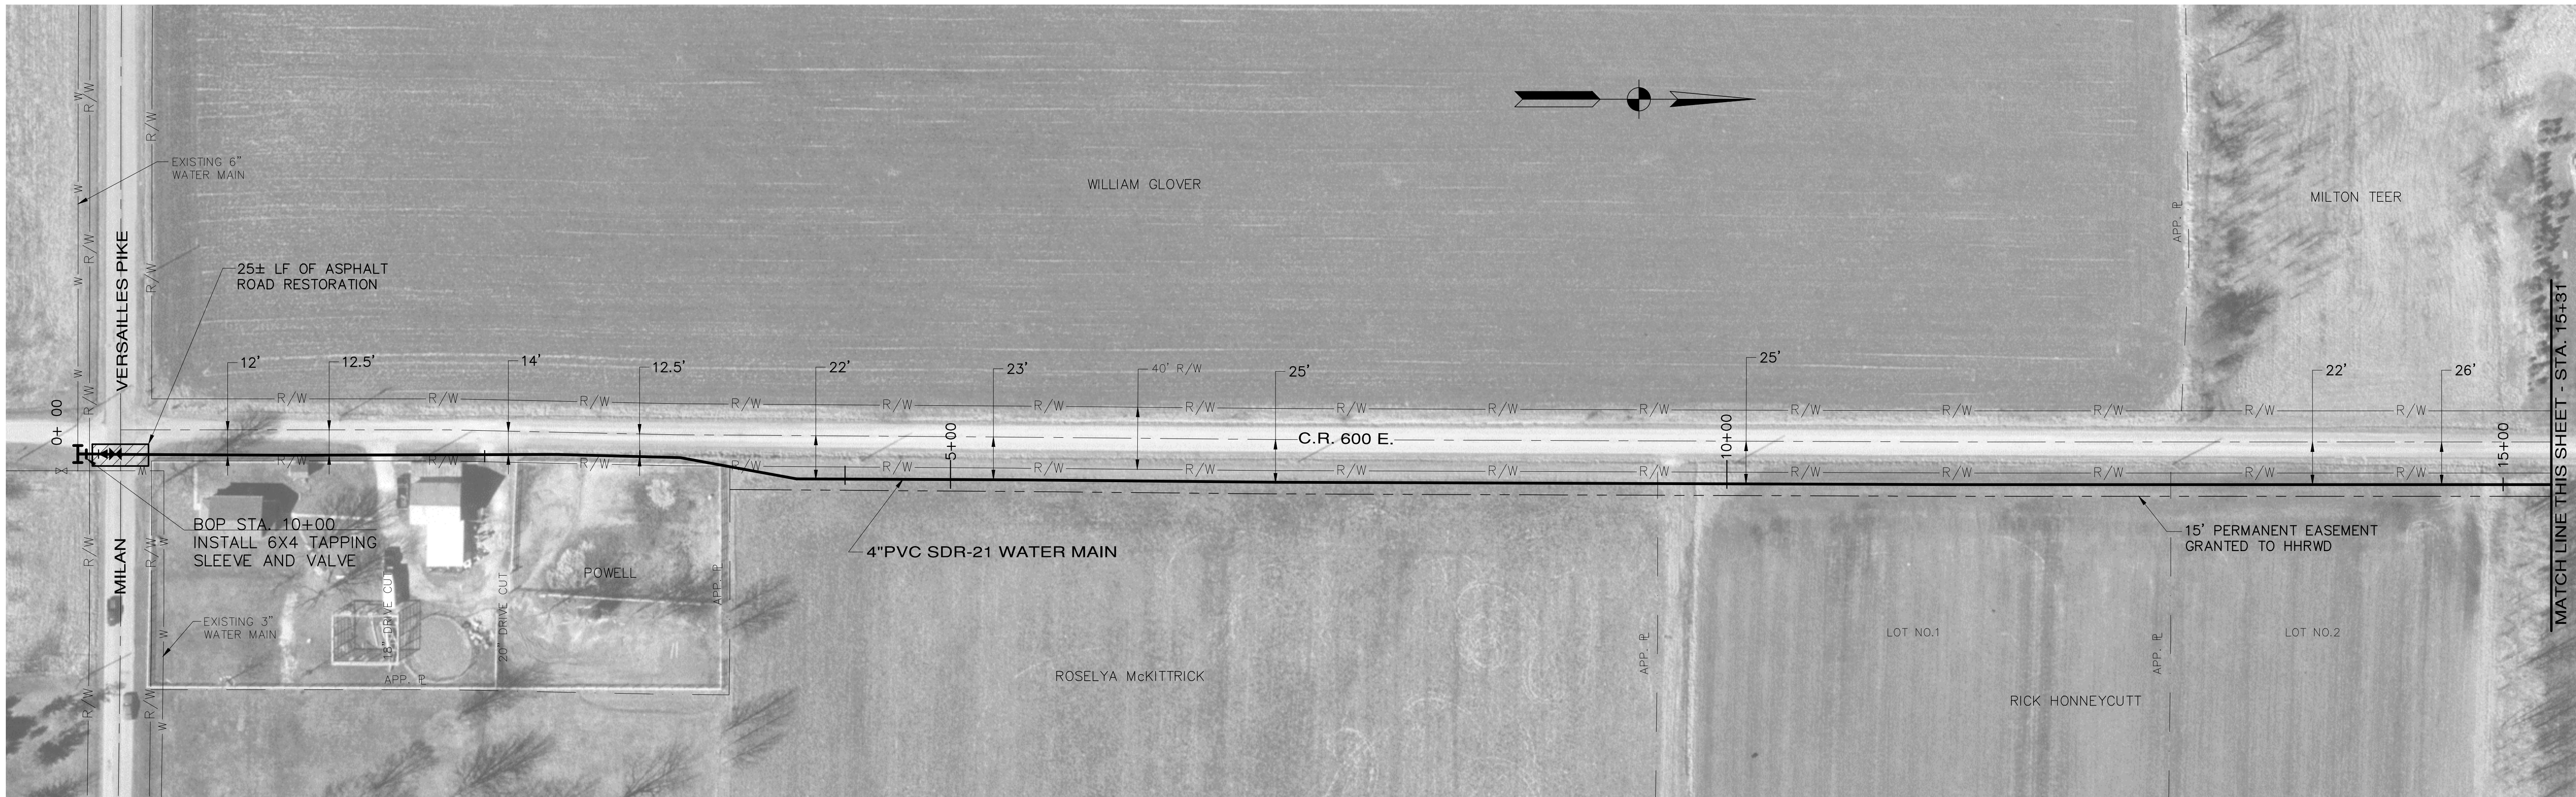


NOTES:

NO.	DESCRIPTION	DATE	BY
2	RENUMBERED	6-03	GCR
1	AS-BUILT	8-01	MAT
REVISIONS			

HOOSIER HILLS REGIONAL
WATER DISTRICT

C.R. 600 EAST WATER MAIN LINE EXTENSION

GRW PROJECT NO. 2543-36

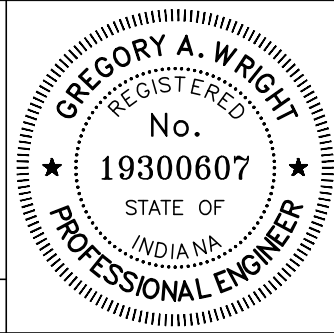

GRW
GRW Engineers, Inc.
Engineers, Architects, Planners
INDIANAPOLIS, INDIANA
LOUISVILLE & LEXINGTON, KENTUCKY
CINCINNATI, OHIO
NASHVILLE, TENNESSEE
ARLINGTON, TEXAS

DRAWN: BJD/GCR	DATE: SEPTEMBER 2000
FILE NAME: SHT654.DWG	SCALE: 1" = 50'
CHECKED:	SHEET NO.
APPROVED:	654