


HOOSIER HILLS REGIONAL WATER DISTRICT COUNTY ROAD 850 EAST WATER MAIN IMPROVEMENTS

SITE VICINITY MAP




PROJECT LOCATION

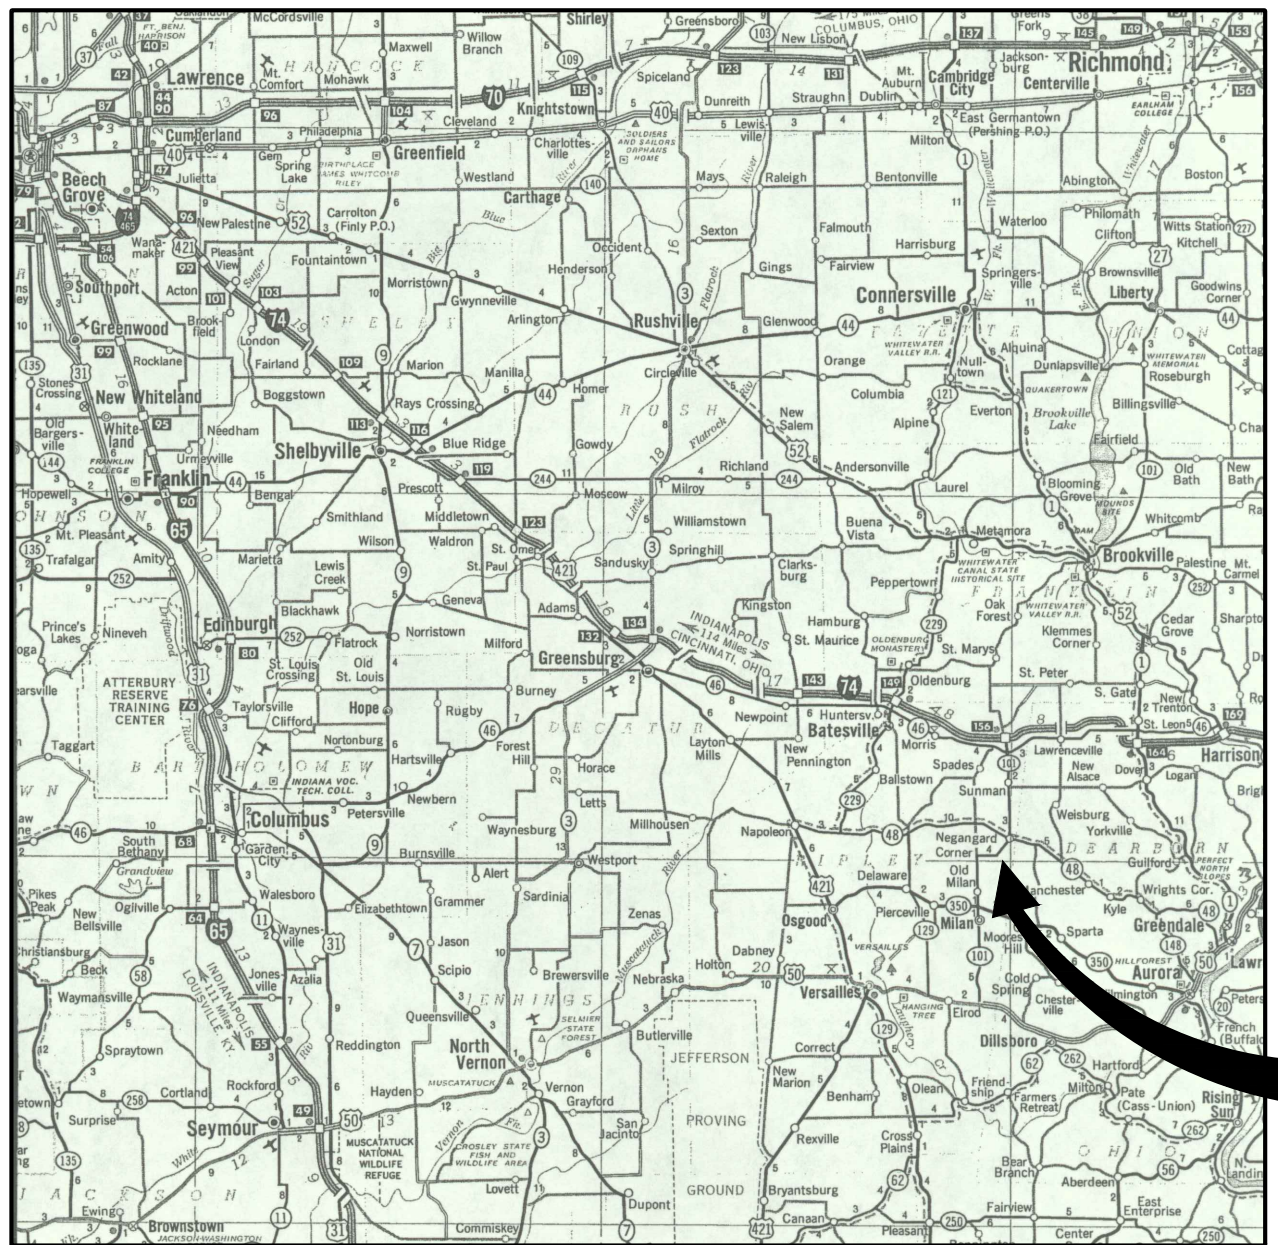

GRW Engineers, Inc.
7112 WALDEMAR DRIVE
INDIANAPOLIS, IN. 46268
(317) 347-3650

INDIANAPOLIS, INDIANA
LEXINGTON & LOUISVILLE, KENTUCKY
NASHVILLE, TENNESSEE
ARLINGTON, TEXAS
CINCINNATI, OHIO

SITE LOCATION MAP

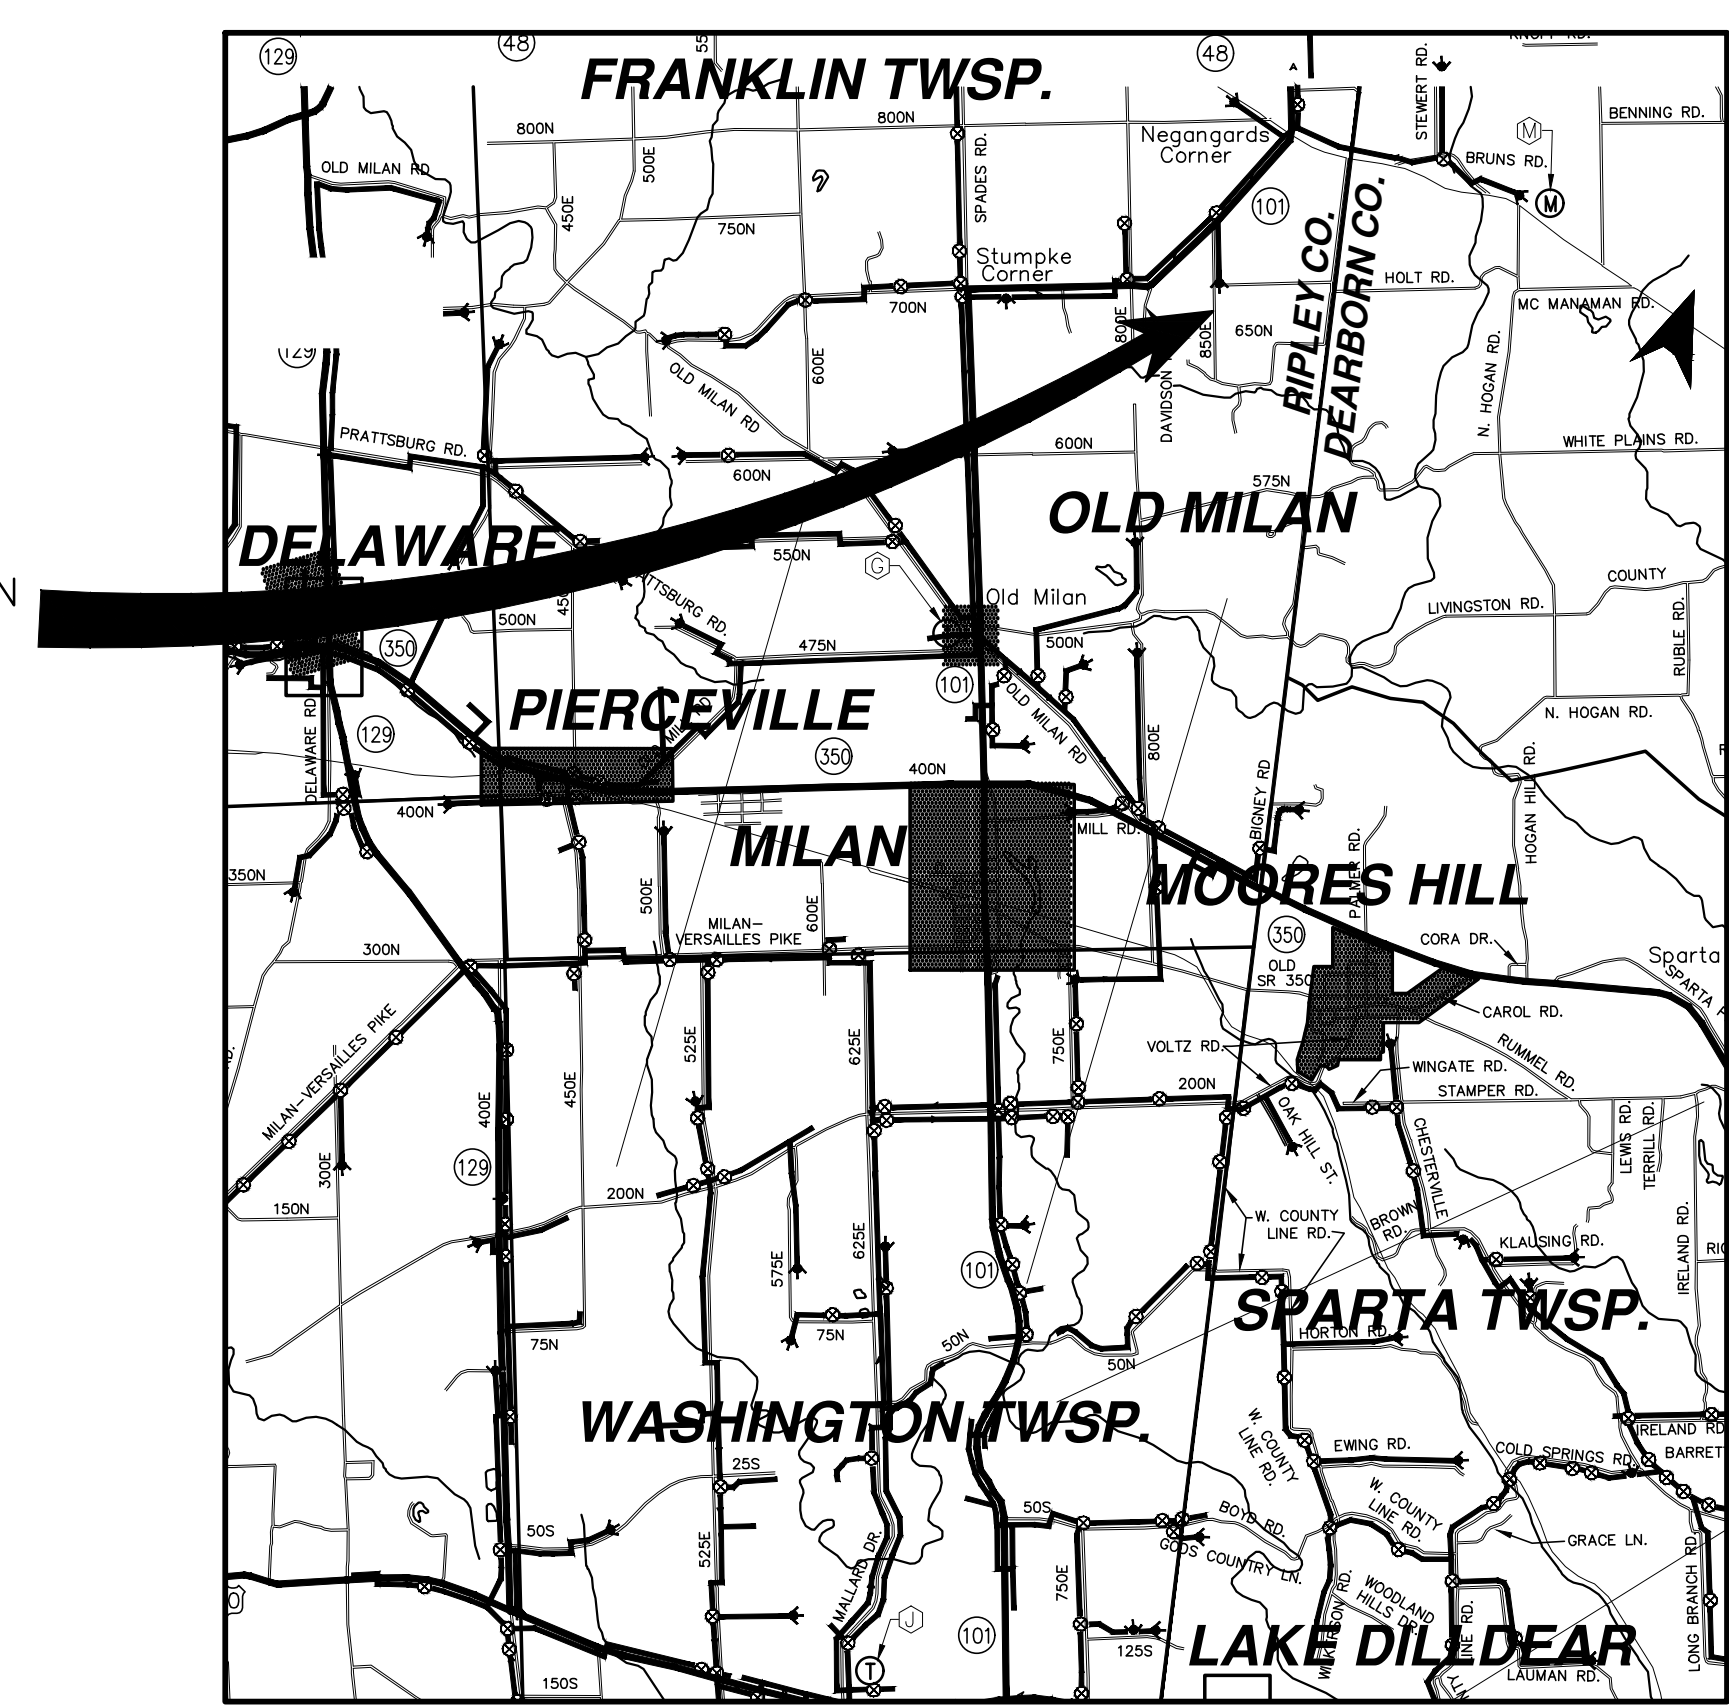

PROPOSED WATER MAIN
EXTENSION LOCATIONS

INDEX OF DRAWINGS

SHEET NO.	DESCRIPTION
---	COVER SHEET
656	C.R. 850 EAST, STA. 10+00 TO 34+00

OCTOBER 2000

RECORD DRAWING
This drawing has been revised from the original contract drawings to show minor/major changes made during construction. This drawing is not warranted to be complete and accurate in all respects.
GRW Engineers, Inc.
Date: 8-8-01 By: M.A.T.

CERTIFIED GREGORY A. WRIGHT, P.E. DATE _____
INDIANA REG. NO. 19300607

