

ELROD WATER COMPANY, INC.

RIPLEY COUNTY, INDIANA

SYSTEM IMPROVEMENTS

SUPPLY, EXTENSIONS AND STORAGE FACILITIES

1980

AS BUILT

Date 6-16-83 By M. Surra


BOARD OF DIRECTORS

J. B. CALENDER	PRESIDENT
DENVER MILLS	VICE PRESIDENT
LUTHER CALENDER	SECRETARY
FLOYD HUNGER	TREASURER
PAUL LUKE	DIRECTOR
PAUL WATSON	DIRECTOR
STANLEY WEBB	DIRECTOR
DANIEL SCHMALTZ	DIRECTOR
HARRY L. FLEMING	DIRECTOR
JOE COX	ATTORNEY

INDEX TO PLANS


DIVISION A — WATER DISTRIBUTION SYSTEM


<u>SHEET NUMBER</u>	<u>DESCRIPTION</u>
1	PROJECT LOCATION MAP AND LIST OF UTILITIES
2-3	GENERAL LINE LOCATION MAP
4	NOTES - SYMBOLS AND INDEX TO PLAN SHEETS
5-39	PLAN SHEETS - LINE NO. 1 AND BRANCHES
40-57	PLAN SHEETS - LINE NO. 2 AND BRANCHES
58-60	PLAN SHEETS - LINE NO. 3 - RAW WATER LINE
61-70	HYDRAULIC PROFILE SHEETS
71-79	HYDRAULIC DESIGN DATA SHEETS
80	PLOT PLAN AND DETAILS FOR TANK SITE
81	TELEMETERING DETAILS
82	ALTITUDE VALVE VAULT-DETAILS
83	SOLENOID VALVE AND METER STATION-DETAILS
84	SOLENOID VALVE STATION-DETAILS
85	SOLENOID VALVE STATIONS-ELECTRICAL DETAILS
86-87	MAINLINE BOOSTER STATION-DETAILS
88	MAINLINE (MASTER) METER STATION-DETAILS
89	WATER WORKS STANDARDS-DETAILS

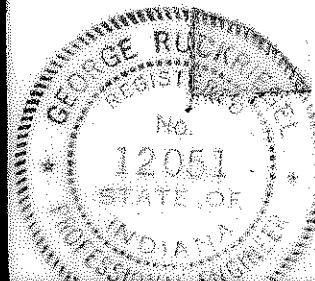

FINANCED BY THE
FARMERS HOME ADMINISTRATION

SIECO, INC. CONSULTING ENGINEERS, ARCHITECTS AND PLANNERS
309 WASHINGTON STREET, COLUMBUS, INDIANA 47201


1/21/80
CERTIFIED BY GEORGE R. RUCKRIEGEL
INDIANA P. E. NO. 12051

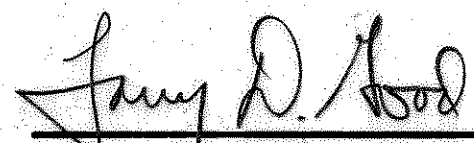
5/30/80
APPROVED BY LARRY D. GOOD
CHIEF ENGINEER