


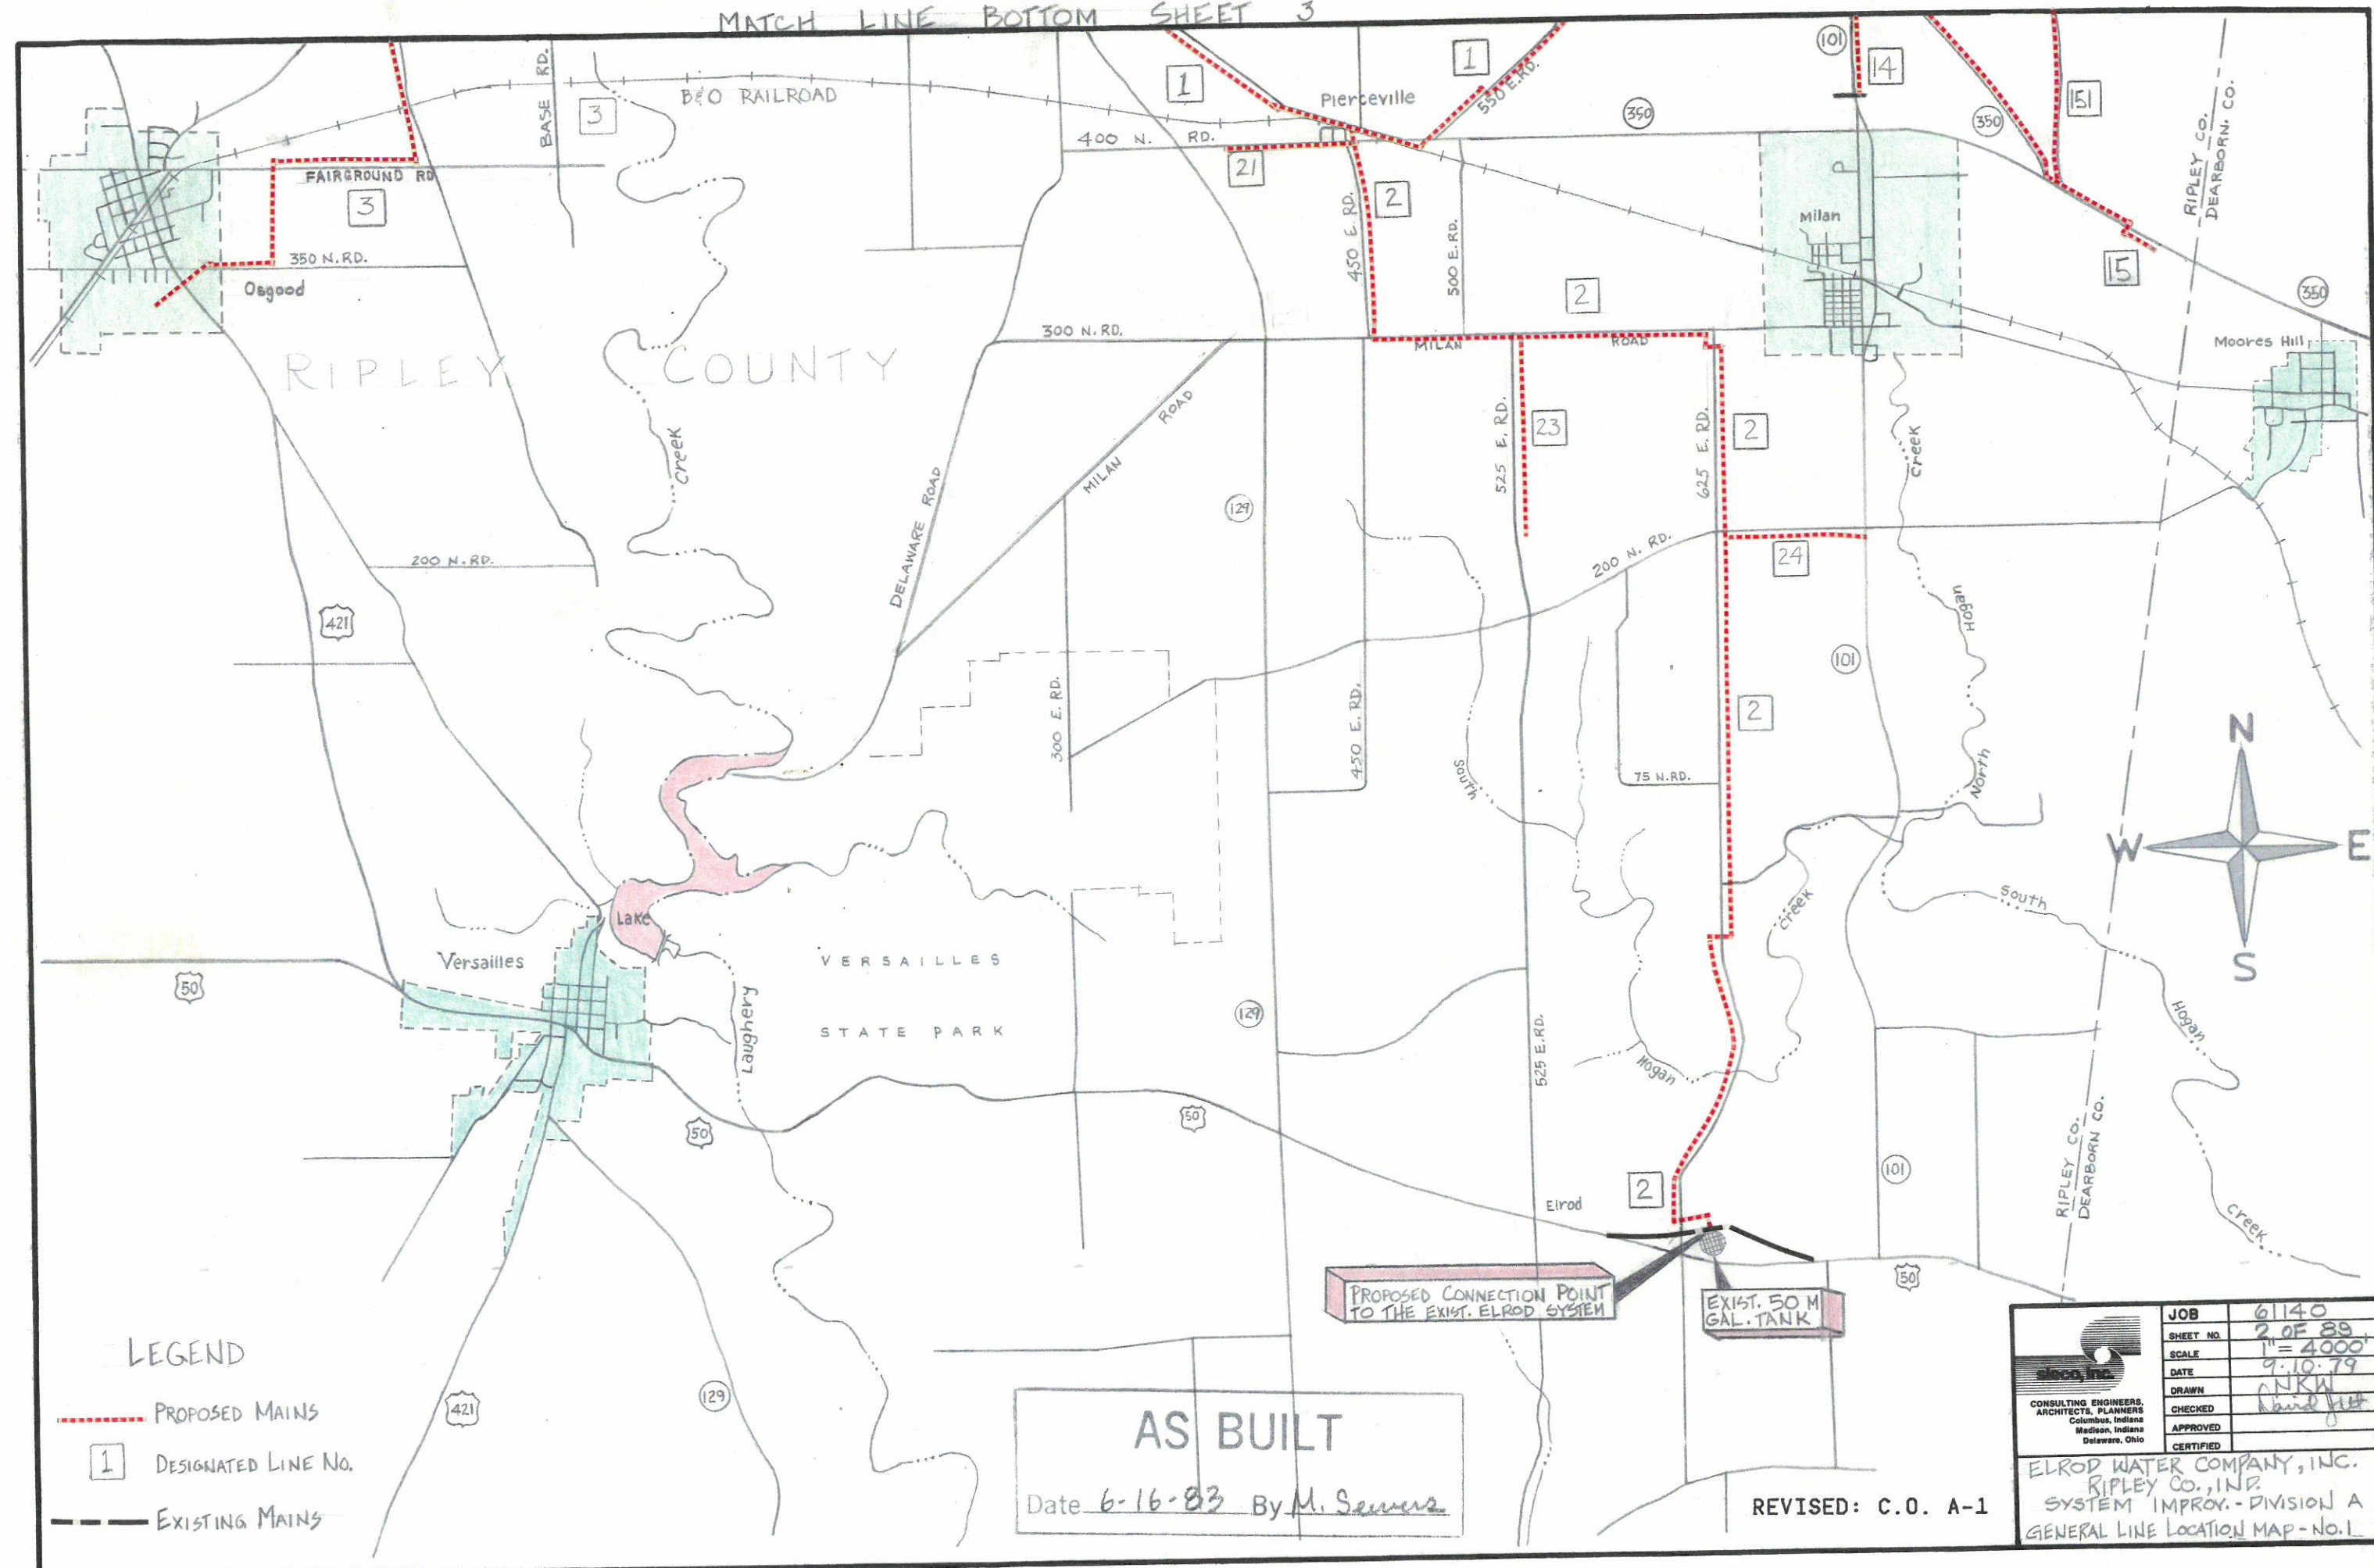


LEGEND

- PROPOSED MAINS
- 1 DESIGNATED LINE NO.
- EXISTING MAINS

AS BUILT
Date 6-16-83 By M. Sewers

REVISED: C.O. A-1

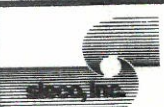 CONSULTING ENGINEERS, ARCHITECTS, PLANNERS Columbus, Indiana Madison, Indiana Delaware, Ohio	JOB	61140
	SHEET NO.	2 OF 89
	SCALE	1" = 4000'
	DATE	9-10-79
	DRAWN	ANKW
	CHECKED	David Hitt
RIPLEY CO. DEARBORN CO.	APPROVED	
	CERTIFIED	
ELROD WATER COMPANY, INC. RIPLEY CO., IND. SYSTEM IMPROV. - DIVISION A GENERAL LINE LOCATION MAP - NO. 1		