
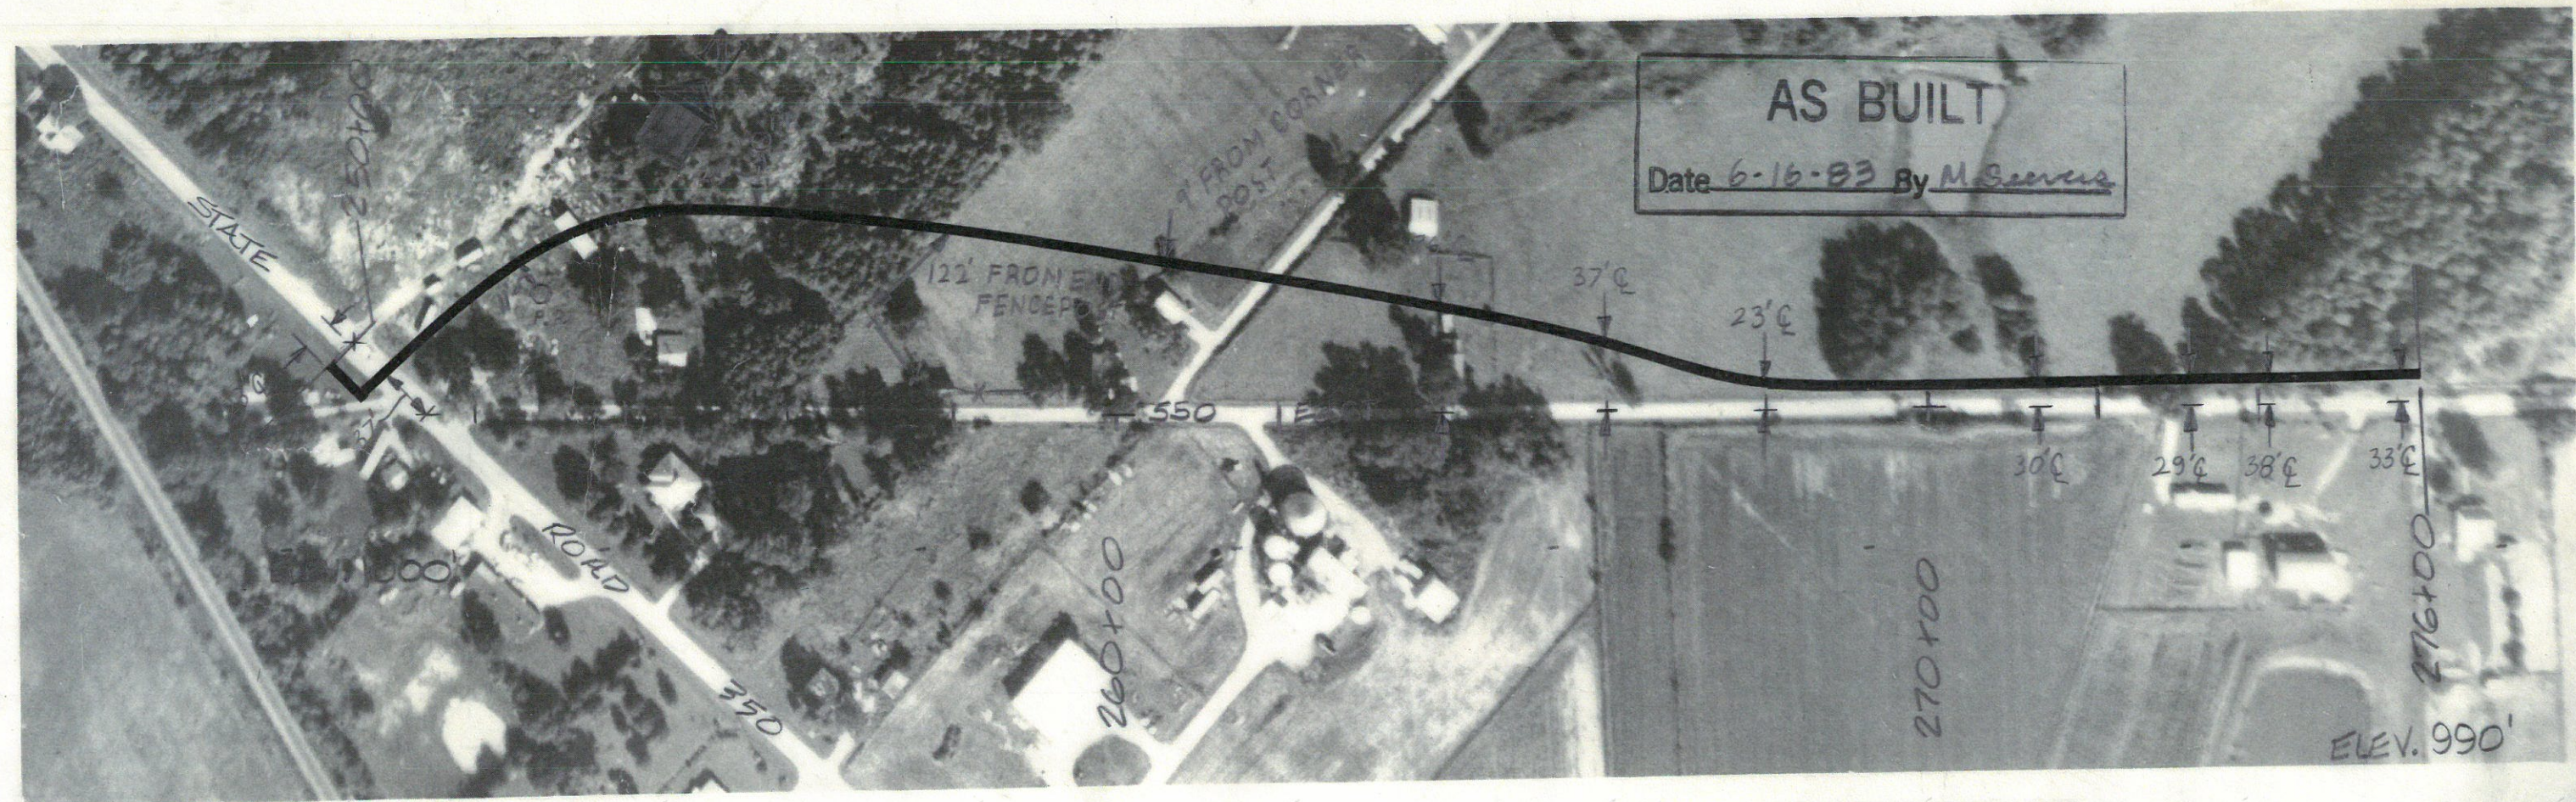


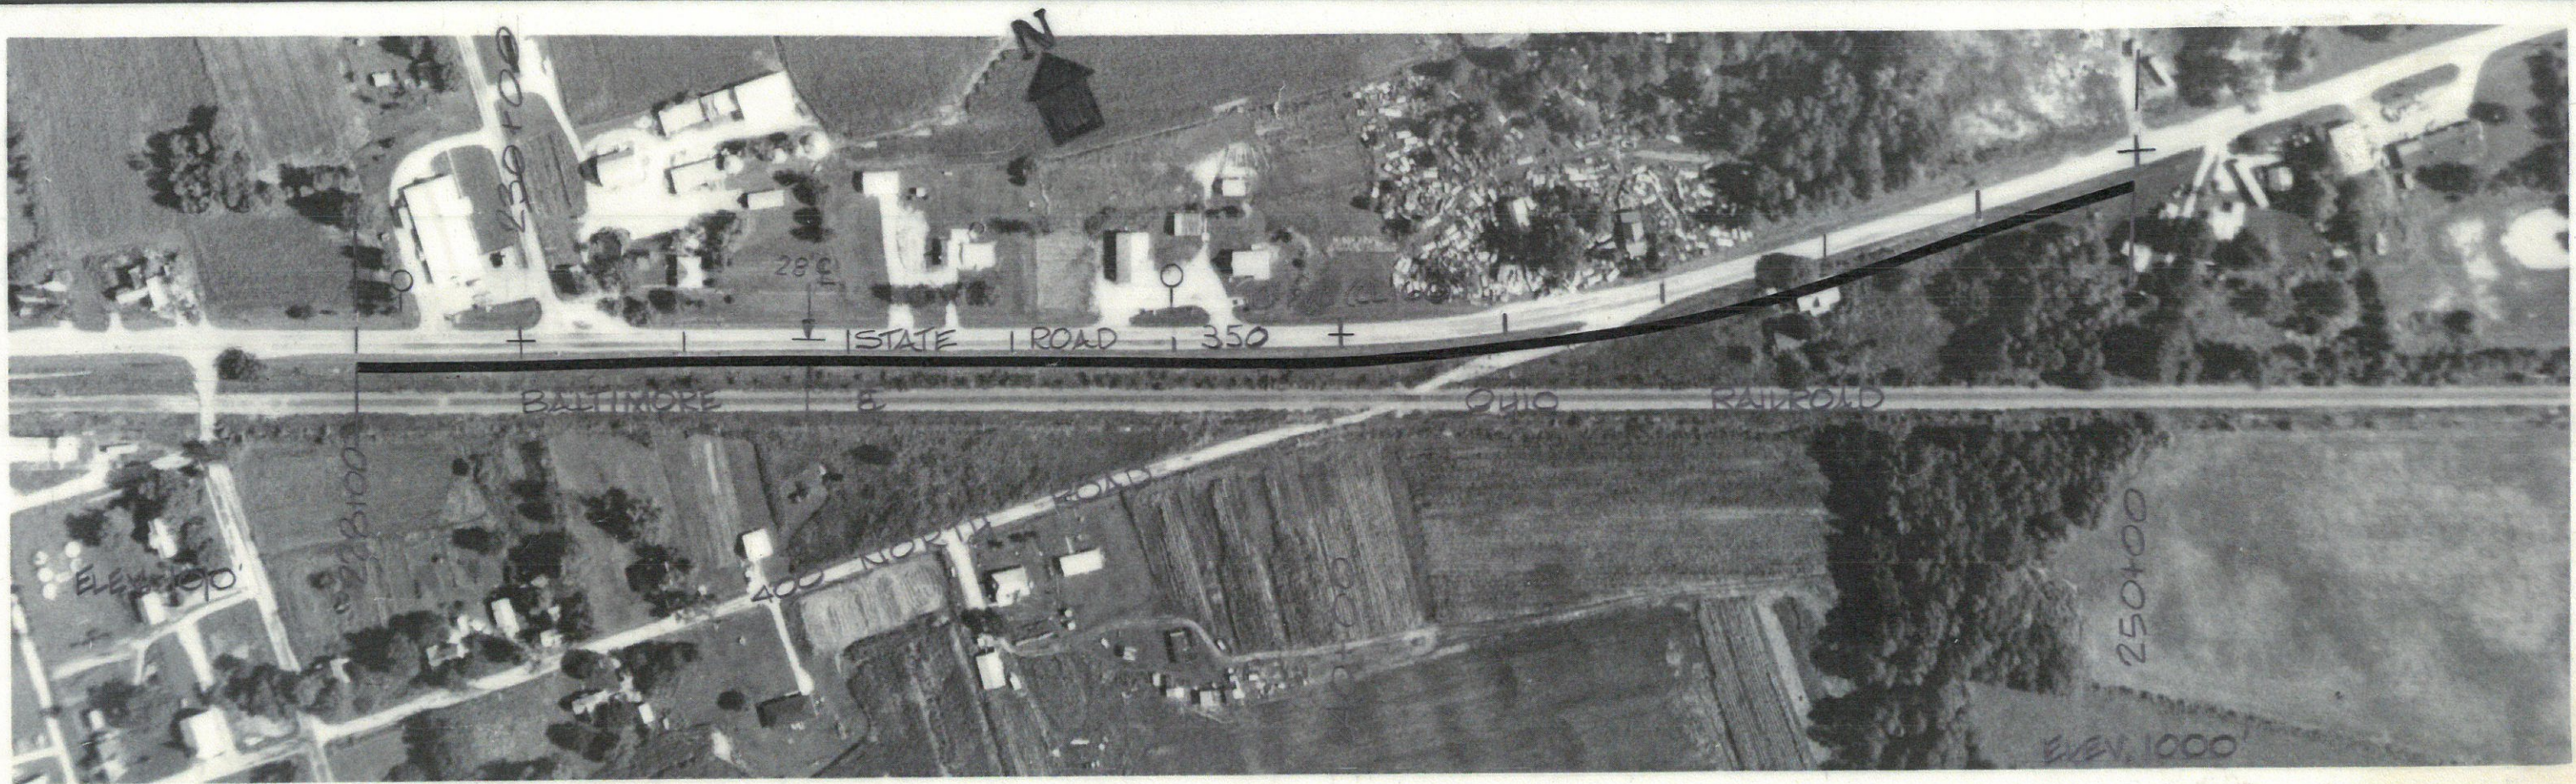

DRAWN BY	WDD	CHECKED BY	<i>[Signature]</i>	SIECO, INC. CONSULTING ENGINEERS, ARCHITECTS, PLANNERS		ELROD WATER CO, INC.		REVISED: C.O. A-1		JOB No.	SHT.
DATE	7-18-79	DATE	1-21-80							61140	10
		CERTIFIED BY						DIVISION: LINE 1		SCALE: 1"=200'	OF 89
		DATE									