
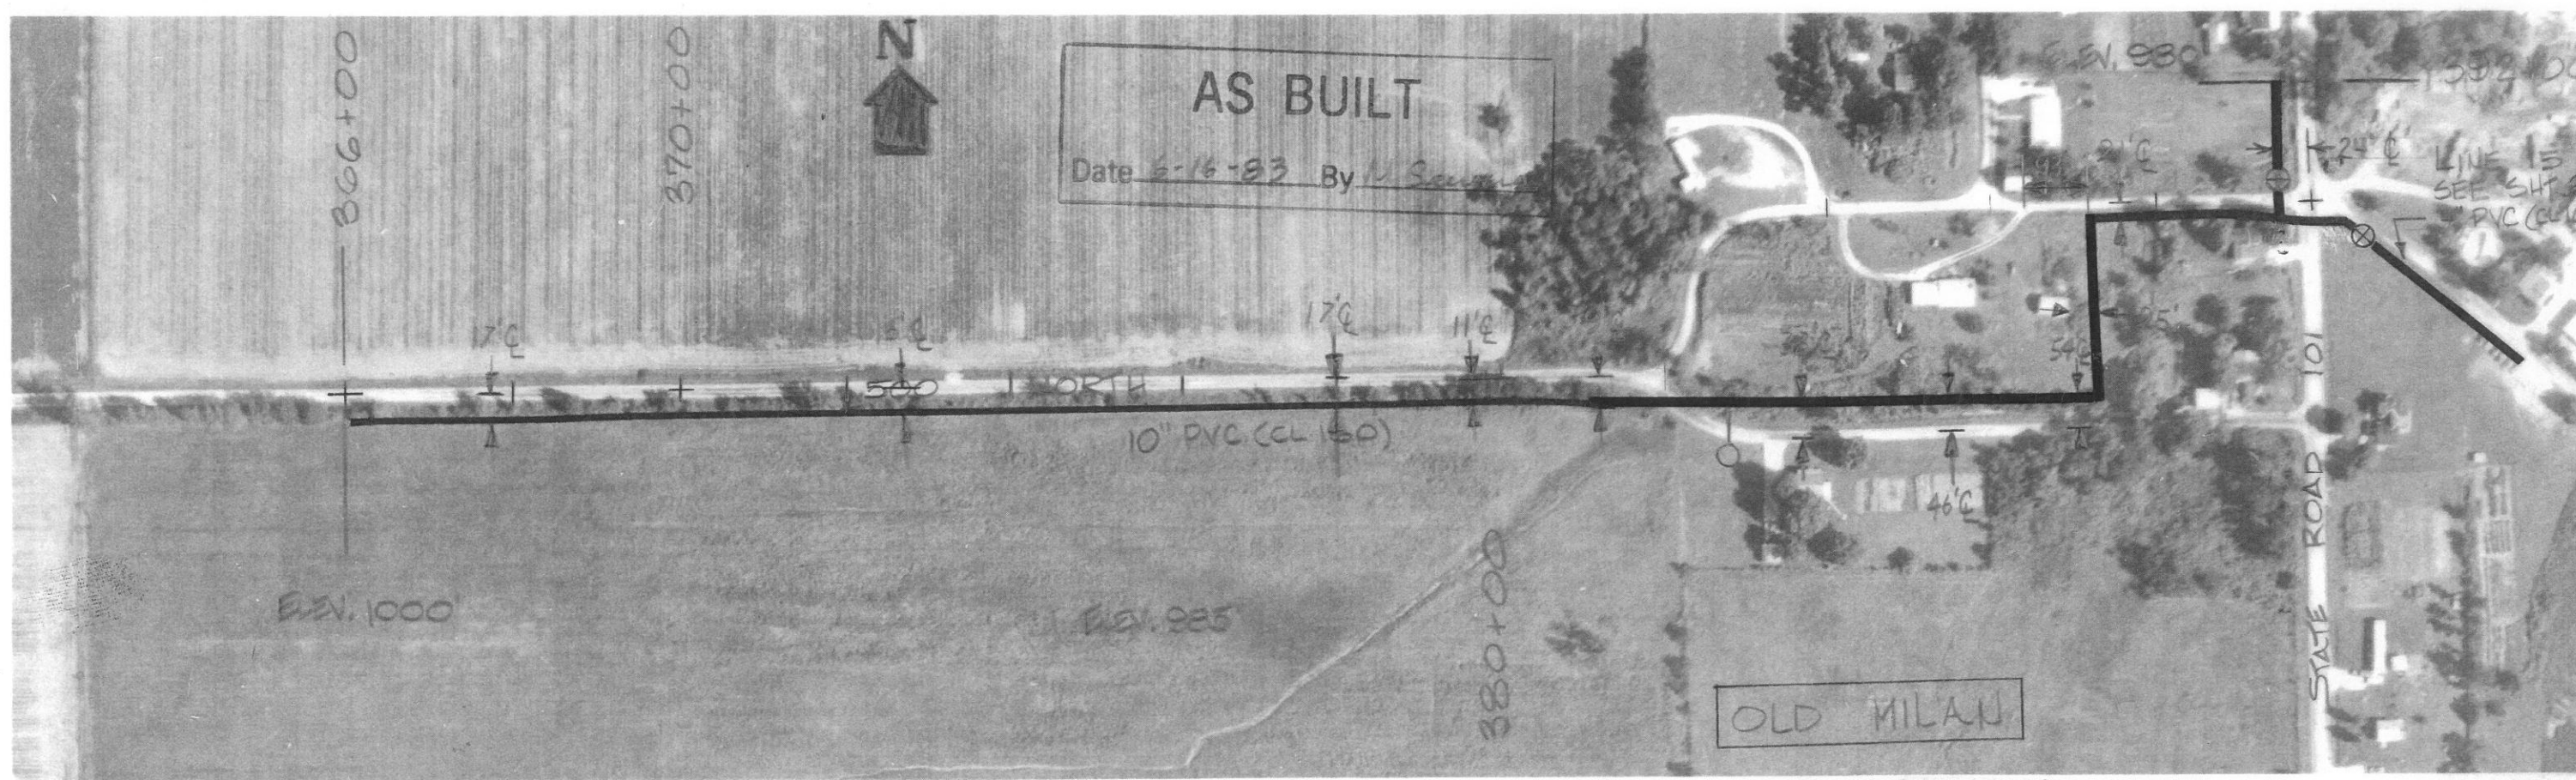


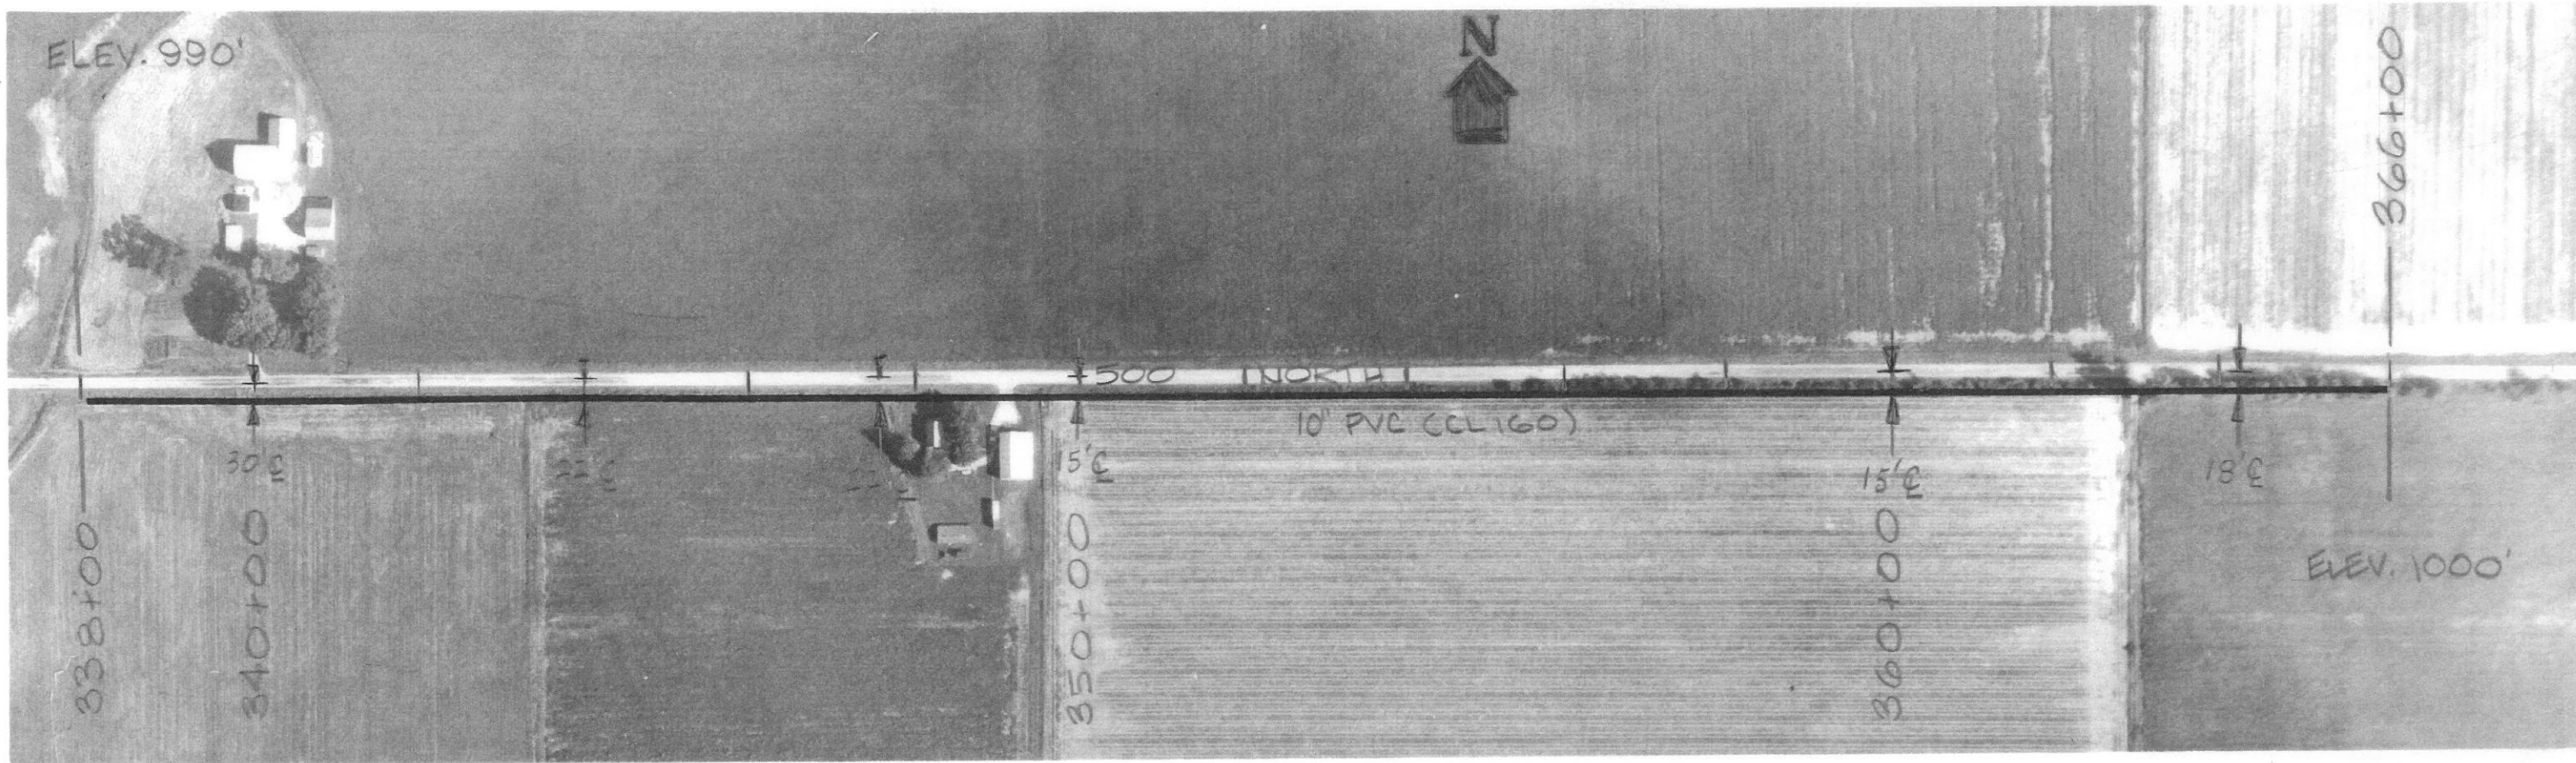

DRAWN BY	W.D.C.	CHECKED BY	David M.B.	SIECO, INC. CONSULTING ENGINEERS, ARCHITECTS, PLANNERS	ELROD WATER CO, INC.	REVISED: C.O. A-1 DIVISION: LINE 1	JOB NO. 61140	SHT. 12
DATE	7.13.79	DATE	1.31.80					
		CERTIFIED BY						
		DATE					SCALE: 1"=200'	OF 89