
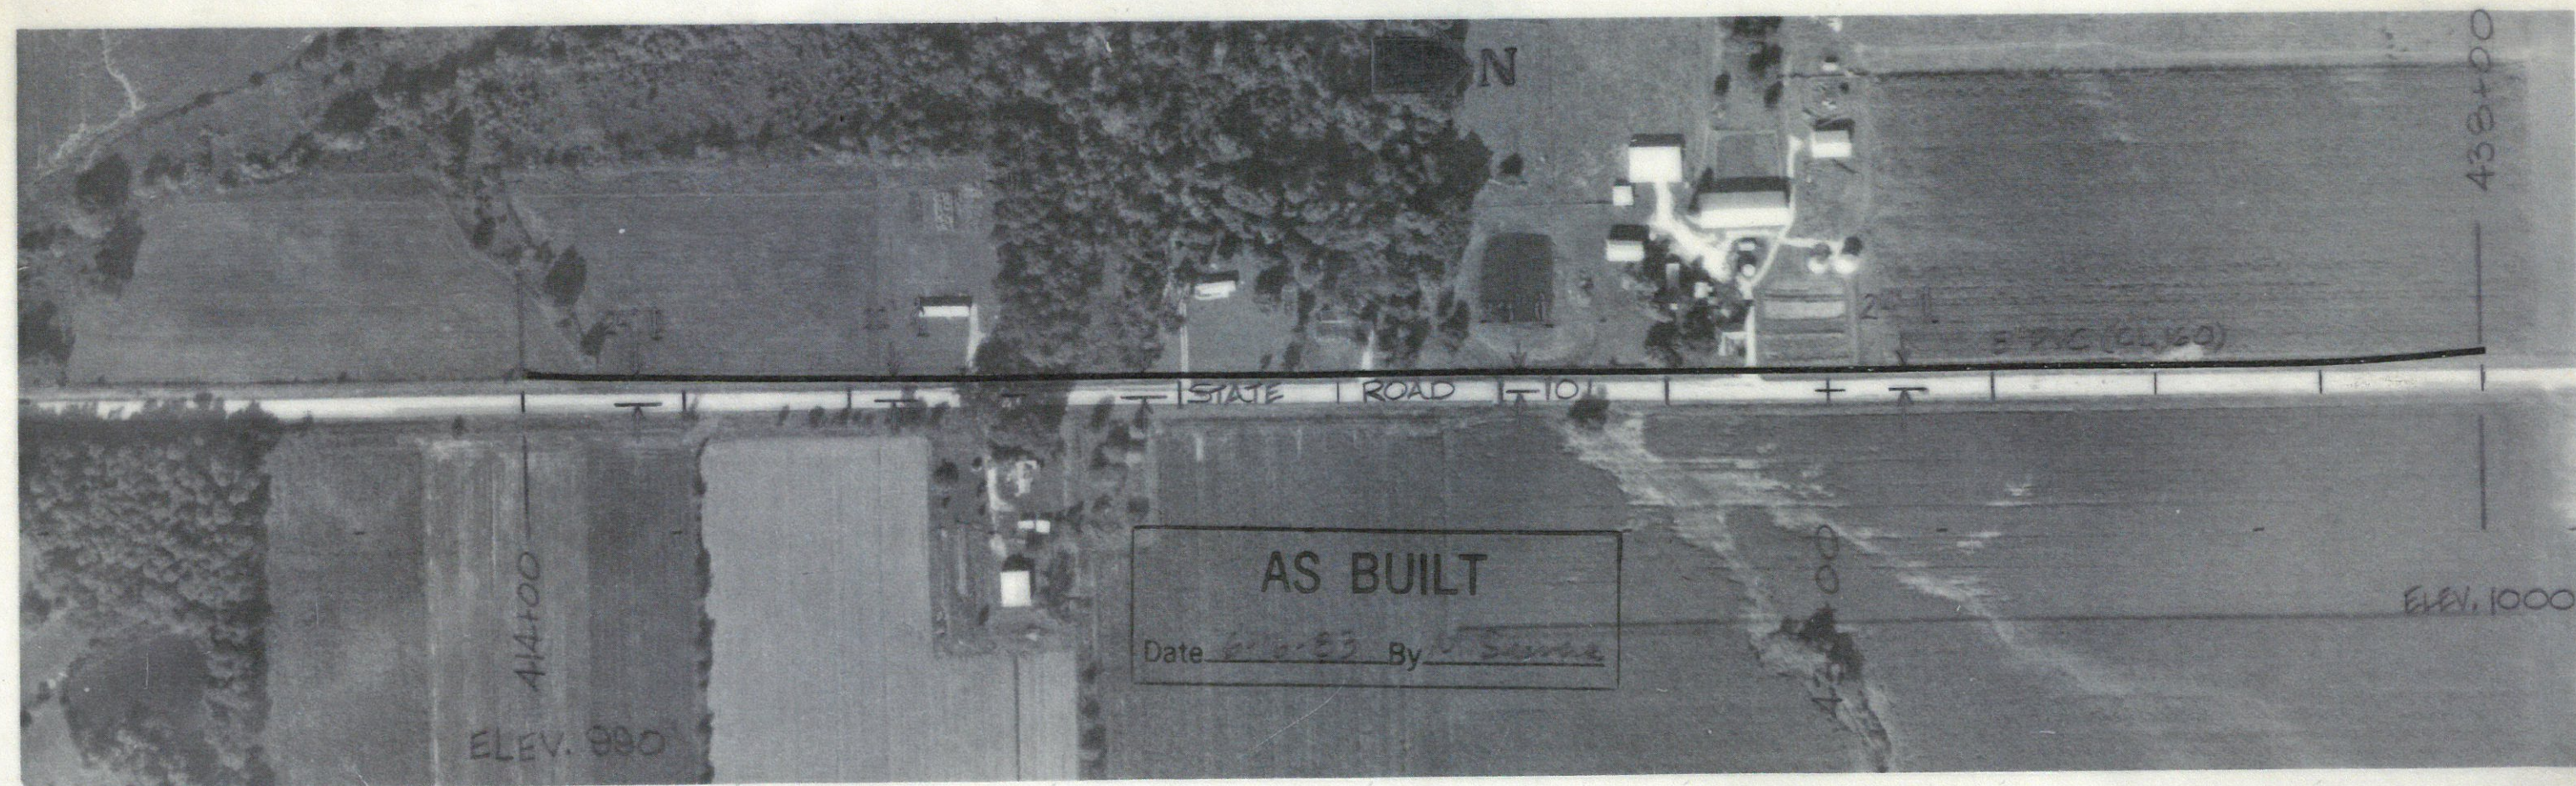


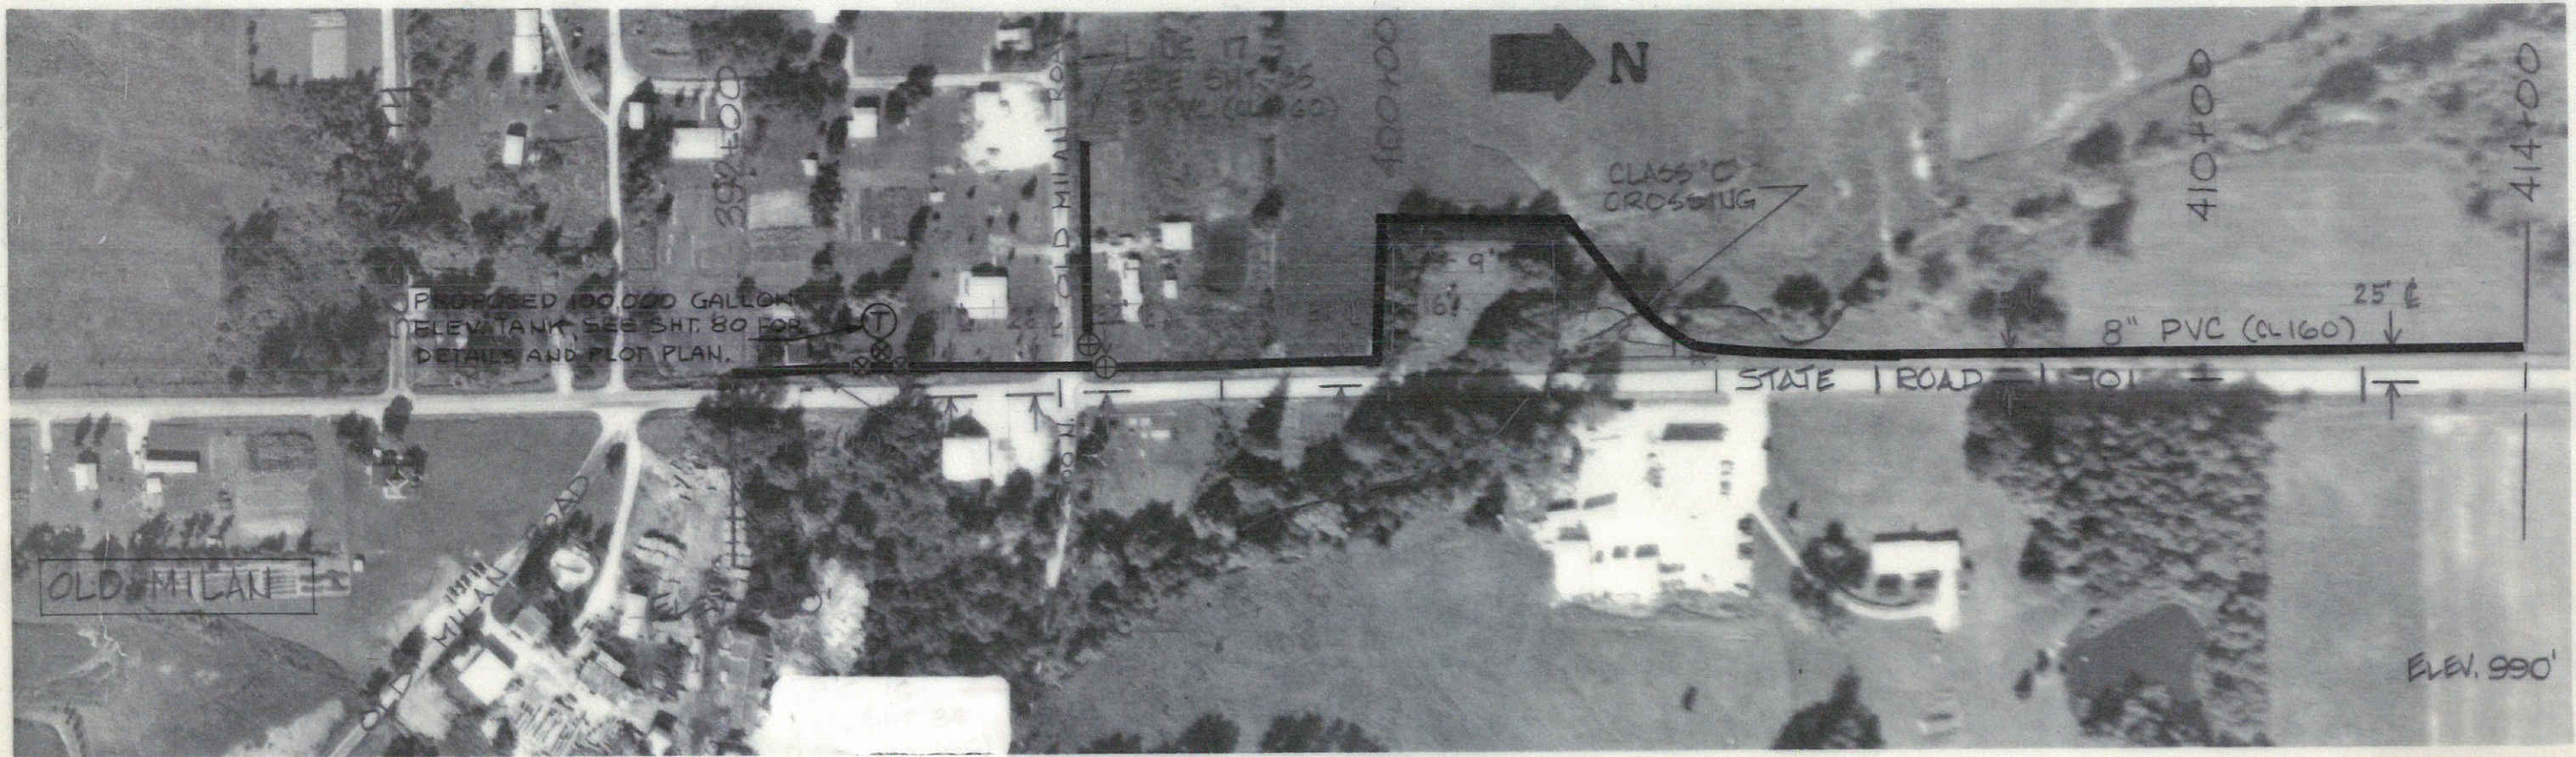

DRAWN BY	WDD	CHECKED BY	David West	SIECO, INC. CONSULTING ENGINEERS, ARCHITECTS, PLANNERS	ELROD WATER CO, INC.	REVISED: C.O. A-1	JOB NO.	SHT.
DATE	7-20-79	DATE	1-81-80			61140	13	
		CERTIFIED BY				SCALE:	OF	
		DATE				1"=200'	89	
DIVISION: LINE 1								