
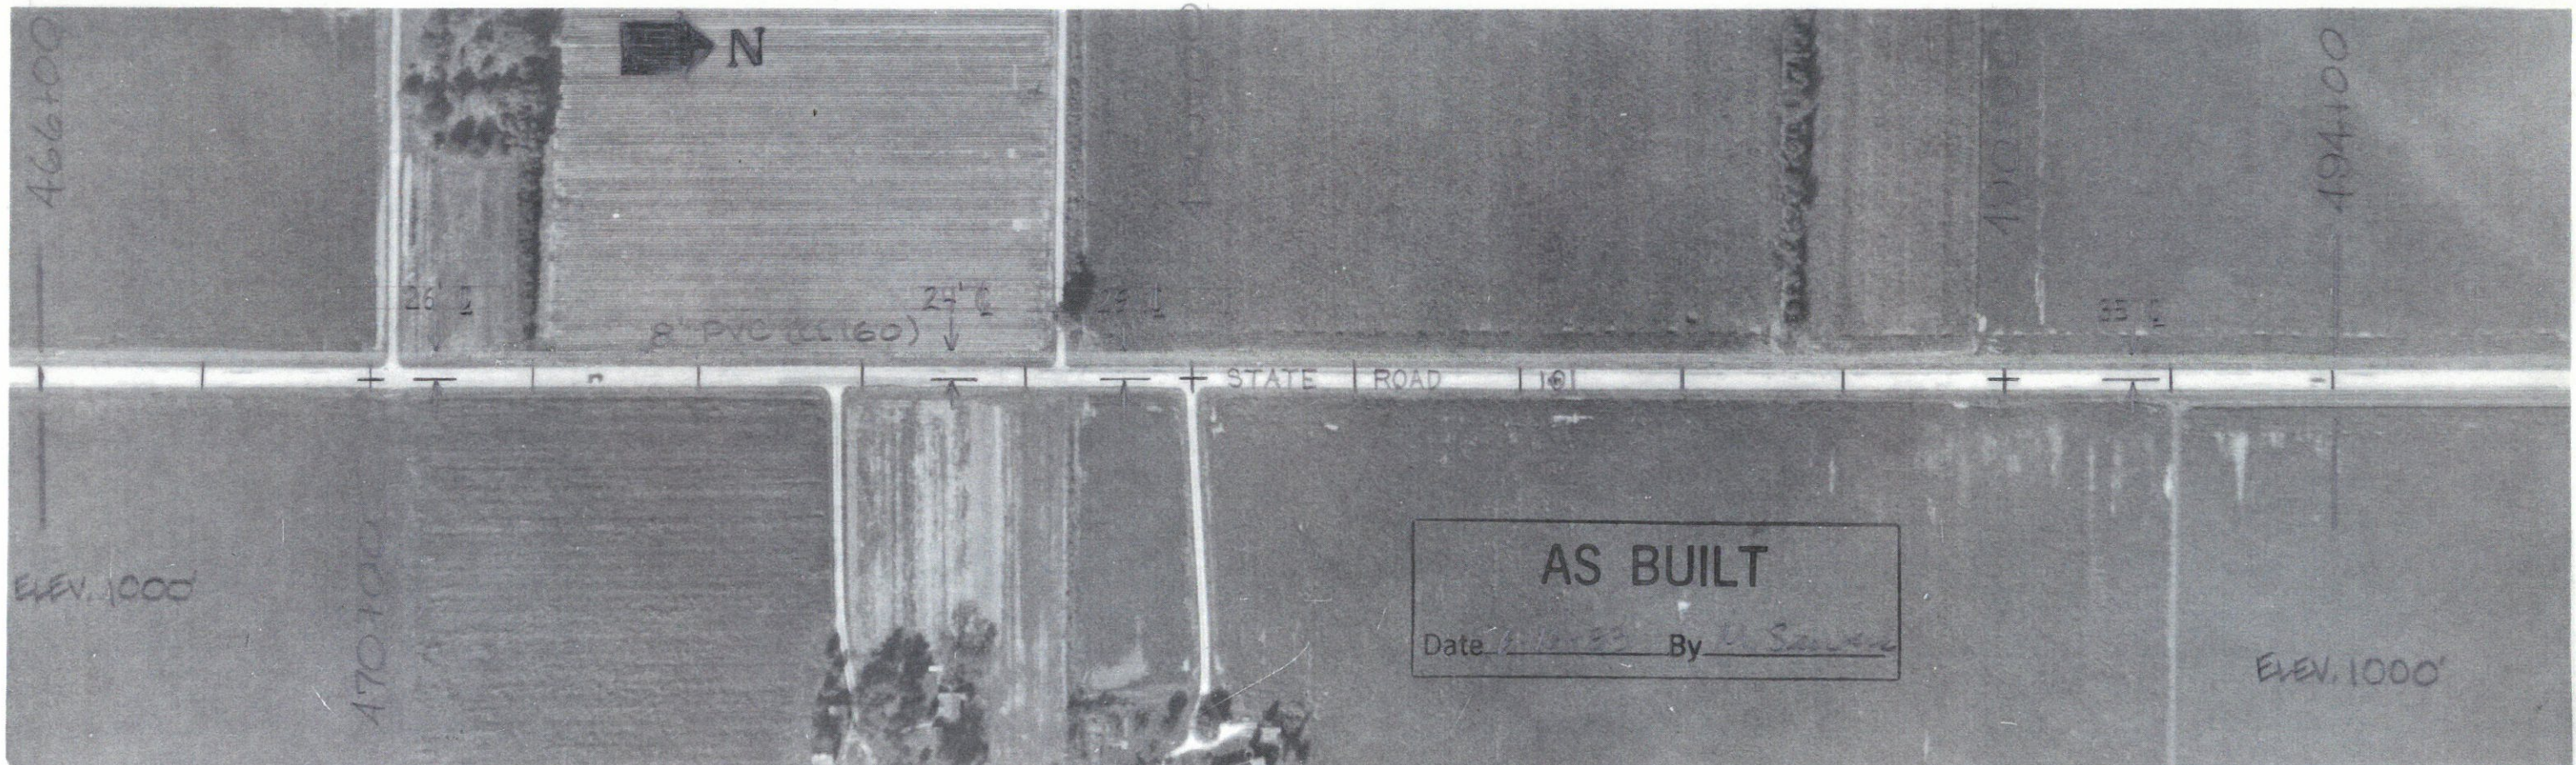


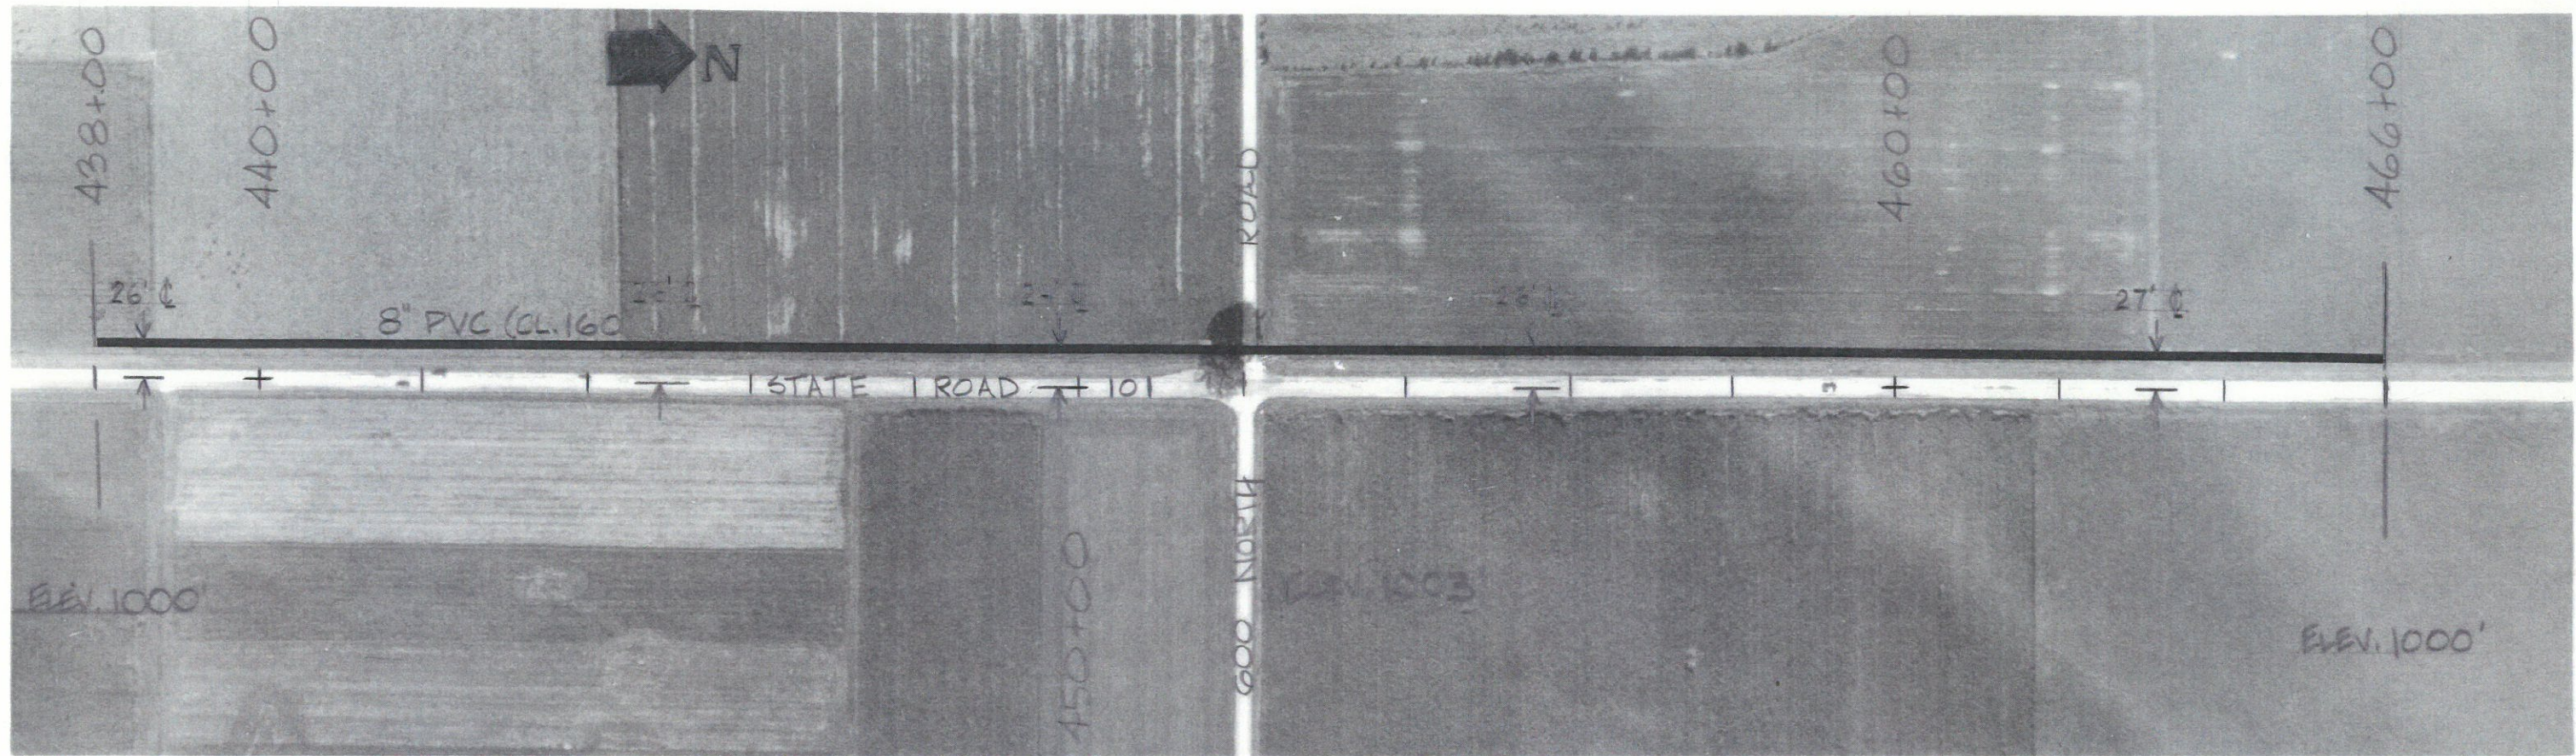

**AS BUILT**  
 Date 7-16-83 By C. Sauer

|          |         |              |             |
|----------|---------|--------------|-------------|
| DRAWN BY | WDC     | CHECKED BY   | David H. H. |
| DATE     | 7-20-79 | DATE         | 1-21-80     |
|          |         | CERTIFIED BY |             |
|          |         | DATE         |             |

**SIECO, INC.**  
 CONSULTING ENGINEERS,  
 ARCHITECTS, PLANNERS

**ELROD WATER CO, INC.**

REVISED: C.O. A-1

DIVISION: LINE 1

|         |         |      |    |
|---------|---------|------|----|
| JOB NO. | 61140   | SHT. | 14 |
| SCALE   | 1"=200' | OF   | 89 |