
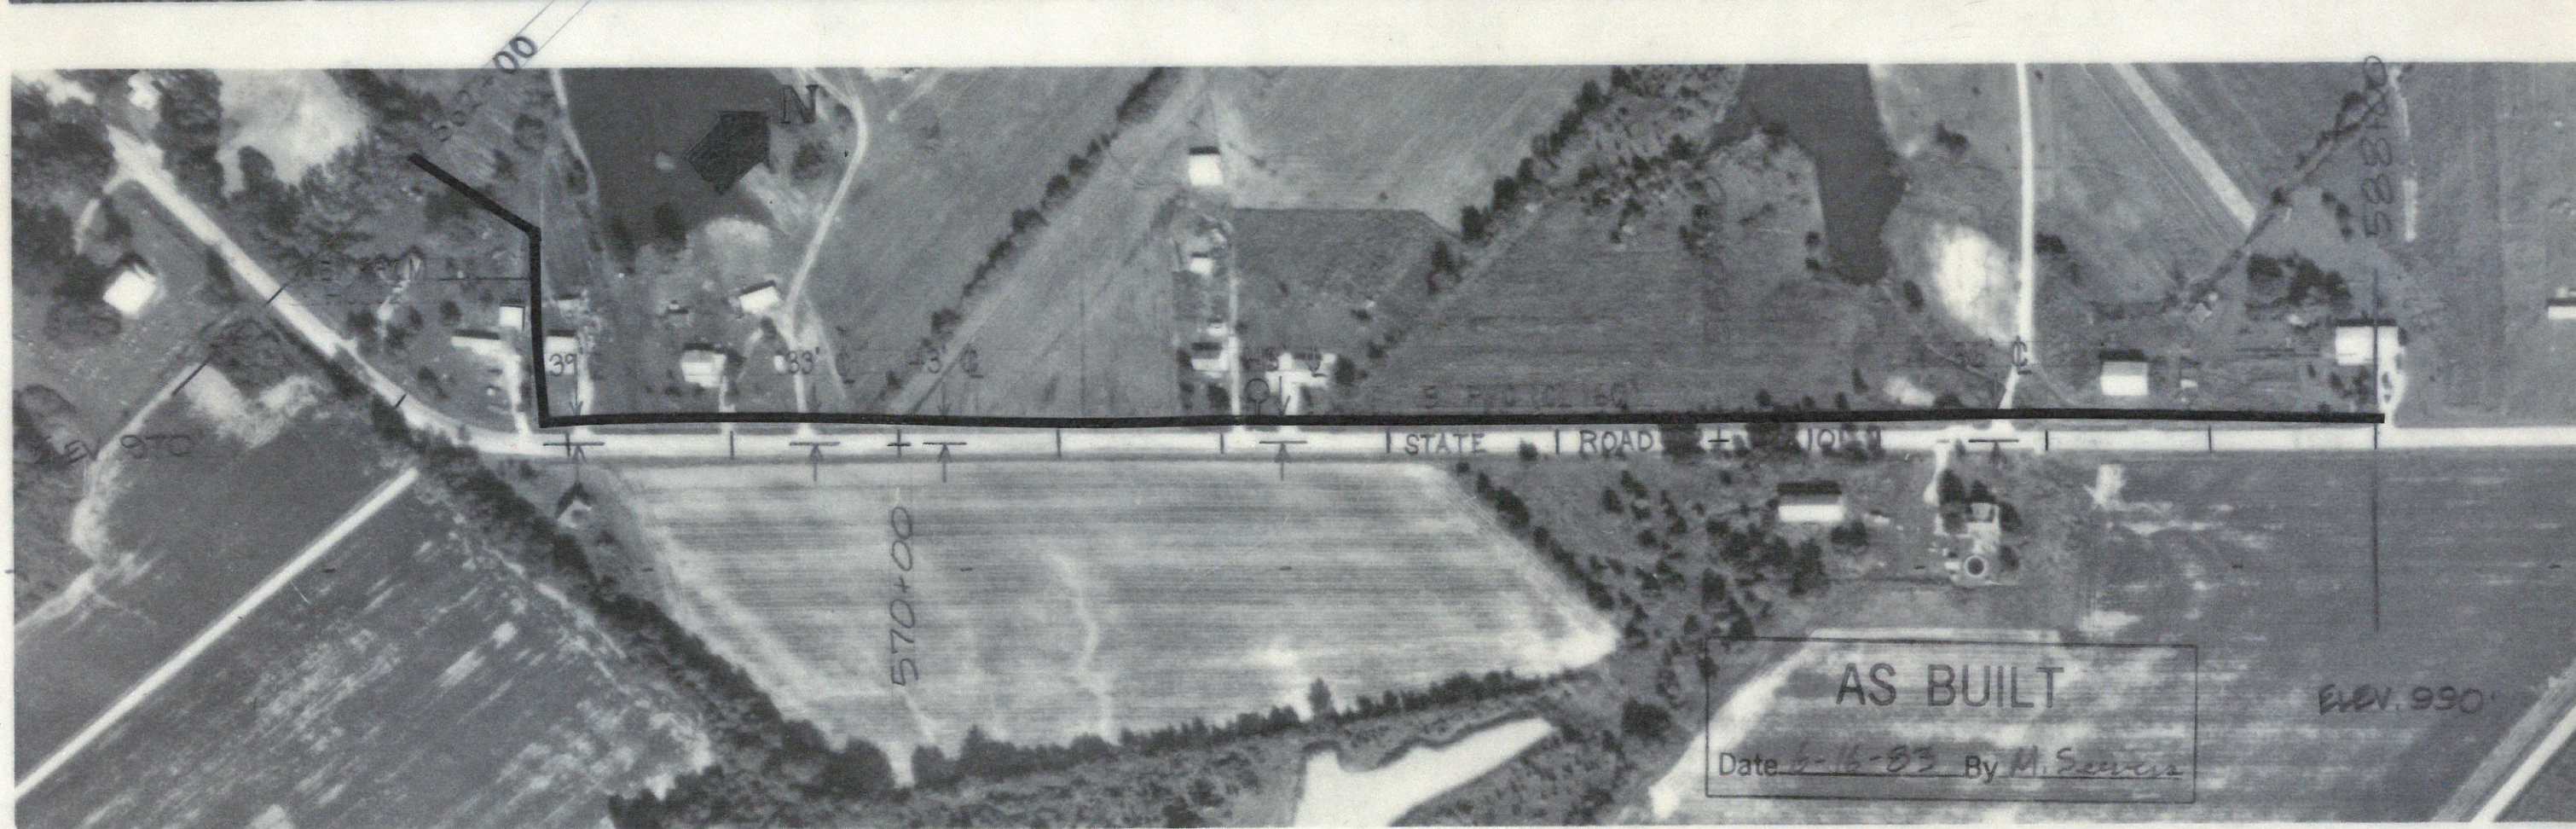


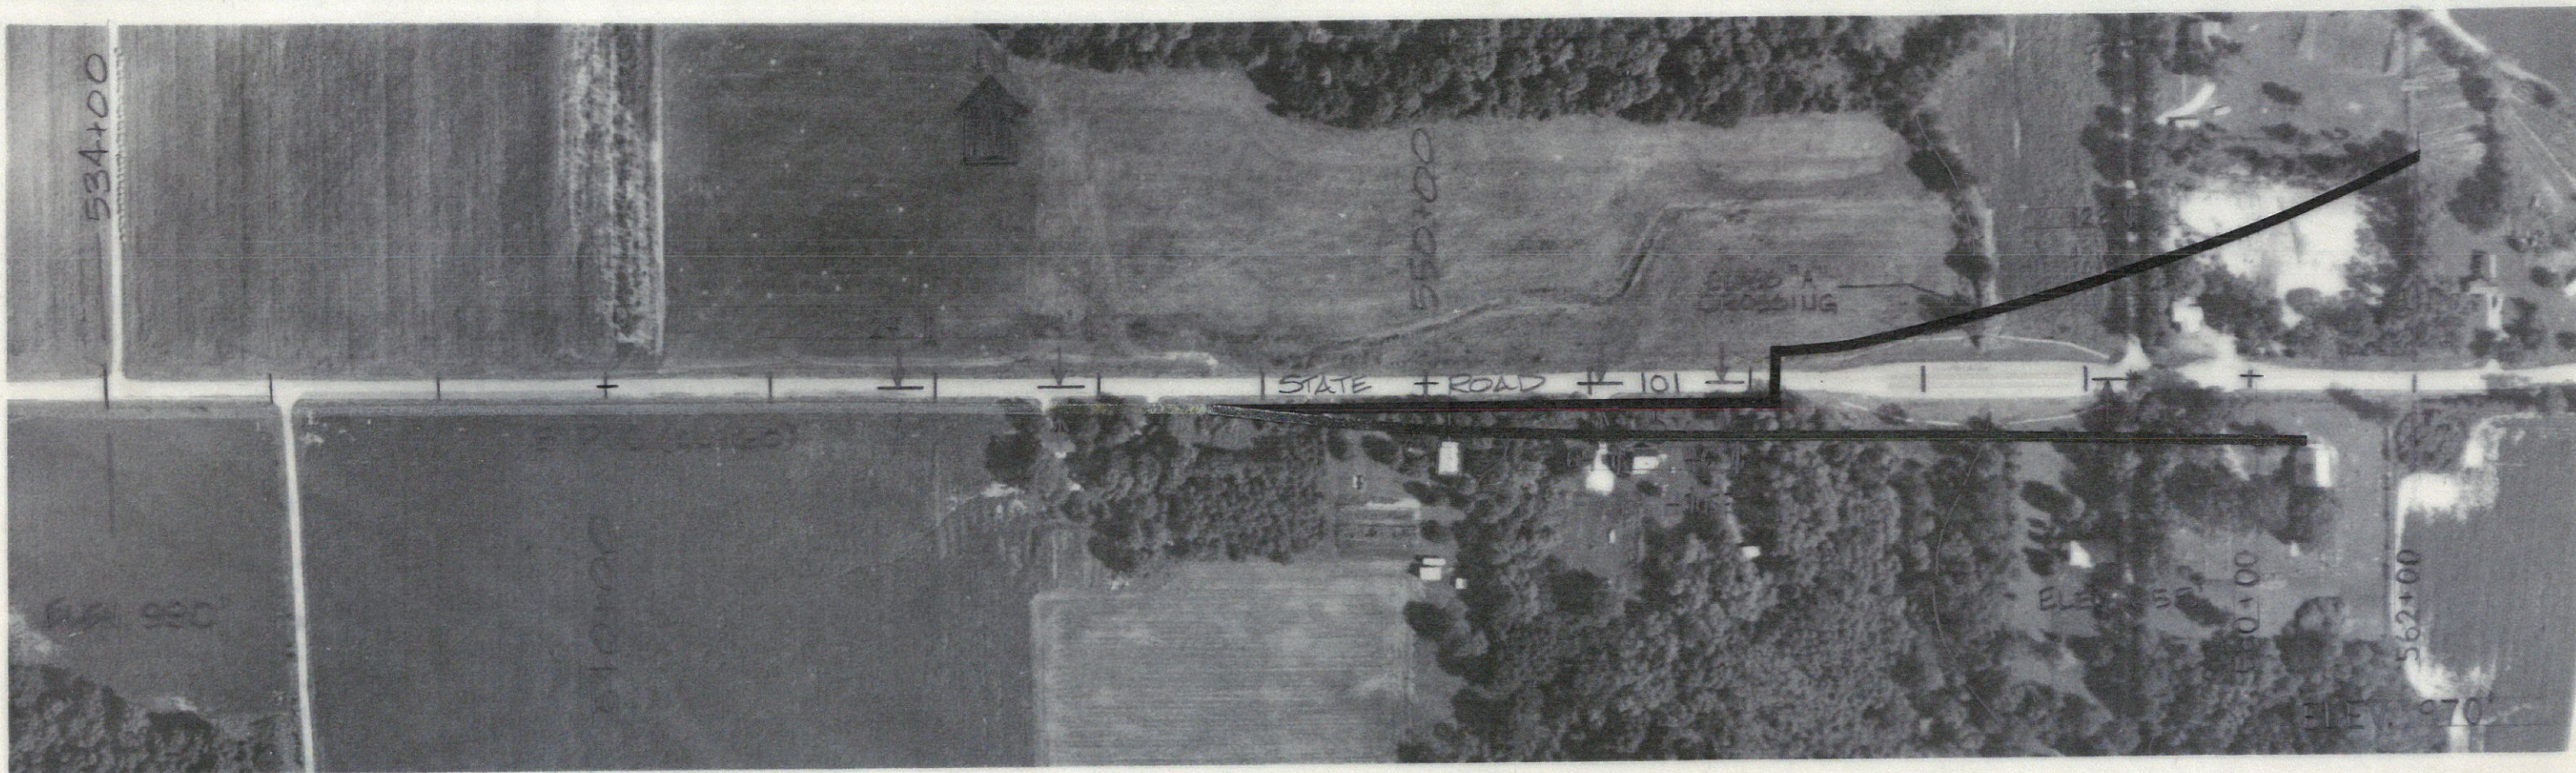

AS BUILT
Date 6-16-83 By M. Sevens

DRAWN BY	WDD	CHECKED BY	David M. H.
DATE	7.20.79	DATE	1.31.80
		CERTIFIED BY	
		DATE	

SIECO, INC.
CONSULTING ENGINEERS,
ARCHITECTS, PLANNERS

ELROD WATER CO, INC.

REVISED: C.O. A-1
DIVISION: LINE 1

JOB NO. 61140
SCALE: 1"=200'
SHT. 16 OF 89