
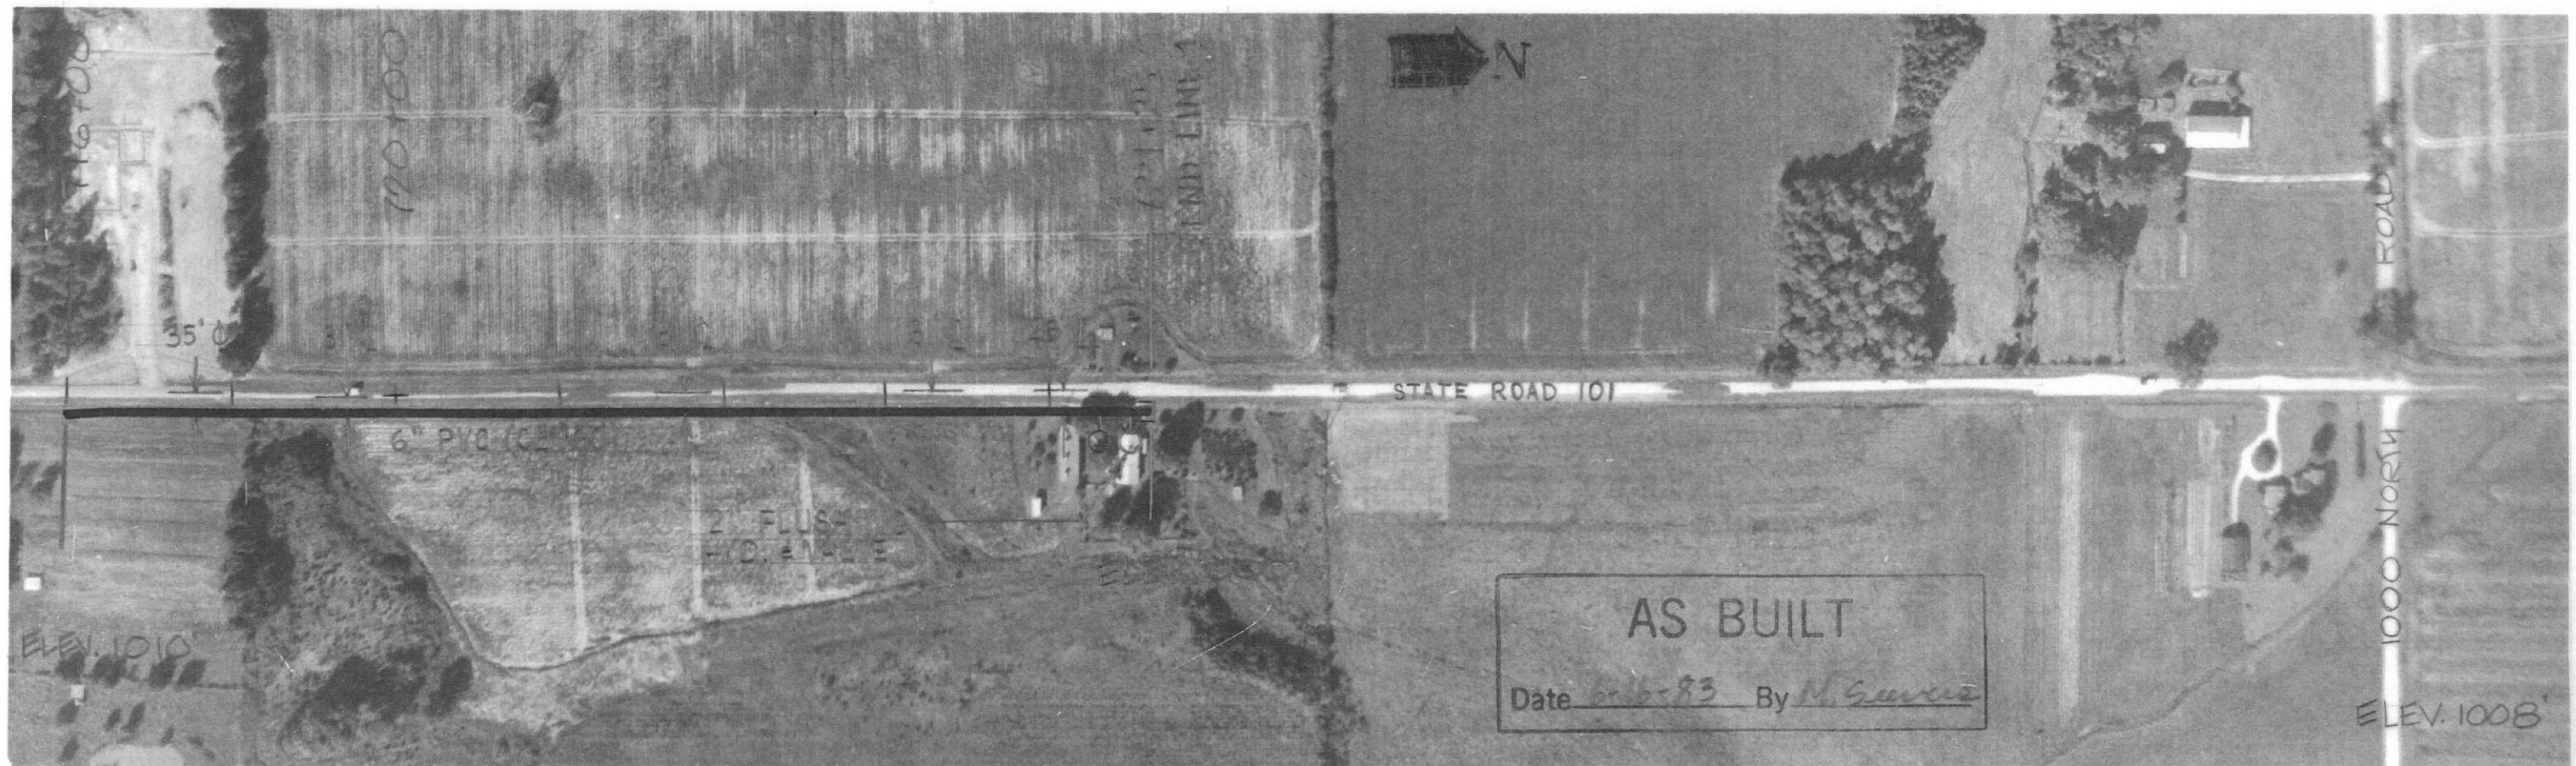


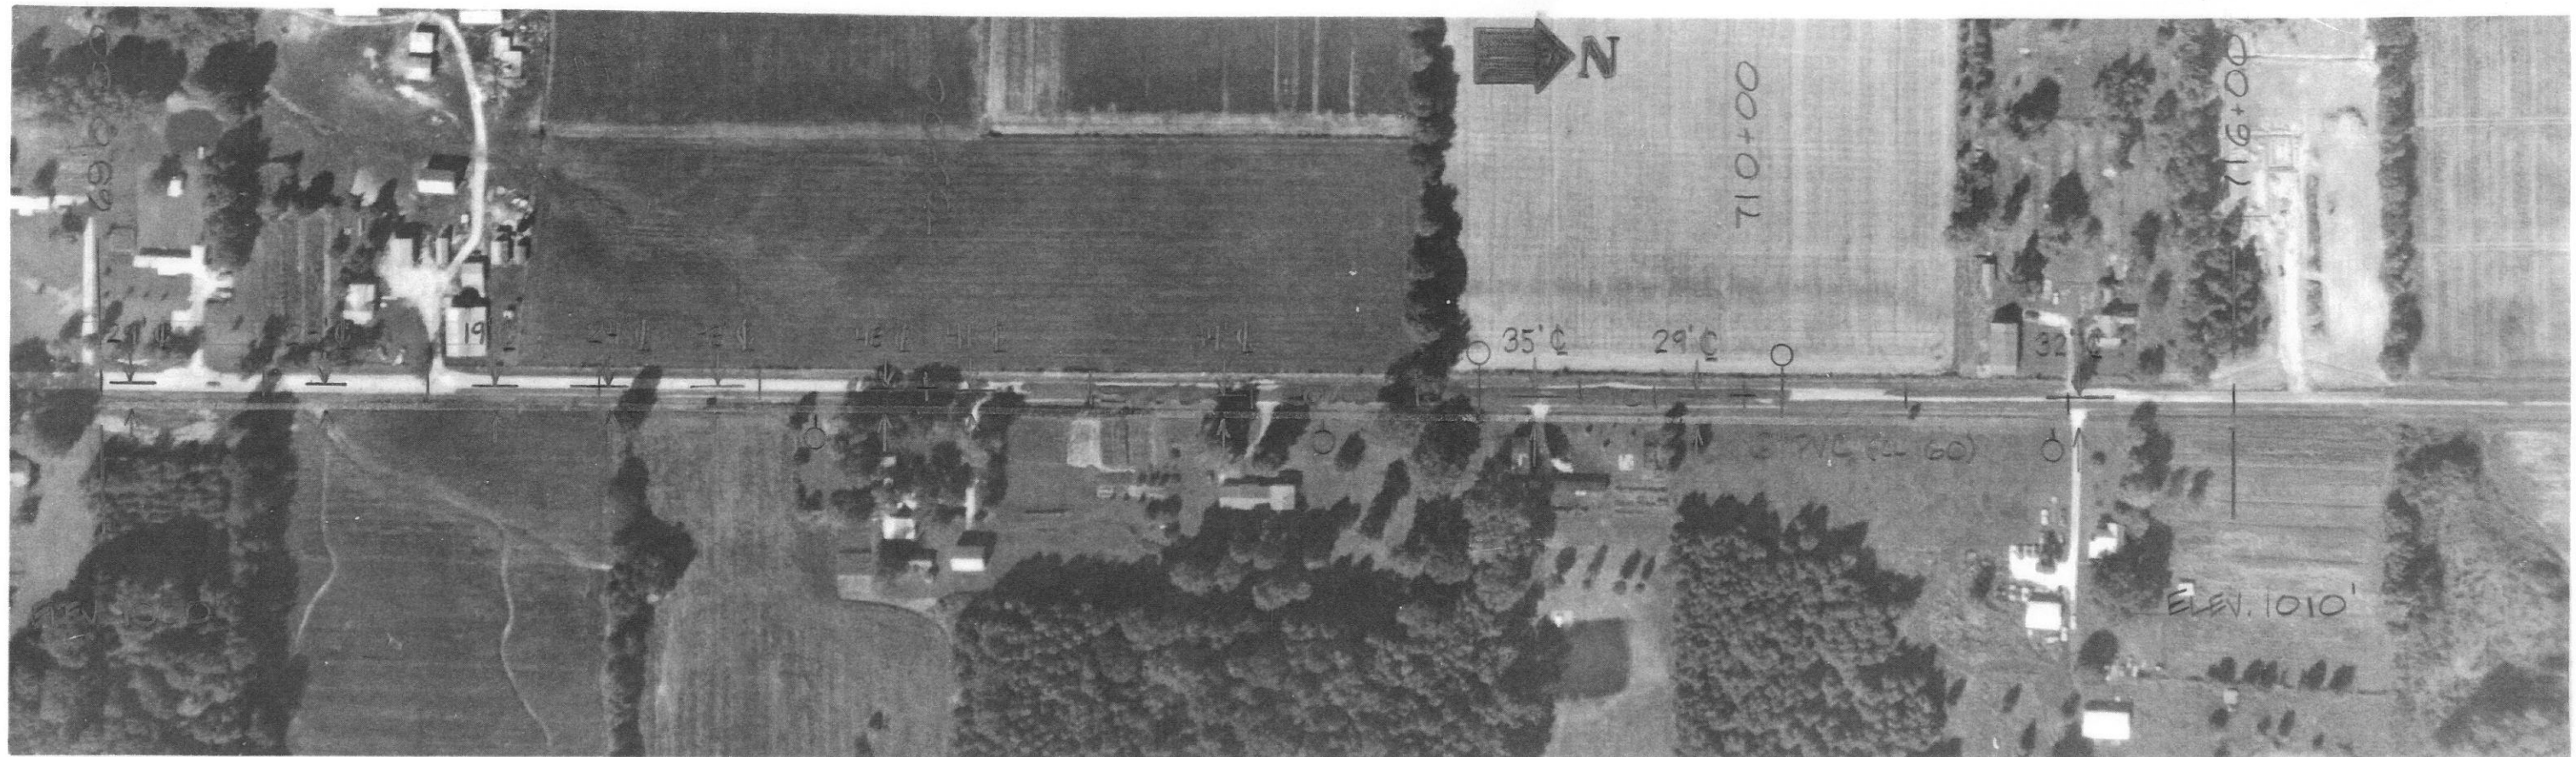

AS BUILT
 Date 6-6-83 By M. Sauer

DRAWN BY WDD	CHECKED BY David D. [Signature]	SIECO, INC. CONSULTING ENGINEERS, ARCHITECTS, PLANNERS	ELROD WATER CO, INC.	DIVISION: <u>LINE 1</u>	JOB NO. <u>61140</u> SCALE: 1"=200'	SHT. <u>19</u> OF <u>89</u>
DATE 7-23-78	DATE 1-21-80					
	CERTIFIED BY DATE					