


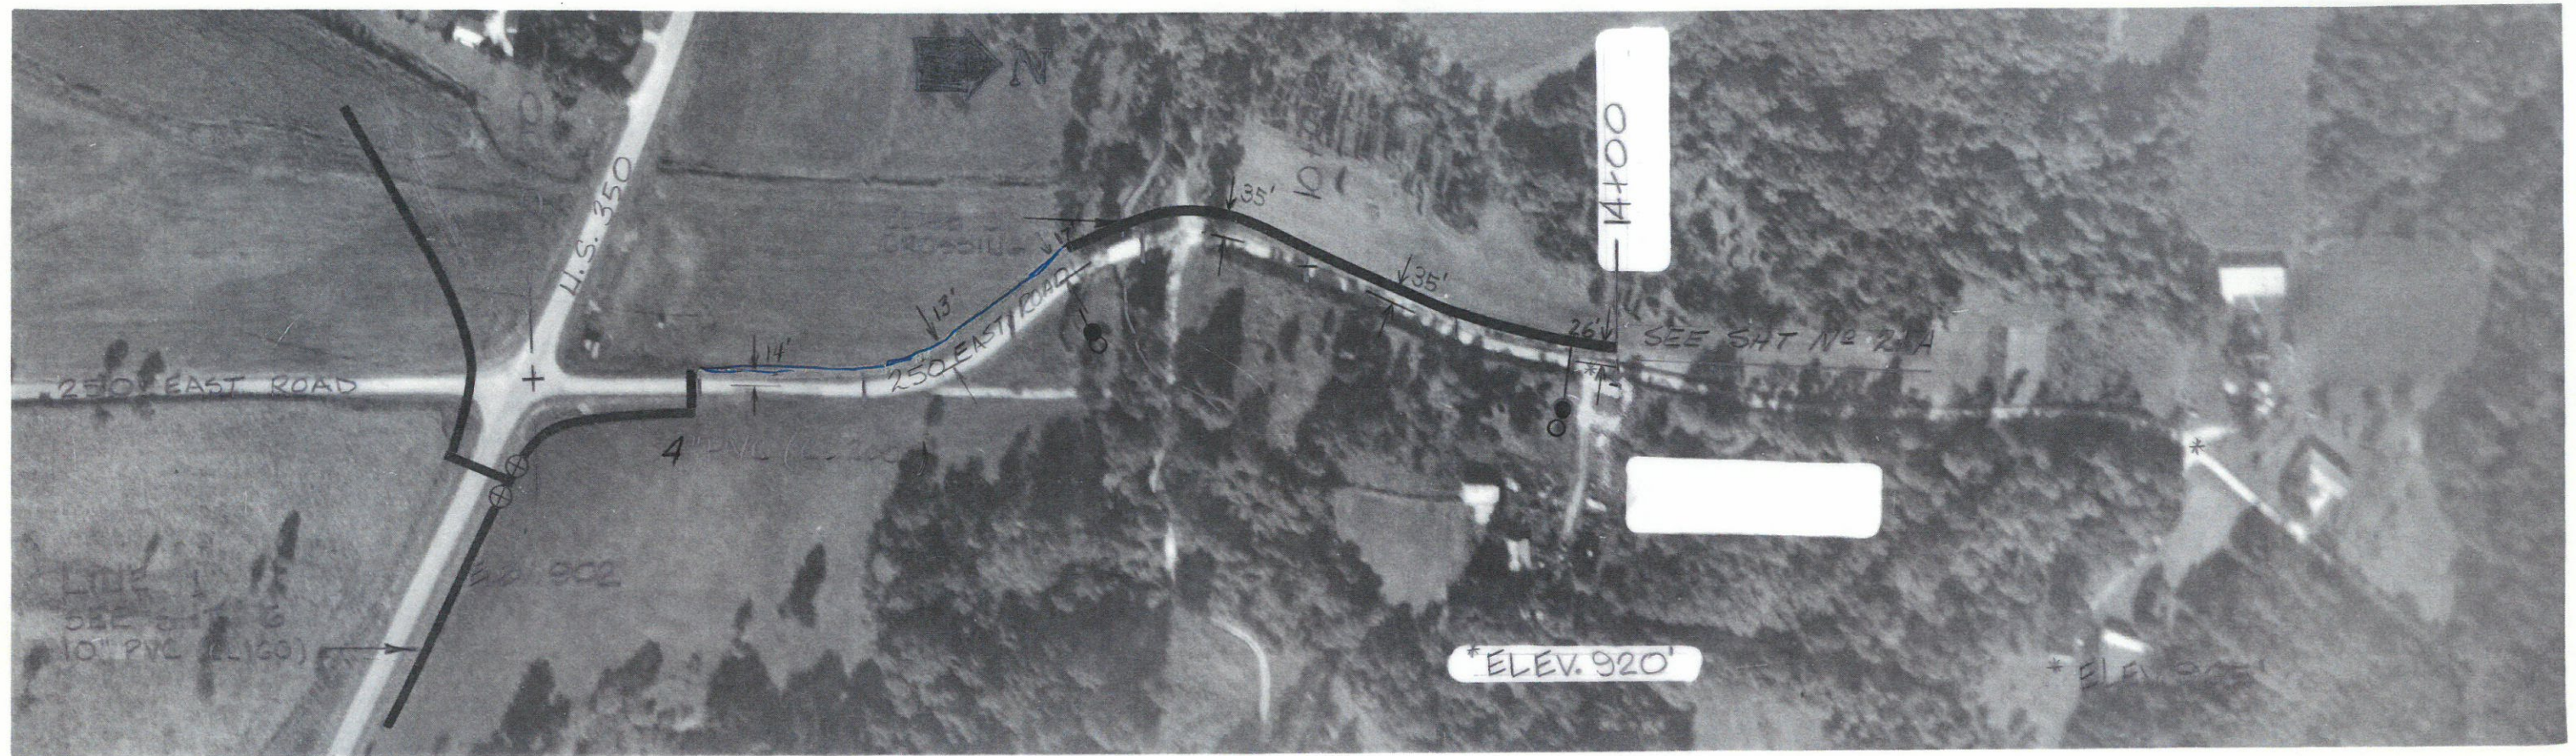

AS BUILT
 Date 6-16-83 By M. Sevens

DRAWN BY	WDJ	CHECKED BY	<i>David H. H.</i>	SIECO, INC. CONSULTING ENGINEERS, ARCHITECTS, PLANNERS	ELROD WATER CO, INC.	REVISED: C.O. A-1 C.O. A-2 8/25/82 <i>gm</i>	JOB NO. 61140	SHT. 21
DATE	7-23-79	DATE	1-21-80					
		CERTIFIED BY				DIVISION: <u>LIVE 12</u>	SCALE: 1"=200'	OF 89
		DATE						